



BURNSIDE

[THE DIFFERENCE IS OUR PEOPLE]

Appendix C

Monitoring Well and Soil Logs

Summary of Landfill Monitoring Wells and Boreholes	C1
Landfill Monitoring Well Logs	C2
Landfill Boreholes Logs	C3
Landfill Test Pit Logs	C4
St. Marys Cement Wells and Boreholes	C5
Grain-Size Graphs	C6
Sand Isopach (CRA 1992 Figure 5.1)	C7

Appendix C1

Summary of Landfill Monitoring Wells & Boreholes

St. Marys Landfill

Monitoring Well	Date of Installation	Screened Stratigraphy	Top of Casing (m ags)	Depth Below Ground Surface							Well Status
				Borehole Depth	Well Screen		Sand Pack		Bentonite Seal		
					Bottom	Top	Bottom	Top	Bottom	Top	
OW1-80	27-May-80	Clayey Silt Till	0.93	7.60	6.90	6.30	7.60	6.00	6.00	5.80	Decom
OW2-80	27-May-80	Clayey Silt Till		6.40	5.80	5.20	6.40	4.80	4.80	4.60	Decom
OW3-80	27-May-80	Clayey Silt Till	1.13	4.60	4.20	3.60	4.60	3.00	3.00	2.80	Decom
OW4-80	27-May-80	Clayey Silt Till	1.03	10.50	9.80	9.20	10.50	9.00	9.00	8.80	Decom
OW1-84	25-Sep-84	Sandy Clayey Silt Till w Gravel	0.61	9.60	8.38	7.62	9.60	6.50	6.50	5.87	Decom
OW2-84	25-Sep-84	Sand and Gravel	0.65	9.60	9.53	8.77	9.60	8.08	8.08	7.10	WL / S
OW3-84	24-Sep-84	Sand with Gravel	0.46	13.87	13.87	13.11	13.87	11.05	11.05	10.36	WL
OW4-84	24-Sep-84	Silty Sand / Clayey Silt	0.84	13.87	3.05	2.29	3.05	1.83	1.83	1.45	WL / S
OW5-84	25-Sep-84	Sand with Gravel	0.49	14.78	14.78	14.02	14.78	11.73	11.73	11.28	WL / S
OW6-84	25-Sep-84	Silt / Clayey Silt Till	0.86	14.78	3.20	2.44	3.20	2.18	2.18	1.98	WL
OW7-91	4-Oct-91	Limestone	0.77	39.22	39.01	37.49	39.22	33.83	33.83	0.50	WL / S
OW8A-91	3-Oct-91	Limestone	0.86	32.36	32.11	30.58	32.11	26.36	26.36	0.60	WL / S
OW8B-10	25-Oct-10	Clay	0.96	6.40	6.40	5.49	6.40	4.57	4.57	0.00	WL / S
OW9A-91	1-Oct-91	Limestone	0.74	40.39	40.39	38.86	40.39	37.19	37.19	0.55	WL / S
OW9B-91	1-Oct-91	Gravel	0.84	6.55	6.10	5.18	6.55	4.57	4.57	0.60	WL / S
OW15-91	21-Oct-91	Sand and Gravel	0.85	6.20	5.49	4.57	5.49	3.91	3.91	0.60	WL / S
OW17-91	16-Nov-91	Silt Till / Sand / Silt and Sand	1.00	9.45	5.79	2.74	6.05	2.34	2.34	0.60	Decom
OW21-91	9-Dec-91	Silt and Sand Till / Silt and Clay	0.77	7.70	7.70	6.17	7.70	5.33	5.33	0.60	WL / S
OW25-91	11-Dec-91	Silt some Sand / Gravel	0.56	10.36	9.75	8.84	10.36	7.01	7.01	0.61	WL / S
OW32-96	7-Aug-96	Silt Till	0.89	11.58	11.43	9.91	11.58	6.10	6.10	1.22	WL / S
OW32A-02	17-Sep-02	Limestone	0.45	43.28	43.28	40.24	43.28	36.58	36.58	0.00	WL / S
OW33-96	8-Aug-96	Till	0.91	13.56	13.41	11.89	13.56	9.85	9.85	1.20	WL / S
OW34-96	9-Aug-96	Silt Till	0.82	9.14	8.99	5.94	9.14	4.42	4.42	1.25	WL / S
OW35			0.57		42.08						Inactive
MW04-01			0.65		15.07						Inactive
MW04-02			0.71		11.97						Inactive
MW04-03			0.74		15.82						Inactive
MW04-04			0.77		31.57						Inactive
DP1	24-Nov-15	-	1.12	0.71	0.71	0.41	-	-	-	-	WL
DP2	24-Nov-15	-	1.16	0.67	0.67	0.37	-	-	-	-	WL
DP3	24-Nov-15	-	1.15	0.68	0.68	0.38	-	-	-	-	WL

Monitoring Well	Well Location	Screened Flow System	Elevation (above mean sea level)								
			Ground Elevation	Top of Casing	Bottom of Borehole	Well Screen		Sand Pack		Bentonite Seal	
						Bottom	Top	Bottom	Top	Bottom	Top
OW1-80	Phase II/III	Shallow Overburden	316.02	316.95	308.42	309.12	309.72	308.42	310.02	310.02	310.22
OW2-80	Phase II/III	Shallow Overburden	NA	315.39	NA	NA	NA	NA	NA	NA	NA
OW3-80	Phase I	Shallow Overburden	315.07	316.20	310.47	310.87	311.47	310.47	312.07	312.07	312.27
OW4-80	Phase I	Deep Overburden	315.10	316.13	304.60	305.30	305.90	304.60	306.10	306.10	306.30
OW1-84	Phase I	Shallow Overburden	321.87	322.48	312.27	313.49	314.25	312.27	315.37	315.37	316.00
OW2-84	Phase I	Shallow Overburden	322.19	322.84	312.59	312.66	313.42	312.59	314.11	314.11	315.09
OW3-84	Phase I	Deep Overburden	314.58	315.04	300.71	300.71	301.47	300.71	303.53	303.53	304.22
OW4-84	Phase I	Shallow Overburden	314.52	315.36	300.65	311.47	312.23	311.47	312.69	312.69	313.07
OW5-84	Phase I	Deep Overburden	313.93	314.42	299.15	299.15	299.91	299.15	302.20	302.20	302.65
OW6-84	Phase I	Shallow Overburden	313.93	314.79	299.15	310.73	311.49	310.73	311.75	311.75	311.95
OW7-91	Phase I	Bedrock	314.50	315.27	275.28	275.49	277.01	275.28	280.67	280.67	314.00
OW8A-91	Phase II/III	Bedrock	314.00	314.86	281.64	281.89	283.42	281.89	287.64	287.64	313.40
OW8B-10	Phase II/III	Shallow Overburden	314.39	315.35	307.99	307.99	308.90	307.99	309.82	309.82	314.39
OW9A-91	Phase II/III	Bedrock	317.75	318.49	277.36	277.36	278.89	277.36	280.56	280.56	317.20
OW9B-91	Phase II/III	Shallow Overburden	317.74	318.58	311.19	311.64	312.56	311.19	313.17	313.17	317.14
OW15-91	Phase II/III	Shallow Overburden	317.82	318.67	311.62	312.33	313.25	312.33	313.91	313.91	317.22
OW17-91	Phase II/III	Shallow Overburden	317.39	318.39	307.94	311.60	314.65	311.34	315.05	315.05	316.79
OW21-91	Phase I	Shallow Overburden	319.99	320.76	312.29	312.29	313.82	312.29	314.66	314.66	319.39
OW25-91	Phase II/III	Shallow Overburden	322.86	323.42	312.50	313.11	314.02	312.50	315.85	315.85	322.25
OW32-96	Phase I	Shallow Overburden	322.54	323.43	310.96	311.11	312.63	310.96	316.44	316.44	321.32
OW32A-02	Phase I	Bedrock	322.09	322.54	278.81	278.81	281.85	278.81	285.51	285.51	322.09
OW33-96	Phase I	Shallow Overburden	320.66	321.57	307.10	307.25	308.77	307.10	310.81	310.81	319.46
OW34-96	Phase I	Shallow Overburden	320.77	321.59	311.63	311.78	314.83	311.63	316.35	316.35	319.52
OW35			312.95	313.52		270.87					
MW04-01	CKD Pile		332.90	333.55		317.83					
MW04-02	CKD Pile		329.41	330.12		317.44					
MW04-03	CKD Pile		329.33	330.07		313.51					
MW04-04	Phase II/III	Bedrock	314.21	314.98		282.64					
DP1	Phase II/III		310.06	311.18	309.35	309.35	309.65	-	-	-	-
DP2	Phase I		309.57	310.73	308.90	308.90	309.20	-	-	-	-
DP3	Phase I		308.86	310.01	308.18	308.18	308.48	-	-	-	-

Notes:

- All measurments are in metres
- ags - above ground surface
- MW - monitoring well - 51 mm diameter PVC
- OW - observation well - 51 mm diameter PVC; except OW7-91, OW8A-91 and OW9A-91 - 102 mm diameter PVC
- DP - drive point - 19 mm diameter stainless-steel screen and galvanized steel standpipe
- All measurements are based on conditions at time of construction
- WL - water levels measured as part of monitoring program
- S - water samples collected as part of monitoring program
- NA - not available
- Decom - decommissioned
- CKD - cement kiln dust
- Inactive - not currently monitored

Appendix C1
Summary of Landfill Monitoring Wells & Boreholes
St. Marys Landfill

<i>Borehole</i>	<i>Date</i>	<i>Ground Elevation (amsl)</i>	<i>Borehole Depth (bgs)</i>	<i>Borehole Depth (amsl)</i>	<i>Location</i>
BH10-91	15-Oct-91	317.37	20.12	297.25	Phase II/III
BH11-91	10-Oct-91	316.25	17.68	298.57	Phase II/III
BH12-91	16-Oct-91	317.07	19.96	297.11	Phase II/III
BH13-91	18-Oct-91	313.79	15.54	298.25	Phase II/III
BH14-91	21-Oct-91	317.60	7.57	310.03	Phase II/III
BH16-91	21-Oct-91	317.24	7.32	309.92	Phase II/III
BH18-91	16-Nov-91	317.00	7.47	309.53	Phase II/III
BH19-91	16-Nov-91	317.39	6.71	310.68	Phase II/III
BH20-91	9-Dec-91	315.62	6.71	308.91	Phase II/III
BH22-91	10-Dec-91	314.22	4.27	309.95	Phase II/III
BH23-91	11-Dec-91	313.97	5.18	308.79	Phase II/III
BH24-91	11-Dec-91	313.97	4.57	309.40	Phase II/III
BH26-91	12-Dec-91	316.96	8.23	308.73	Phase II/III
BH27-91	12-Dec-91	316.01	8.23	307.78	Phase II/III
BH28-91	12-Dec-91	313.50	6.55	306.95	Phase II/III
BH29-91	13-Dec-91	314.24	6.71	307.53	Phase II/III
BH30-91	13-Dec-91	317.61	8.23	309.38	Phase II/III
BH31-91	13-Dec-91	316.52	8.08	308.44	Phase II/III

Notes:

All measurements are in metres
amsl - above mean sea level
bgs - below ground surface

DRAFT

Project Name: ST. MARYS LANDFILL SITE
 Job No. 979-645
 Client: TOWN OF ST. MARYS
 Borehole Type: Hollow Stem Auger
 Location: On Site

Borehole No. OW1-80
 Date Completed May 27, 1980
 Geologist/Engineer ESR
 Elevation Top of Casing, 316.946m

Depth (Elev.)	Stratigraphy	Profile Description & Remarks	Sample			Penetration Test Blows/Foot				Piezometer or Standpipe Installation	
			Number	Type	Blows/Foot	20	40	60	80		
3m		Grey clayey-silt till									
			13	AS							
6.1m			14	AS							
7.6m			15	SS 100							

DRAFT

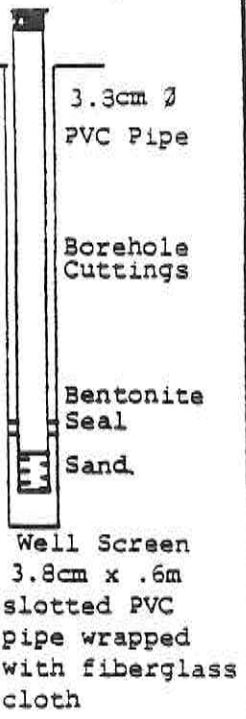
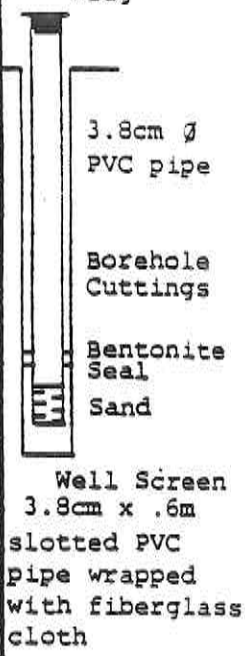


FIGURE 2.1
 Conestoga - Rovers & Associates

Project Name: ST. MARYS LANDFILL SITE
 Job No. 979-645
 Client: TOWN OF ST. MARYS
 Borehole Type: Hollow Stem Auger
 Location: On Site

Borehole No. OW2-80
 Date Completed May 27, 1980
 Geologist/Engineer ESR
 Elevation Top of Casing, 315.386m

Profile			Sample			Penetration Test				Piezometer or Standpipe Installation	
Depth (Elev.)	Stratigraphy	Description & Remarks	Number	Type	Blows/Foot	Blows/Foot					
						20	40	60	80		
3m		Grey clayey-silt till									
6.1m											
6.4m											

DRAFT

FIGURE 2.2
 Conestoga - Rovers & Associates

Project Name: ST. MARYS LANDFILL SITE
 Job No. 979-645
 Client: TOWN OF ST. MARYS
 Borehole Type: Hollow Stem Auger
 Location: _____

Borehole No. OW3-80
 Date Completed May 27, 1980
 Geologist/Engineer ESR
 Elevation Top of casing, 316.197m

Profile		Sample			Penetration Test Blows/Foot				Piezometer or Standpipe Installation
Depth (Elev.)	Stratigraphy	Description & Remarks	Number	Type	Blows/Foot	20 40 60 80			
1.8m		Grey clayey silt till							
2.4m		Grey, clayey silt							
3m		Grey clayey silt till	11	AG					
4.6m			12	SS	40				

FIGURE 2.3
 Conestoga - Rovers & Associates

Project Name: ST. MARYS LANDFILL SITE
 Job No. 979-645
 Client: TOWN OF ST. MARYS
 Borehole Type: Hollow Stem Auger
 Location: _____

Borehole No. OW4-80
 Date Completed May 27, 1980
 Geologist/Engineer ESR
 Elevation Top of Casing, 316.126m


Profile		Sample		Penetration Test Blows/Foot				Piezometer or Standpipe Installation		
Depth (Elev.)	Stratigraphy	Description & Remarks	Number	Type	Blows/Foot	20 40 60 80				
						1.2m		Grey clayey silt till	1	SS
1.8m		Grey clayey silt	2	SS	53					
3m		Grey clayey silt till	3	SS	56					
			4	SS						
			5	SS	26					
			6	SS	31					
			7	SS	31					
6.1m			8	SS						
			9	SS	62					
9.1m			10	SS	100					
10.2m		Rock								

FIGURE 2.4
 Conestoga - Rovers & Associates

STRATIGRAPHIC AND INSTRUMENTATION LOG

PROJECT NAME : ST. MARYS LANDFILL SITE
 JOB N° : 9-645
 CLIENT : TOWN OF ST. MARYS
 HOLE TYPE : HOLLOW STEM AUGER
 LOCATION : _____

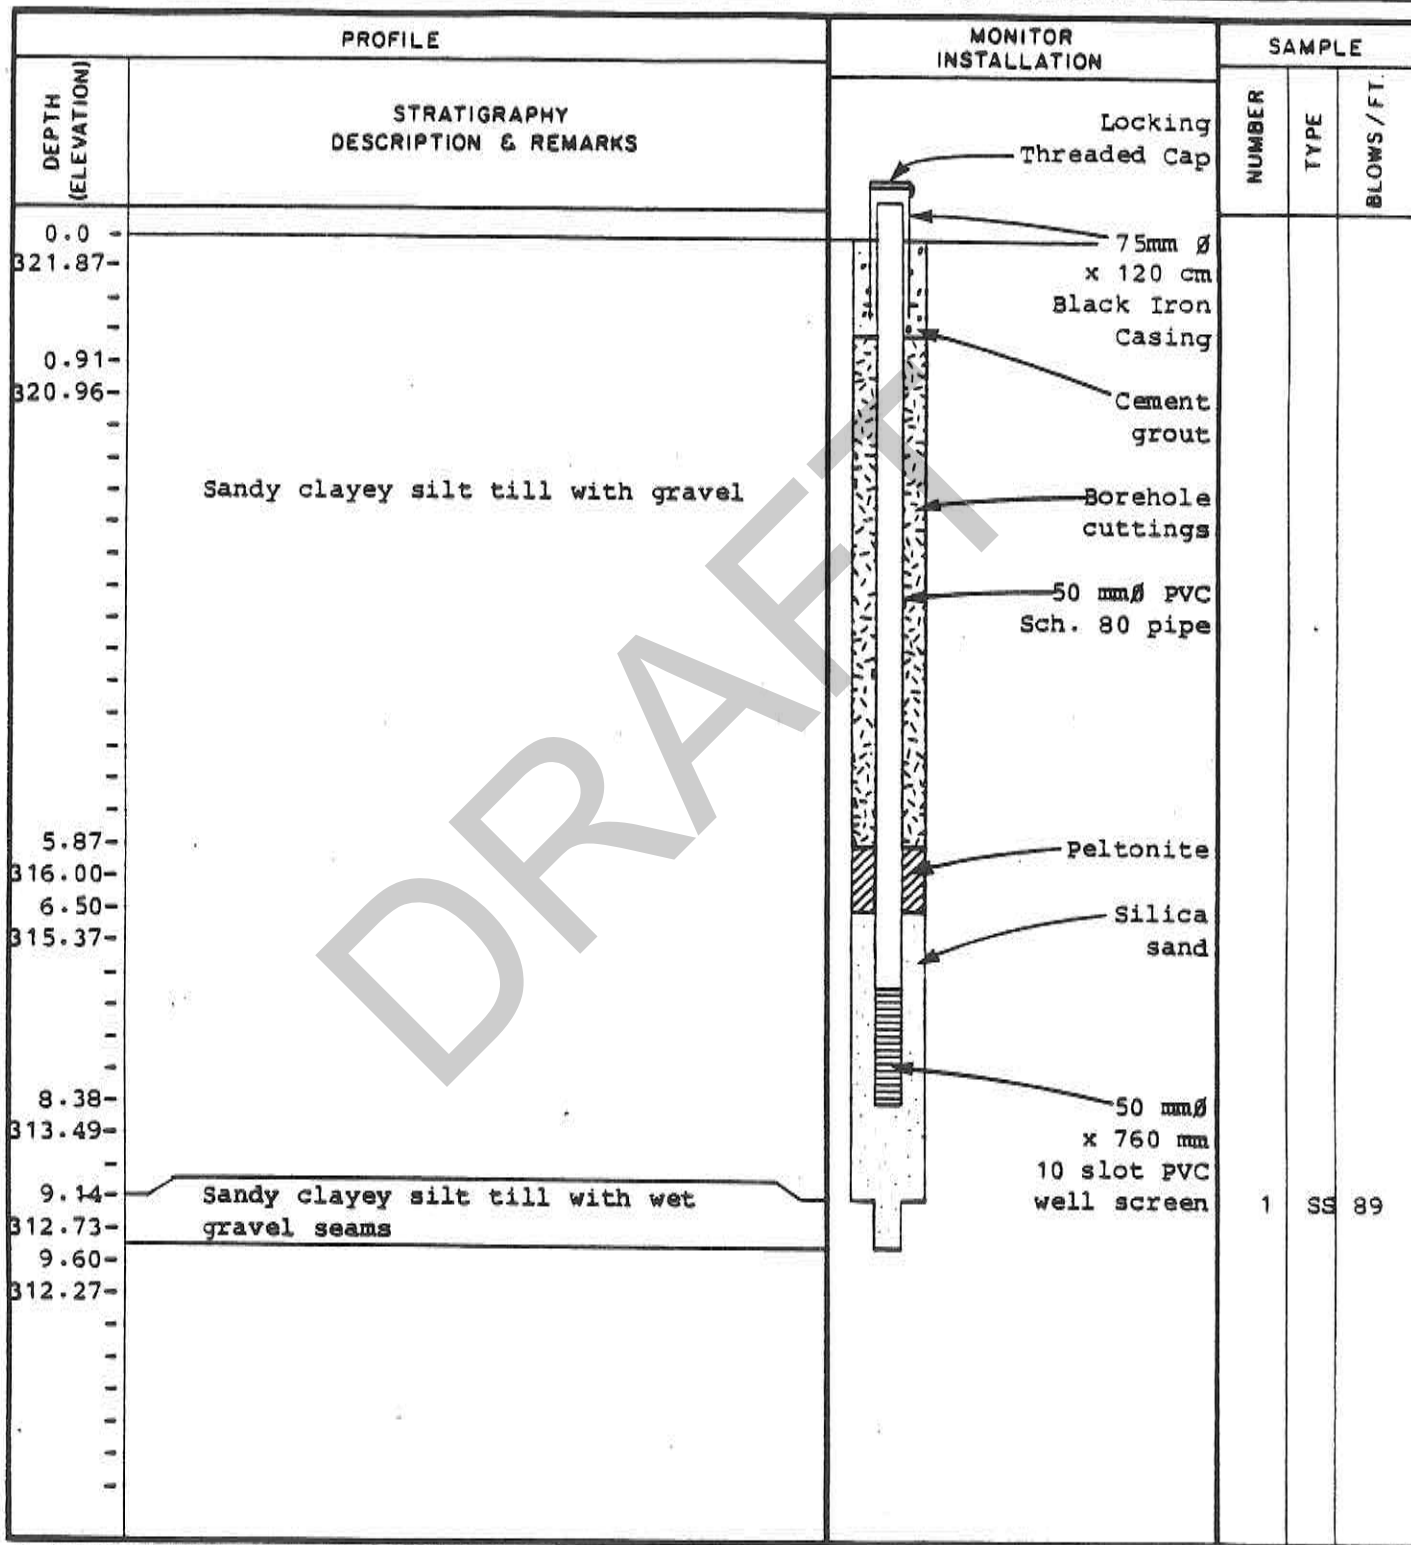HOLE N° : OW1-84
 DATE COMPLETED : SEPTEMBER 25, 1984
 GEOLOGIST/ENGINEER : PSB
 GROUND ELEVATION : * 321.87 m AMSL
 TOP OF PIPE ELEVATION : * 322.484 M AMSL



* REFER TO "WATER ELEVATIONS" TABLE FOR CURRENT REFERENCE ELEVATIONS

▼ WATER FOUND ▽ STATIC WATER LEVEL ○ GRAIN SIZE ANALYSIS SS - SPLIT SPOON SAMPLE

STRATIGRAPHIC AND INSTRUMENTATION LOG

PROJECT NAME : ST. MARYS LANDFILL SITE
 JOB N^o : 9-645
 CLIENT : TOWN OF ST. MARYS
 HOLE TYPE : HOLLOW STEM AUGER
 LOCATION : _____

HOLE N^o : OW3-84, OW4-84 - page 1 of
 DATE COMPLETED : SEPTEMBER 24, 1984
 GEOLOGIST/ENGINEER : PSB
 GROUND ELEVATION : * 314.52 m AMSL
 TOP OF PIPE ELEVATION : * 315.035, 315.364 m

PROFILE		MONITOR INSTALLATION		SAMPLE		
DEPTH (ELEVATION)	STRATIGRAPHY DESCRIPTION & REMARKS	OW3-84	OW4-84	NUMBER	TYPE	BLOWS / FT.
0.0 - 314.52 -		Locking Threaded Cap	75 mmØ x 120 cm Black Iron Casing			
1.45 - 313.07 -			Cement grout	1	SS	48
1.83 - 312.69 -	Interbedded moist to wet brown silty sand and clayey silt with minor gravel		50 mmØ PVC Sch. 80 pipe			
3.05 - 311.47 -			Peltonite	2	SS	88
3.66 - 310.86 -	Dry brown clayey silt till with minor gravel		Silica Sand 50 mmØ x 760 mm 10 slot PVC Well Screen			
-			Borehole cuttings	3	SS	54
-				50 mmØ PVC Sch. 80 pipe	4	SS
10.06 - 304.46 -	Moist brown clayey silt till with sand and minor gravel			5	SS	180
10.36 - 304.16 -			Peltonite	6	SS	183
11.05 - 303.47 -				Silica sand	7	SS
12.19 - 302.33 -				8	SS	102

* REFER TO "WATER ELEVATIONS" TABLE FOR CURRENT REFERENCE ELEVATIONS

▼ WATER FOUND ▽ STATIC WATER LEVEL ○ GRAIN SIZE ANALYSIS SS - SPLIT SPOON SAMPLE

STRATIGRAPHIC AND INSTRUMENTATION LOG

PROJECT NAME : ST. MARYS LANDFILL SITE
 JOB N° : 9-645
 CLIENT : TOWN OF ST. MARYS
 HOLE TYPE : HOLLOW STEM AUGER
 LOCATION : _____

HOLE N° : OW3-84, OW4-84 - page 2 of
 DATE COMPLETED : SEPTEMBER 24, 1984
 GEOLOGIST/ENGINEER : PSB
 GROUND ELEVATION : * 314.52 m AMSL
 TOP OF PIPE ELEVATION : * 315.035, 315.364 m


DEPTH (ELEVATION)	PROFILE	MONITOR INSTALLATION	SAMPLE		
	STRATIGRAPHY DESCRIPTION & REMARKS		NUMBER	TYPE	BLOWS / FT.
12.19- 302.33- 13.11- 301.41- 13.87- 300.65-	Moist brown clayey silt till with sand and minor gravel Moist brown medium sand with fine sand and fine gravel Bedrock	<p style="font-size: small;">50 mmØ PVC Sch. 80 pipe Silica sand 50 mmØ x 760 mm 10 slot PVC Well screen</p>	9	SS	60

* REFER TO "WATER ELEVATIONS" TABLE FOR CURRENT REFERENCE ELEVATIONS
 ▼ WATER FOUND ▽ STATIC WATER LEVEL ○ GRAIN SIZE ANALYSIS SS - SPLIT SPOON SAMPLE

STRATIGRAPHIC AND INSTRUMENTATION LOG

PROJECT NAME : ST. MARYS LANDFILL SITE
 JOB N° : 9-645
 CLIENT : TOWN OF ST. MARYS
 HOLE TYPE : HOLLOW STEM AUGER
 LOCATION : _____

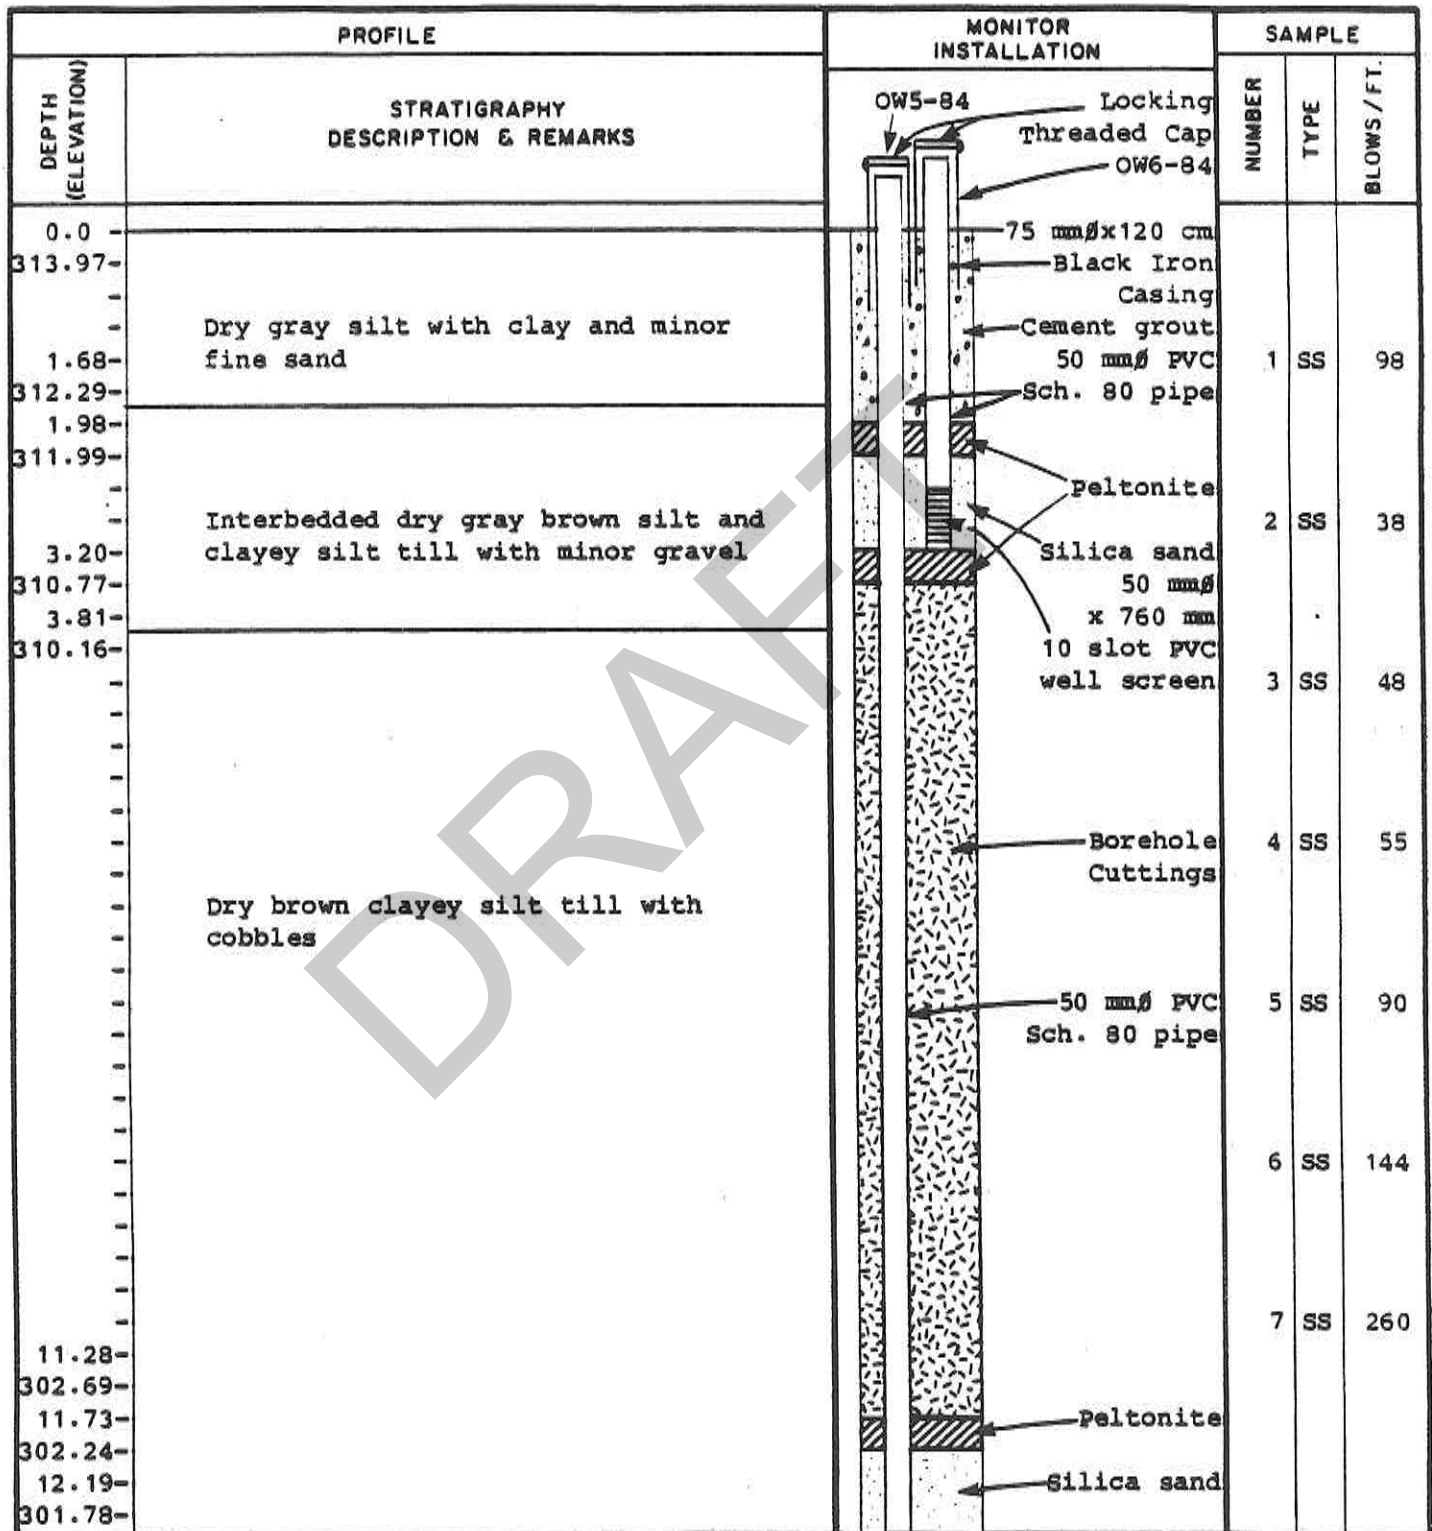HOLE N° : OW5-84, OW6-84 - page 1 o
 DATE COMPLETED : SEPTEMBER 25, 1984
 GEOLOGIST/ENGINEER : PSB
 GROUND ELEVATION : * 313.97 m AMSL
 TOP OF PIPE ELEVATION : * 314.423, 314.794



* REFER TO "WATER ELEVATIONS" TABLE FOR CURRENT REFERENCE ELEVATIONS

▼ WATER FOUND ▽ STATIC WATER LEVEL ○ GRAIN SIZE ANALYSIS SS — SPLIT SPOON SAMPLE

STRATIGRAPHIC AND INSTRUMENTATION LOG



PROJECT NAME : ST. MARYS LANDFILL SITE
 JOB N^o : 9-645
 CLIENT : TOWN OF ST. MARYS
 HOLE TYPE : HOLLOW STEM AUGER
 LOCATION : _____

HOLE N^o : OW5-84, OW6-84 - page 2 of
 DATE COMPLETED : SEPTEMBER 25, 1984
 GEOLOGIST/ENGINEER : PSB
 GROUND ELEVATION : * 313.97 m AMSL
 TOP OF PIPE ELEVATION : * 314.423, 314.794 m

PROFILE		MONITOR INSTALLATION		SAMPLE		
DEPTH (ELEVATION)	STRATIGRAPHY DESCRIPTION & REMARKS			NUMBER	TYPE	BLOWS/FT.
12.19- 301.78- 12.80- 301.17-	Dry brown clayey silt till with cobbles			8	SS	165
- - 14.33- 299.64- 14.78- 299.19-	Wet brown coarse sand with gravel and medium sand Bedrock			9	SS	108


* REFER TO "WATER ELEVATIONS" TABLE FOR CURRENT REFERENCE ELEVATIONS

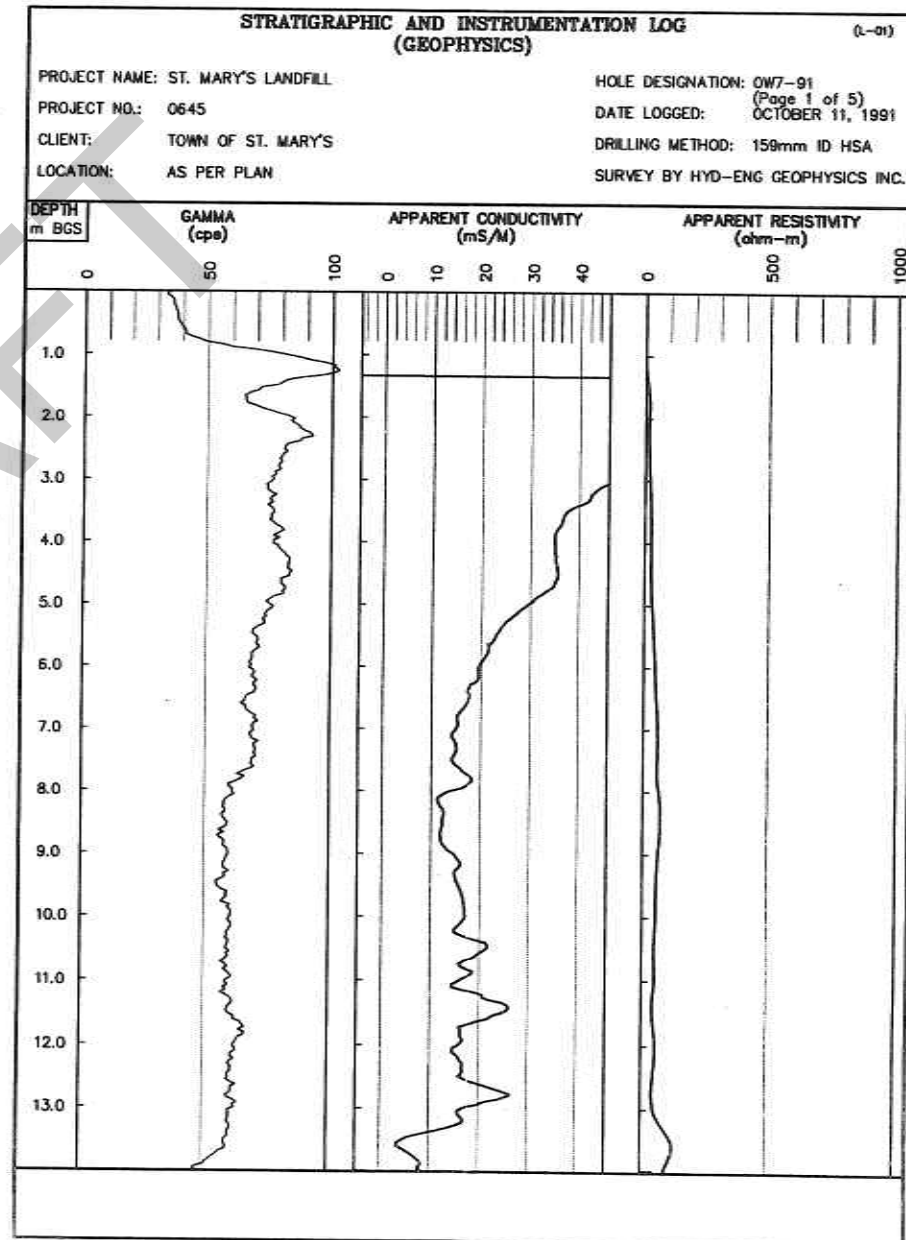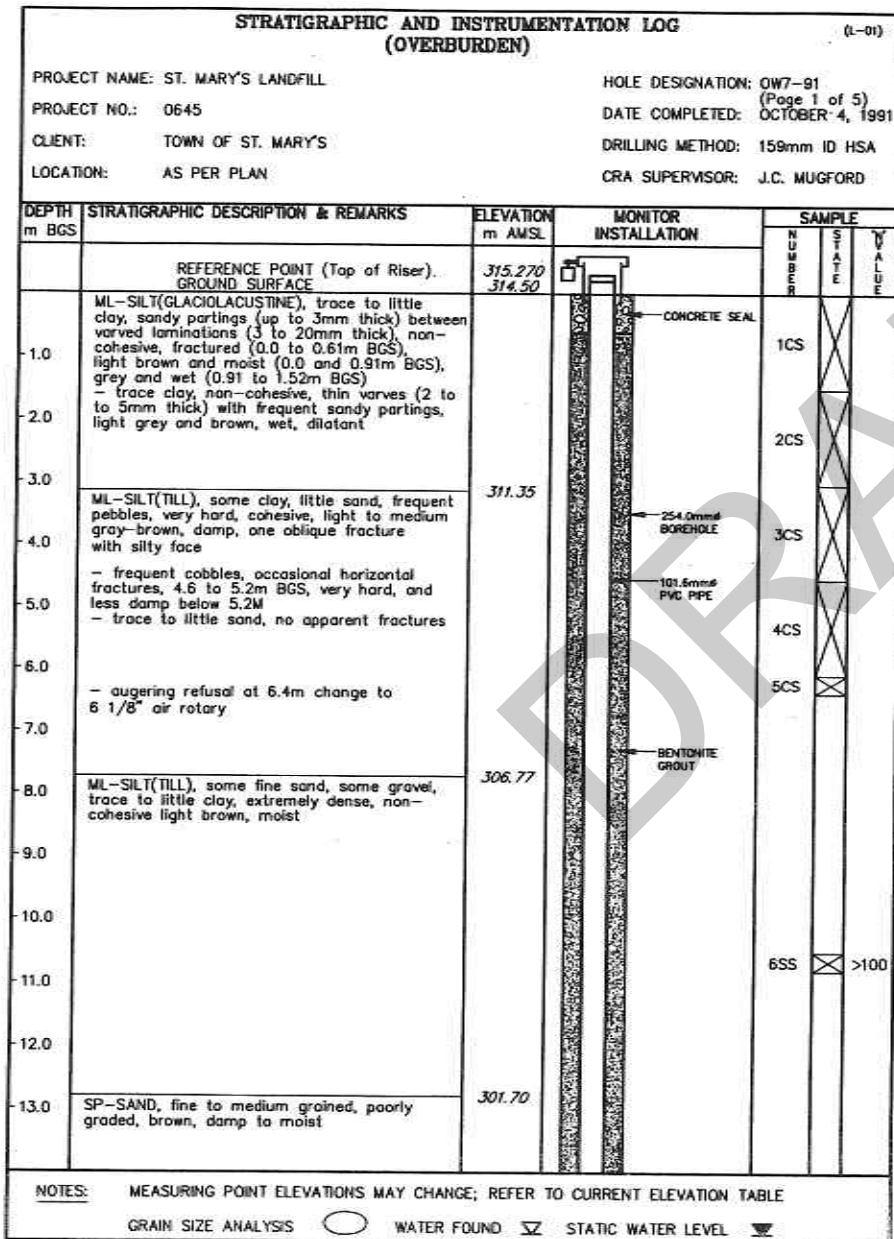▼ WATER FOUND ▽ STATIC WATER LEVEL ○ GRAIN SIZE ANALYSIS SS - SPLIT SPOON SAMPLE




STRATIGRAPHIC AND INSTRUMENTATION LOG (OVERBURDEN) (L-01)						
PROJECT NAME: ST. MARY'S LANDFILL		HOLE DESIGNATION: OW7-91 (Page 2 of 5)				
PROJECT NO.: 0645		DATE COMPLETED: OCTOBER 4, 1991				
CLIENT: TOWN OF ST. MARY'S		DRILLING METHOD: 159mm ID HSA				
LOCATION: AS PER PLAN		CRA SUPERVISOR: J.C. MUGFORD				
DEPTH m BGS	STRATIGRAPHIC DESCRIPTION & REMARKS	ELEVATION m AMSL	MONITOR INSTALLATION	SAMPLE		
				NUMBER	SITE	VALUE
-14.0	- fine to medium gravel END OF OVERBURDEN HOLE @ 14.12 m BGS.	300.40				
-15.0						
-16.0						
-17.0						
-18.0						
-19.0						
-20.0						
-21.0						
-22.0						
-23.0						
-24.0						
-25.0						
-26.0						

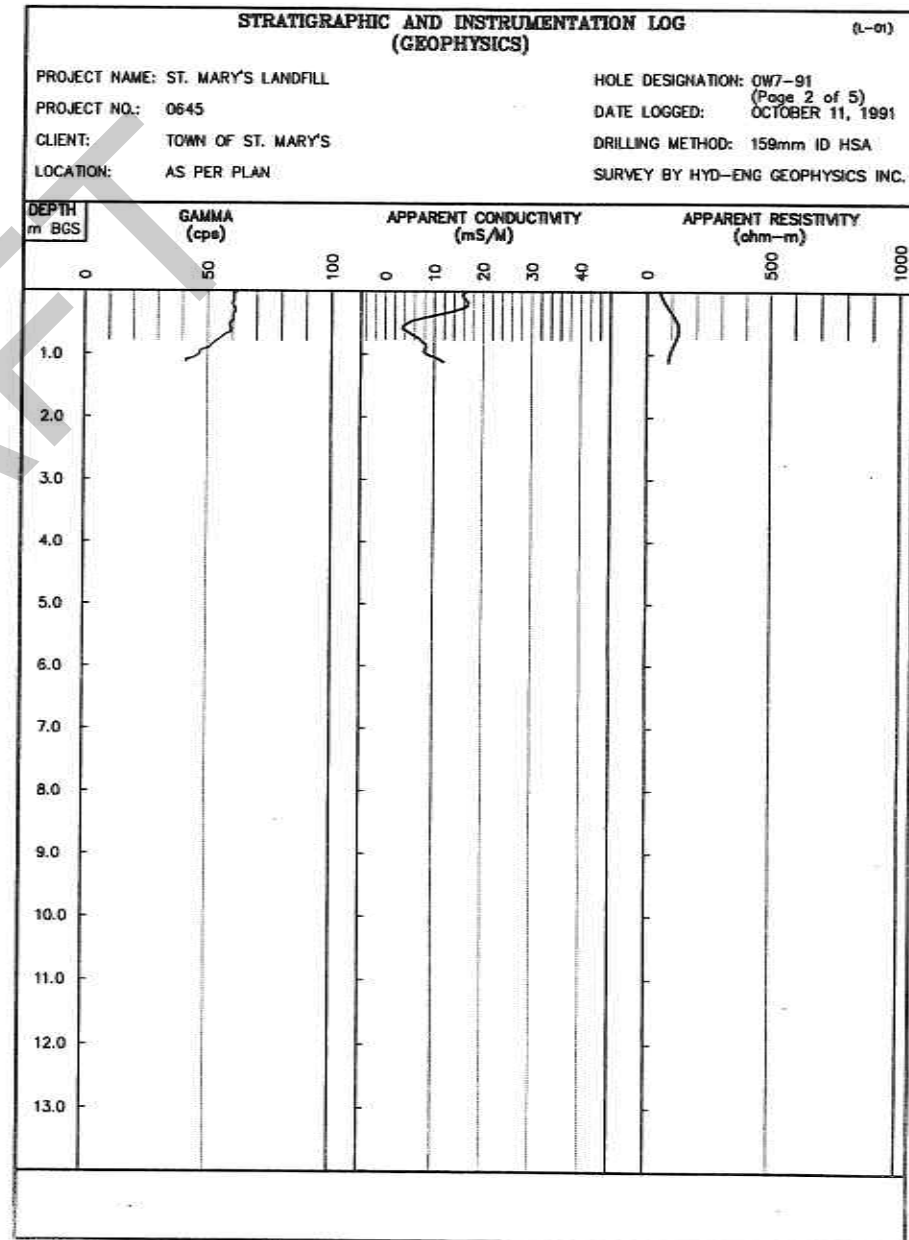NOTES: MEASURING POINT ELEVATIONS MAY CHANGE; REFER TO CURRENT ELEVATION TABLE
GRAIN SIZE ANALYSIS ○ WATER FOUND ∇ STATIC WATER LEVEL ▼





STRATIGRAPHIC AND INSTRUMENTATION LOG (BEDROCK)							(L-02)	
PROJECT NAME: ST. MARY'S LANDFILL		HOLE DESIGNATION: OW7-91 (Page 3 of 5)						
PROJECT NO.: 0645		DATE COMPLETED: OCTOBER 4, 1991						
CLIENT: TOWN OF ST. MARY'S		DRILLING METHOD: 15cm AIR ROTARY / HQ 6.4cm CORE						
LOCATION: AS PER PLAN		CRA SUPERVISOR: J.C. MUGFORD						
DEPTH	DESCRIPTION OF STRATA	ELEVATION	MONITOR INSTALLATION	BIEN DT RE OR CV KAL	RN UU NMB ER	CR OCE RO VE RY	R O D	WR AET T E U RR N
m BGS		m AMSL				%	%	%
14.0	See Overburden log	300.37	254.0mm ϕ BOREHOLE BENTONITE GROUT					
15.0	LIMESTONE(Dundee Formation): grey, hard, interbeds of brown argillaceous limestone (as described from drilling returns)							
16.0								
17.0			154.5mm ϕ BOREHOLE					
18.0	- argillaceous limestone, soft, brown, interbeds of hard grey limestone							
19.0								
20.0			101.6mm ϕ PVC PIPE					
21.0								
22.0	LIMESTONE(Lucas Formation):	292.50						
23.0								
24.0								
25.0								
NOTES: MEASURING POINT ELEVATIONS MAY CHANGE; REFER TO CURRENT ELEVATION TABLE								
<input checked="" type="checkbox"/> WATER FOUND <input checked="" type="checkbox"/> STATIC WATER LEVEL <input type="checkbox"/> NM - NOT MEASURED								

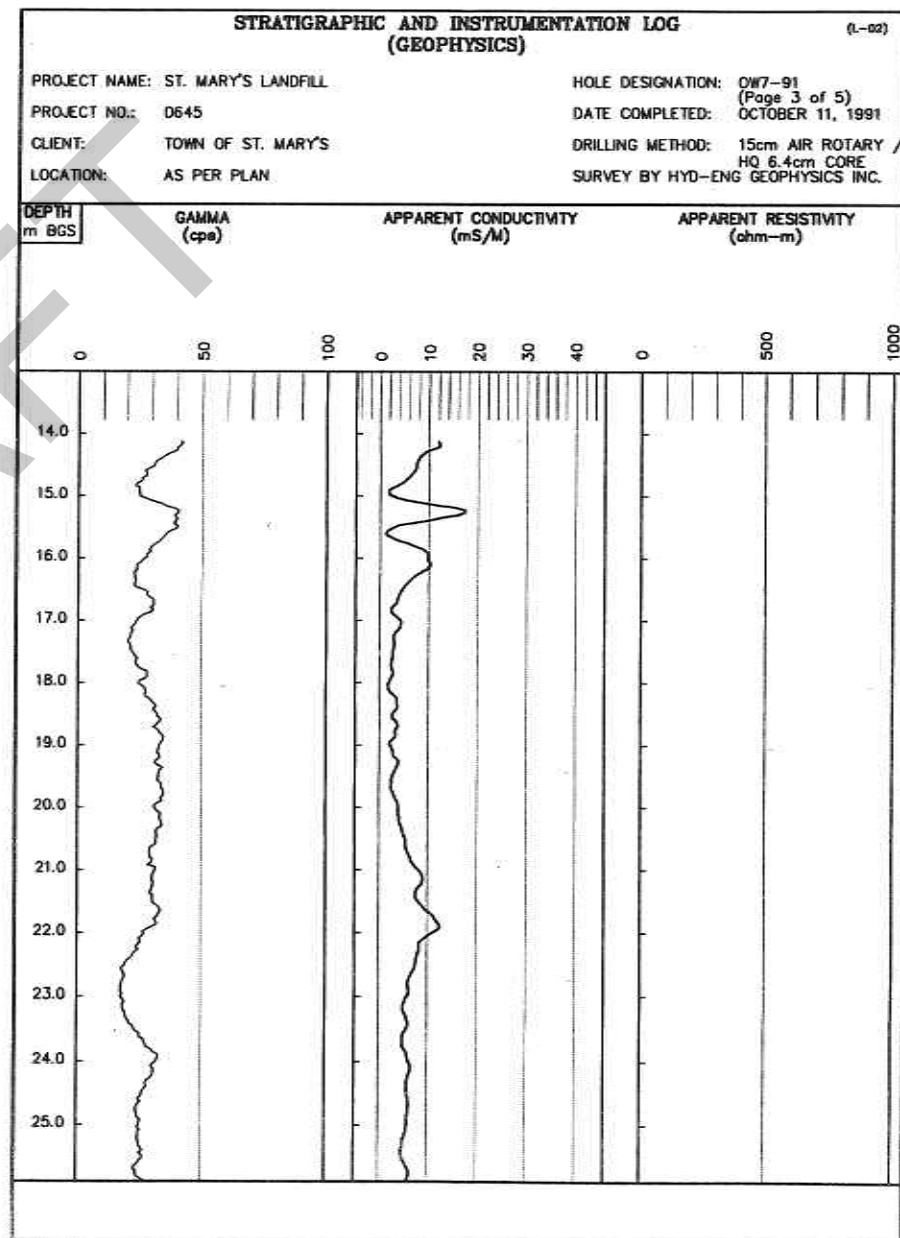

STRATIGRAPHIC AND INSTRUMENTATION LOG (BEDROCK) (L-02)								
PROJECT NAME: ST. MARY'S LANDFILL		HOLE DESIGNATION: OW7-91 (Page 4 of 5)						
PROJECT NO.: 0645		DATE COMPLETED: OCTOBER 4, 1991						
CLIENT: TOWN OF ST. MARY'S		DRILLING METHOD: 15cm AIR ROTARY / HQ 6.4cm CORE						
LOCATION: AS PER PLAN		CRA SUPERVISOR: J.C. MUGFORD						
DEPTH	DESCRIPTION OF STRATA	ELEVATION	MONITOR INSTALLATION	BIEN DT RE OR CV KAL	RN UP NM B BR	CR OF CO VE RY	R RD	WR AE TT ER RN
m BGS		m AMSL				%	%	%
26.0	- damp		BENTONITE GROUT					
27.0			154.9mm BOREHOLE					
28.0		285.99	101.6mm PVC PIPE					
29.0								
30.0	- few thin shale interbeds							
31.0								
32.0								
33.0								
34.0								
35.0	- light to dark brown, sugary to porous / granular texture, layered							
36.0	- grey (35.66 to 35.81m BGS)		SAND PACK		1	100	30	
37.0	- grey with occasional brown layers, brown rock is medium to high porosity, grey rock is low porosity, well fractured, some small wugs and solution cavities, stylolites							

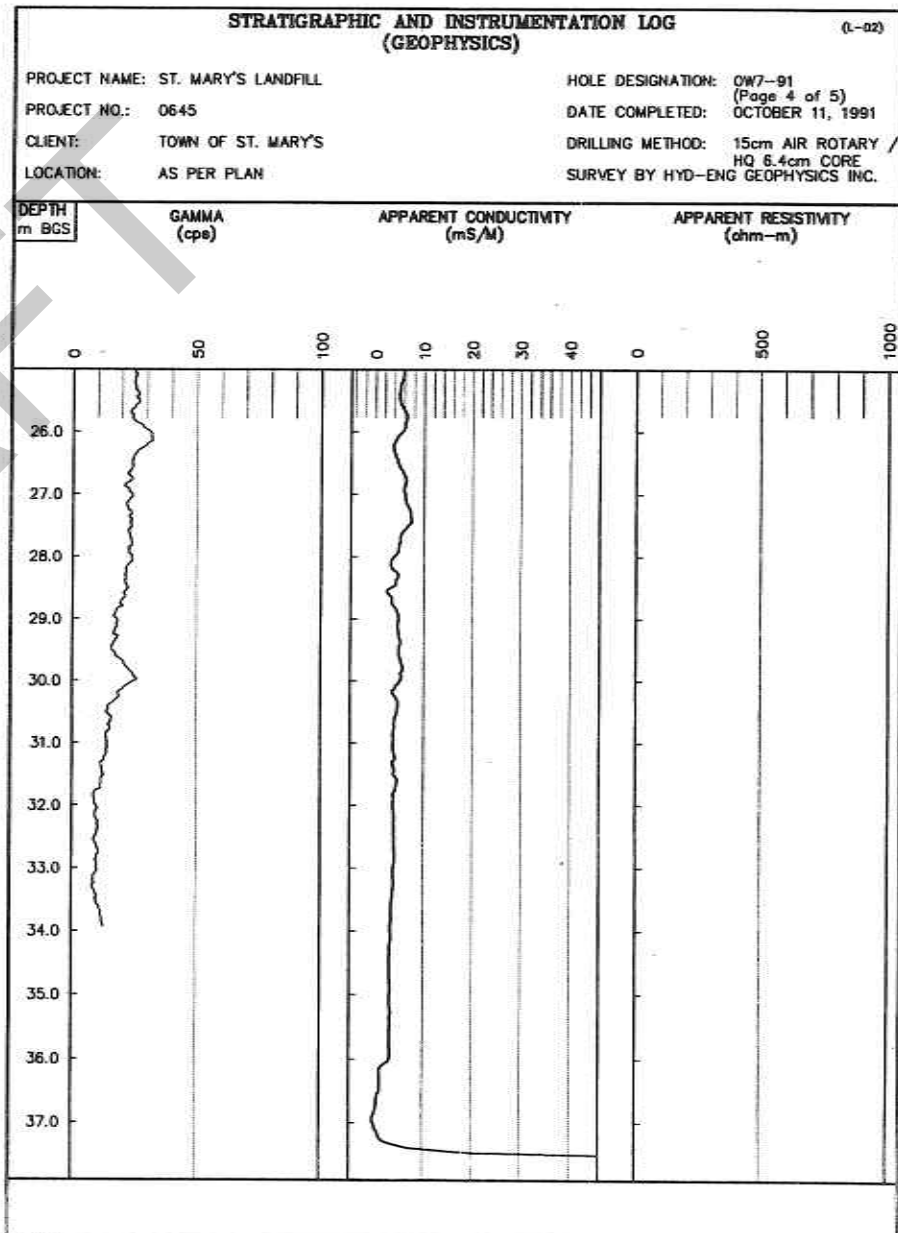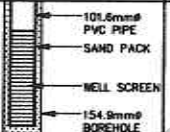
NOTES: MEASURING POINT ELEVATIONS MAY CHANGE; REFER TO CURRENT ELEVATION TABLE
 ☒ WATER FOUND ☒ STATIC WATER LEVEL (OCT 26, 1991) NM - NOT MEASURED



STRATIGRAPHIC AND INSTRUMENTATION LOG (BEDROCK)							(L-02)		
PROJECT NAME: ST. MARY'S LANDFILL		HOLE DESIGNATION: OW7-91 (Page 5 of 5)							
PROJECT NO.: 0645		DATE COMPLETED: OCTOBER 4, 1991							
CLIENT: TOWN OF ST. MARY'S		DRILLING METHOD: 15cm AIR ROTARY / HQ 6.4cm CORE							
LOCATION: AS PER PLAN		CRA SUPERVISOR: J.C. MUGFORD							
DEPTH	DESCRIPTION OF STRATA	ELEVATION	MONITOR INSTALLATION	BIEN DT RE CY VAL	RN QU NM BE R	CR RE CO VE RY	RO OD	WR AT TE UR RN	
m BGS		m AMSL				%	%	%	
38.0	- fractured (⊙ 37.95m BGS)		 <p>SCREEN DETAILS: Screened Interval: 37.49 to 39.01m BGS Length -1.5m Diameter -101.6mm Slot # 10 Material -Stainless Steel Sand pack interval: 33.83 to 39.22m BGS Material -# 3 Silica Sand</p>						
39.0	- fractured (⊙ 38.40m BGS)								
	- fractured (⊙ 38.71m BGS)								
	- (as indicated by drilling rate)								
	END OF HOLE ⊙ 39.22 m BGS.	275.28							
40.0									
41.0									
42.0									
43.0									
44.0									
45.0									
46.0									
47.0									
48.0									
49.0									
NOTES: MEASURING POINT ELEVATIONS MAY CHANGE; REFER TO CURRENT ELEVATION TABLE									
<input checked="" type="checkbox"/> WATER FOUND <input checked="" type="checkbox"/> STATIC WATER LEVEL NM - NOT MEASURED									


STRATIGRAPHIC AND INSTRUMENTATION LOG (GEOPHYSICS)				(L-02)
PROJECT NAME: ST. MARY'S LANDFILL		HOLE DESIGNATION: OW7-91 (Page 5 of 5)		
PROJECT NO.: 0645		DATE COMPLETED: OCTOBER 11, 1991		
CLIENT: TOWN OF ST. MARY'S		DRILLING METHOD: 15cm AIR ROTARY / HQ 6.4cm CORE		
LOCATION: AS PER PLAN		SURVEY BY HYD-ENG GEOPHYSICS INC.		
DEPTH	GAMMA	APPARENT CONDUCTIVITY	APPARENT RESISTIVITY	
m BGS	(cps)	(mS/m)	(ohm-m)	
	0 50 100	0 10 20 30 40	0 500 1000	
38.0				
39.0				
40.0				
41.0				
42.0				
43.0				
44.0				
45.0				
46.0				
47.0				
48.0				
49.0				

STRATIGRAPHIC AND INSTRUMENTATION LOG (OVERBURDEN) (L-03)						
PROJECT NAME: ST. MARY'S LANDFILL		HOLE DESIGNATION: OWBA-91				
PROJECT NO.: 0645		DATE COMPLETED: OCTOBER 3, 1991 (Page 1 of 4)				
CLIENT: TOWN OF ST. MARY'S		DRILLING METHOD: 6 1/4" ID HSA				
LOCATION: AS PER PLAN		CRA SUPERVISOR: J.C. MUGFORD				
DEPTH m BGS	STRATIGRAPHIC DESCRIPTION & REMARKS	ELEVATION m AMSL	MONITOR INSTALLATION	SAMPLE		
				NUMBER	STATE	VALUE
	REFERENCE POINT (Top of Riser) GROUND SURFACE	314.860				
		314.00				
1.0	ML-SILT(FILL), some clay, some cobbles, hard, brown, damp	313.70	CONCRETE SEAL	1CS		
	ML-SILT(GLACIOLACUSTRINE), little to some fine grained sand, trace clay, tan, damp	313.09	254.0mm BOREHOLE	2CS		
2.0	ML/CL-SILT(TILL), some clay, some sand, some pebbles and cobbles, extremely hard, massive, no fracturing, brown, damp		BENTONITE GROUT	3CS		
3.0	- becomes light brown to grey, lots of cobbles			4CS		
4.0	- preferential parting in horizontal plane, fewer cobbles and gravel, damp to moist			5CS		
5.0	- some pebbles and small cobbles		101.8mm PVC PIPE			
6.0	- more fractured		158.8mm BOREHOLE			
7.0	- fewer pebbles, some horizontal fracturing, minor vertical fracturing, less damp					
8.0						
9.0	- little fine sand, little gravel, very hard, damp to moist					
10.0	- boulder					
11.0				6SS		>100
12.0						
13.0						
NOTES: MEASURING POINT ELEVATIONS MAY CHANGE; REFER TO CURRENT ELEVATION TABLE. GRAIN SIZE ANALYSIS ○ WATER FOUND ◊ STATIC WATER LEVEL ▽						

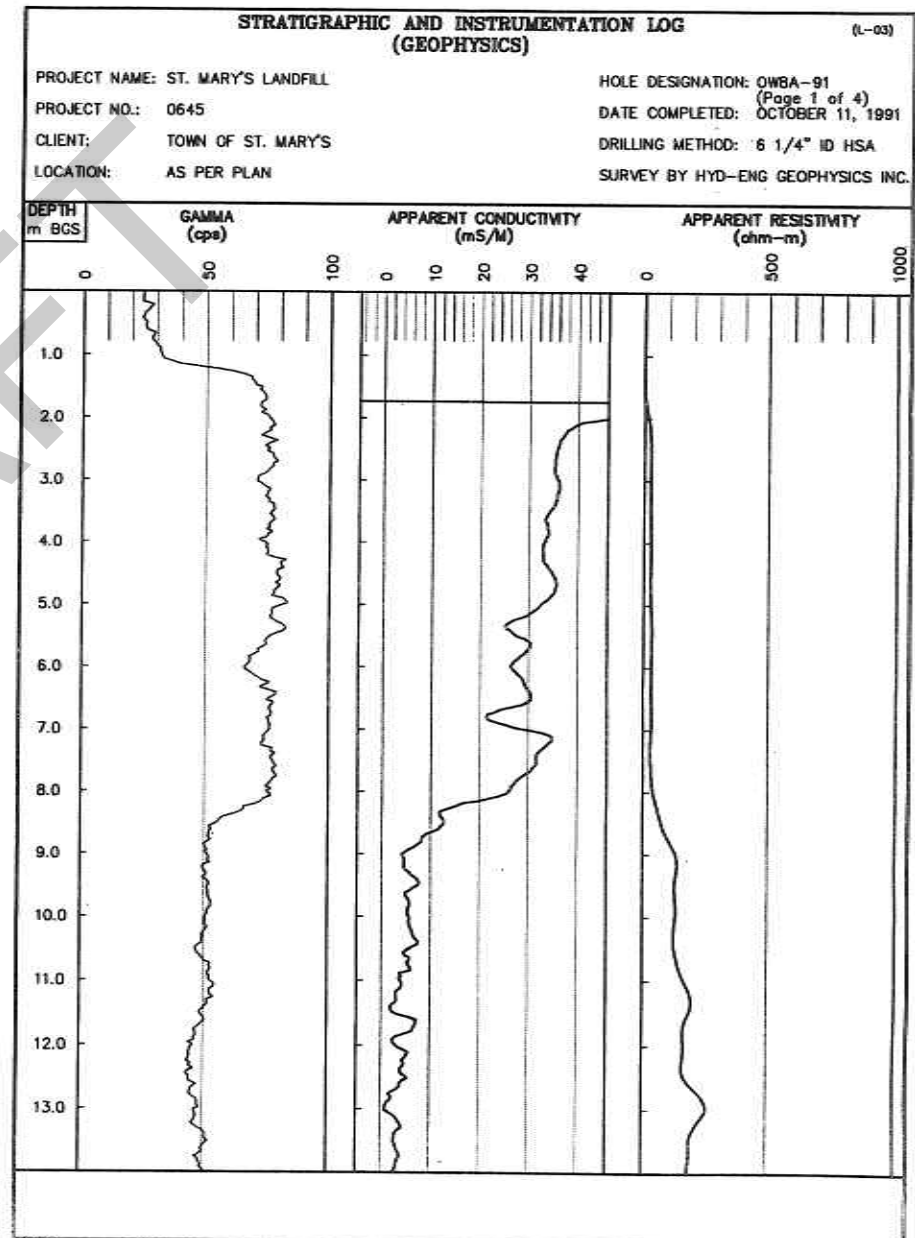


STRATIGRAPHIC AND INSTRUMENTATION LOG (OVERBURDEN) (L-03)						
PROJECT NAME: ST. MARY'S LANDFILL		HOLE DESIGNATION: OWBA-91 (Page 2 of 4)				
PROJECT NO.: 0645		DATE COMPLETED: OCTOBER 3, 1991				
CLIENT: TOWN OF ST. MARY'S		DRILLING METHOD: 6 1/4" ID HSA				
LOCATION: AS PER PLAN		CRA SUPERVISOR: J.C. MUGFORD				
DEPTH m BGS	STRATIGRAPHIC DESCRIPTION & REMARKS	ELEVATION m AMSL	MONITOR INSTALLATION	SAMPLE		
				NUMBER	STATE	VALUE
14.0	- boulder, moist					
15.0	- firm, moist to wet, dilatant					
16.0				7SS	⊗	75
17.0						
18.0	END OF OVERBURDEN HOLE @ 17.83 m BGS. CONTINUED ON BEDROCK LOG	296.17				
19.0						
20.0						
21.0						
22.0						
23.0						
24.0						
25.0						
26.0						

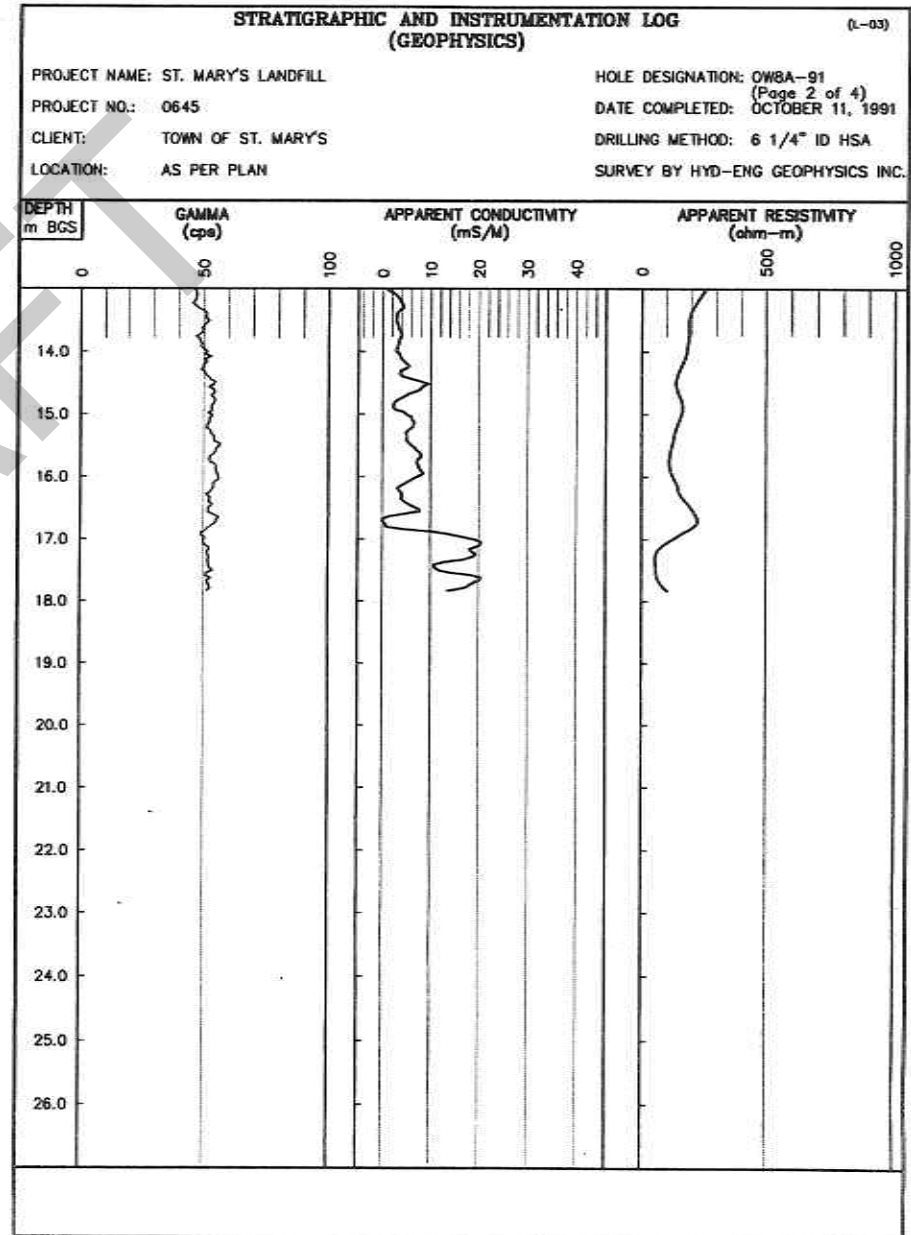NOTES: MEASURING POINT ELEVATIONS MAY CHANGE; REFER TO CURRENT ELEVATION TABLE
GRAIN SIZE ANALYSIS ○ WATER FOUND ▽ STATIC WATER LEVEL ▼




STRATIGRAPHIC AND INSTRUMENTATION LOG (BEDROCK)							(L-04)	
PROJECT NAME: ST. MARY'S LANDFILL		HOLE DESIGNATION: OWBA-91 (Page 3 of 4)		DRILLING METHOD: 15cm AIR ROTARY / HQ CORE			CRA SUPERVISOR: J.C. MUGFORD	
PROJECT NO.: 0645		DATE COMPLETED: OCTOBER 3, 1991		CRA SUPERVISOR: J.C. MUGFORD				
CLIENT: TOWN OF ST. MARY'S		DRILLING METHOD: 15cm AIR ROTARY / HQ CORE		CRA SUPERVISOR: J.C. MUGFORD				
LOCATION: AS PER PLAN		CRA SUPERVISOR: J.C. MUGFORD		CRA SUPERVISOR: J.C. MUGFORD				
DEPTH	DESCRIPTION OF STRATA	ELEVATION m AMSL	MONITOR INSTALLATION	BI EN DE RE OR CY KAL	RH OU NM B ER	CR OE SC ED V CR Y	R Q D	WR AS TI EU RR N
m BGS		m AMSL				%	%	%
17.0	See Overburden log							
18.0	LIMESTONE(Dundee Formation): light brown to brown and light to dark grey, fine grained, sugary texture argillaceous, soft, dry (as described from drilling returns)	296.17						
19.0								
20.0			158.8mm BOREHOLE					
21.0								
22.0			BENTONITE GROUT					
23.0								
24.0								
25.0			101.6mm PVC PIPE					
26.0	LIMESTONE(Lucas Formation):	288.00	BENTONITE PELLET SEAL					
27.0			SAND PACK					
28.0	- water bearing fracture (28.19 to 28.35m BGS)	286.27						

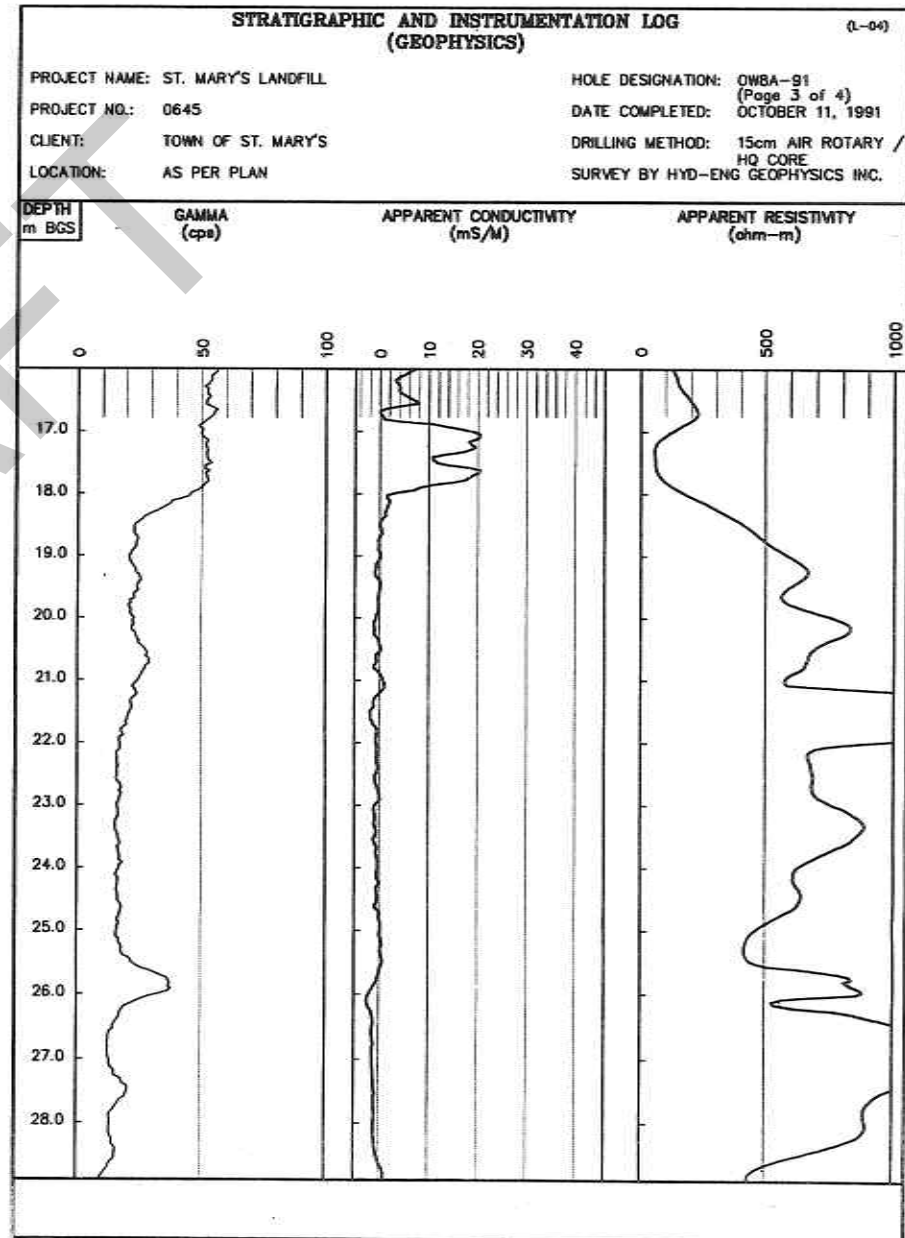NOTES: MEASURING POINT ELEVATIONS MAY CHANGE; REFER TO CURRENT ELEVATION TABLE
 ☒ WATER FOUND ☒ STATIC WATER LEVEL (OCT 26/91) NM - NOT MEASURED



STRATIGRAPHIC AND INSTRUMENTATION LOG (BEDROCK) (L-04)									
PROJECT NAME: ST. MARY'S LANDFILL		HOLE DESIGNATION: OWBA-91 (Page 4 of 4)							
PROJECT NO.: 0645		DATE COMPLETED: OCTOBER 3, 1991							
CLIENT: TOWN OF ST. MARY'S		DRILLING METHOD: 15cm AIR ROTARY / HQ CORE							
LOCATION: AS PER PLAN		CRA SUPERVISOR: J.C. MUGFORD							
DEPTH	DESCRIPTION OF STRATA	ELEVATION	MONITOR INSTALLATION	BIEN DT RE OR CV KAL	RH UU NW B ERE R	CR CE D V E R Y	R Q D	WR AC T U R R H	
m BGS		m AMSL				%	%	%	
29.0	- light grey to brown, solution cavities and vugs (up to 2cm thick) with calcite infilling, stylolites								
	- iron staining (28.35 to 28.65m BGS)								
	- brown (28.65m to 29.11m BGS)								
	- water bearing fracture @ 28.80m BGS								
30.0	- grey (29.11 to 29.72m BGS)								
	- water bearing fracture @ 29.11m BGS								
	- brown (29.72 to 32.00m BGS)						1	100	40
	- water bearing fracture (29.72m BGS)								
31.0	- porous (29.72 to 29.87m BGS)								
	- water bearing fracture @ 30.02m BGS								
	- water bearing fracture @ 30.33m BGS								
32.0	- rough and open water bearing fracture @ 30.94m BGS								
	- porous (31.89 to 31.55m BGS)								
	- water bearing fracture @ 31.69m BGS	281.64							
	- water bearing fracture @ 32.00m BGS								
33.0	- grey (32.00 to 32.36m BGS)								
	END OF HOLE @ 32.36 m BGS.								
34.0									
35.0									
36.0									
37.0									
38.0									
39.0									
40.0									

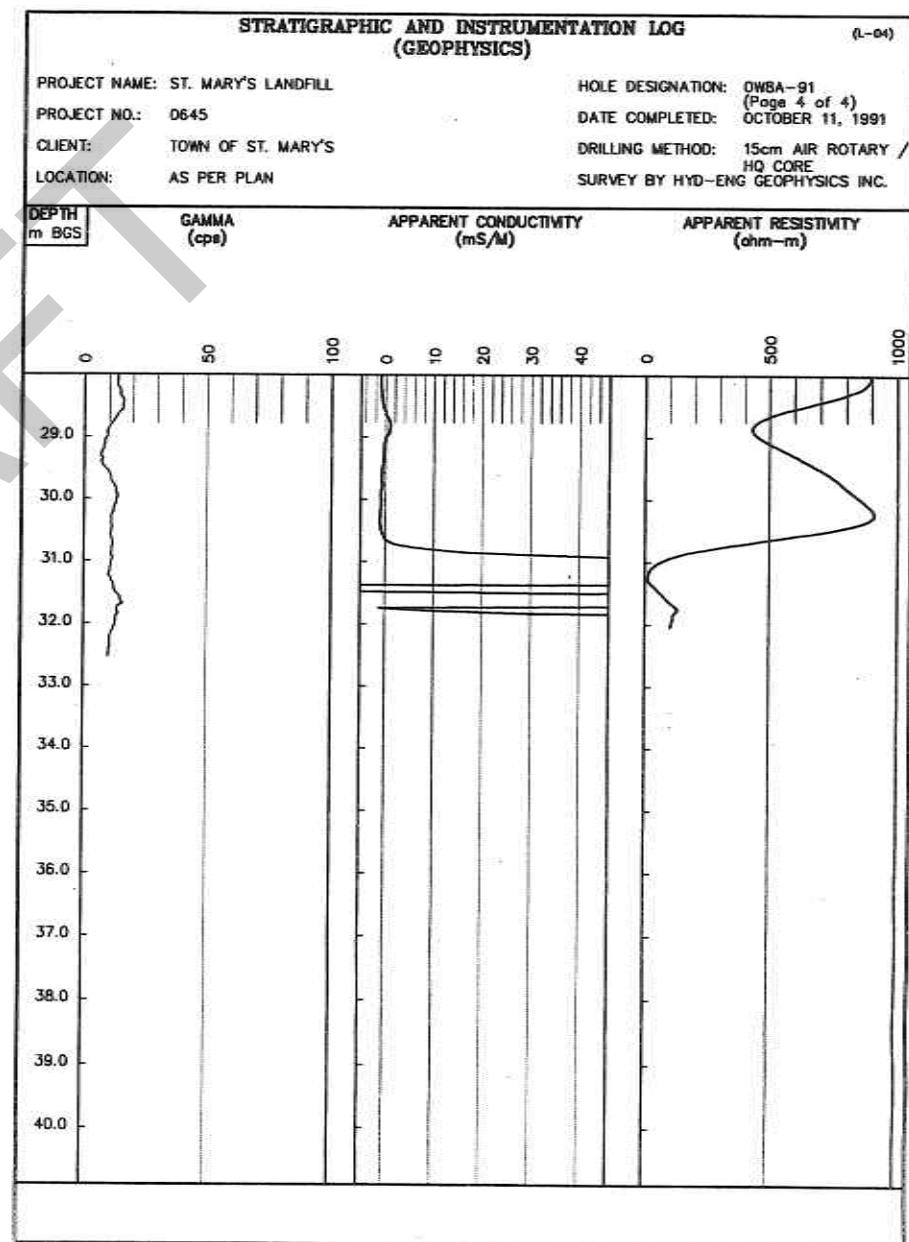NOTES: MEASURING POINT ELEVATIONS MAY CHANGE; REFER TO CURRENT ELEVATION TABLE
 ☒ WATER FOUND ☒ STATIC WATER LEVEL NM - NOT MEASURED




STRATIGRAPHIC AND INSTRUMENTATION LOG (OVERBURDEN)

(L-05)



PROJECT NAME: ST. MARY'S LANDFILL
 PROJECT NO.: 0645
 CLIENT: TOWN OF ST. MARY'S
 LOCATION: AS PER PLAN

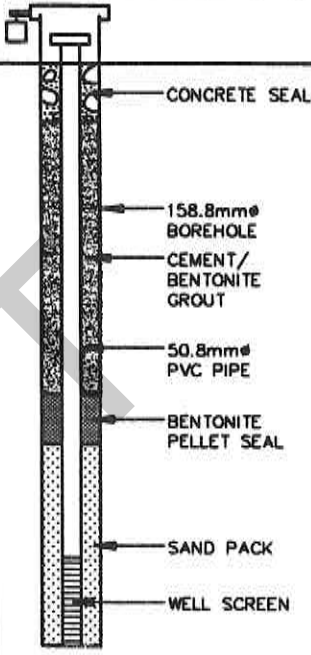HOLE DESIGNATION: OW8B-91
 DATE COMPLETED: OCTOBER 4, 1991
 DRILLING METHOD: 15cm AIR ROTARY
 CRA SUPERVISOR: J.C. MUGFORD

DEPTH m BGS	STRATIGRAPHIC DESCRIPTION & REMARKS	ELEVATION m AMSL	MONITOR INSTALLATION	SAMPLE		
				NUMBER	STATE	VALUE
	REFERENCE POINT (Top of Riser) GROUND SURFACE	314.690 313.72				
1.0	For stratigraphy from 0.0 to 5.49m BGS see log OW8A-91					
2.0						
3.0						
4.0						
5.0						
6.0	ML/CL-SILT(TILL), some clay, some sand, some stone, very hard, medium grey to brown, very damp	308.23 307.67		1SS	X	>100
7.0	END OF HOLE @ 6.05 m BGS. NOTES: 1. At completion borehole remained dry.					
8.0						
9.0						
10.0						
11.0						
12.0						
13.0						

SCREEN DETAILS:
 Screened Interval:
 5.13 to 6.05m BGS
 Length - 0.9m
 Diameter - 50.8mm
 Slot # 10
 Material - Stainless Steel
 Sand pack interval:
 3.96 to 6.05m BGS
 Material - # 3 Silica Sand

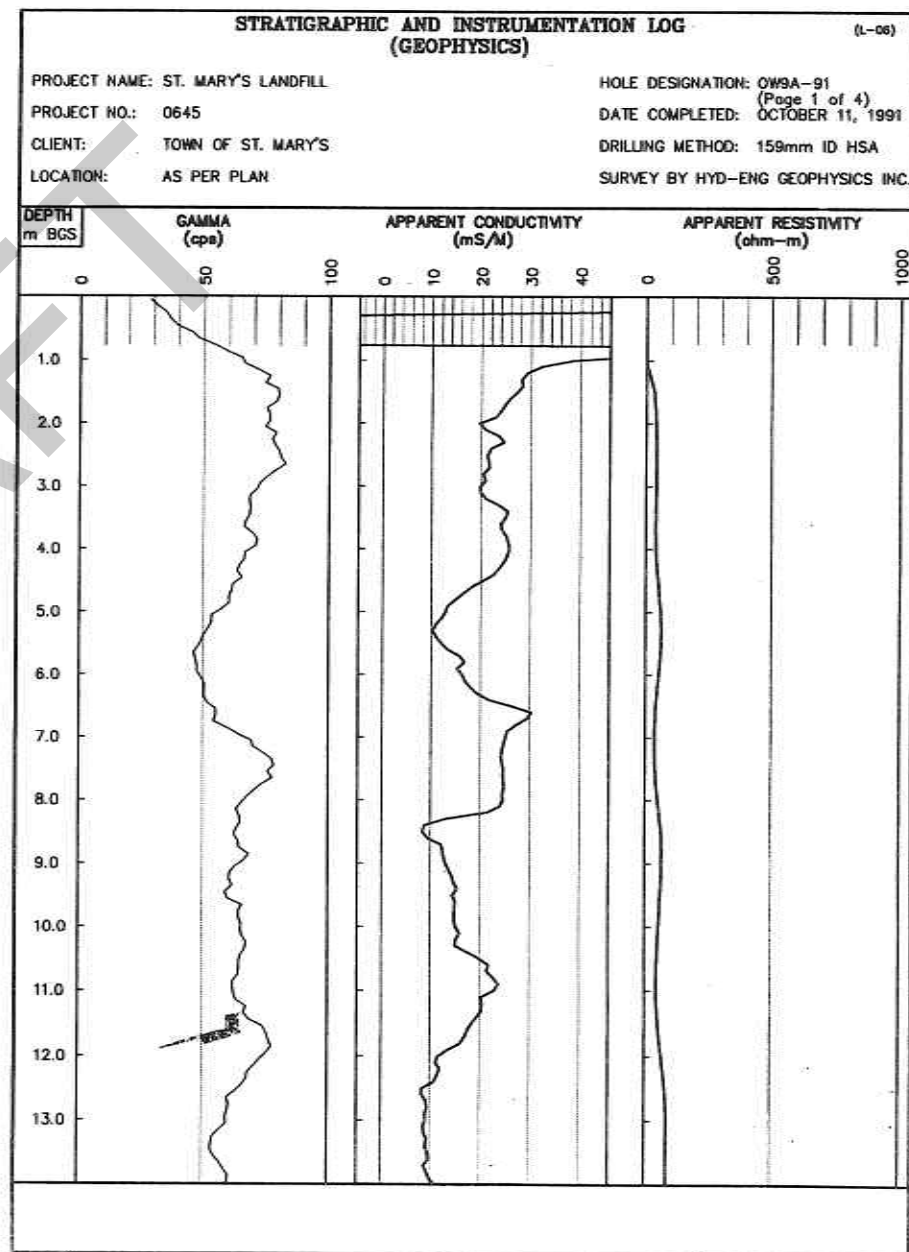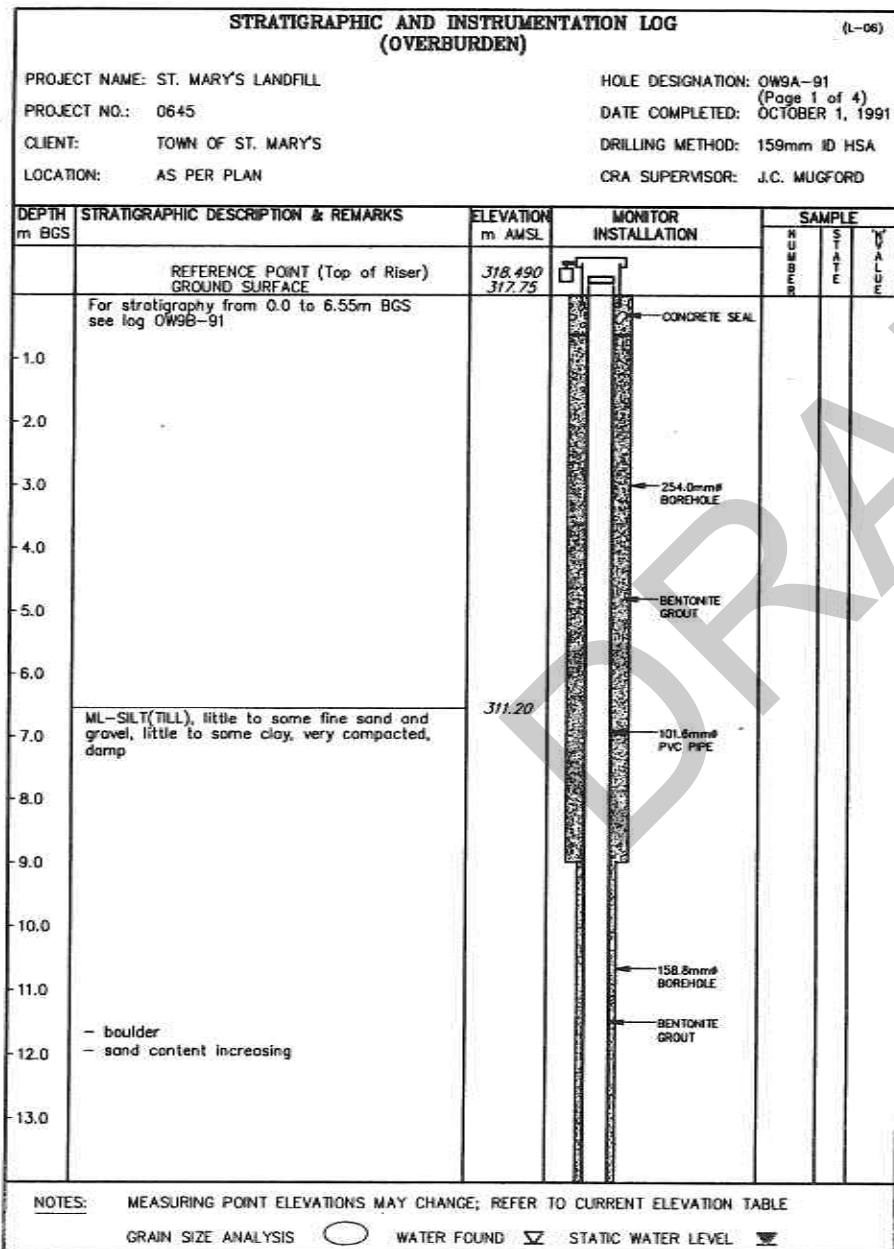
NOTES: MEASURING POINT ELEVATIONS MAY CHANGE; REFER TO CURRENT ELEVATION TABLE
 GRAIN SIZE ANALYSIS ○ WATER FOUND ∇ STATIC WATER LEVEL ▼



STRATIGRAPHIC AND INSTRUMENTATION LOG (BEDROCK) (L-07)									
PROJECT NAME: ST. MARY'S LANDFILL			HOLE DESIGNATION: OW9A-91 (Page 3 of 4)						
PROJECT NO.: 0645			DATE COMPLETED: OCTOBER 4, 1991						
CLIENT: TOWN OF ST. MARY'S			DRILLING METHOD: 15cm AIR ROTARY / HQ CORE						
LOCATION: AS PER PLAN			CRA SUPERVISOR: J.C. MUGFORD						
DEPTH	DESCRIPTION OF STRATA	ELEVATION	MONITOR INSTALLATION	BIENTRIERE OR CV KAL	RH NUMBER	RECOVERY	ROD	WRATTURR H	
m BGS		m AMSL				%	%	%	
21.0	Overburden								
22.0	LIMESTONE(Dundee Formation): cream/beige rock flour	296.41							
23.0			158.8mmφ BOREHOLE						
24.0	- light brown, softer		BENTONITE GROUT						
25.0			101.5mmφ PVC PIPE						
26.0									
27.0	LIMESTONE(Lucas Formation):	290.75							
28.0									
29.0									
30.0	- light brown argilloceous limestone, soft, damp		CAVE						
31.0									
32.0		285.54	SAND PACK						

NOTES: MEASURING POINT ELEVATIONS MAY CHANGE; REFER TO CURRENT ELEVATION TABLE.

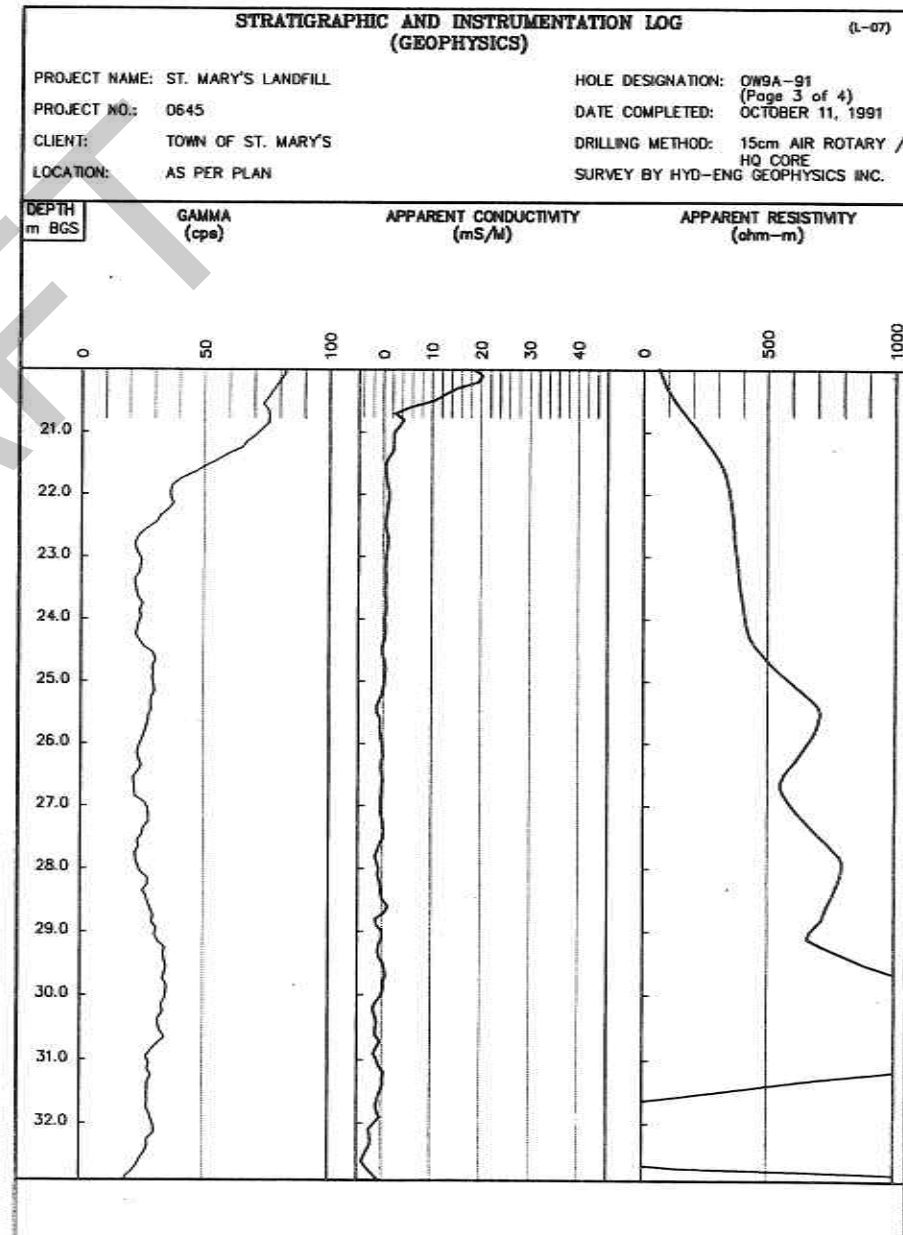
☒ WATER FOUND ☒ STATIC WATER LEVEL (OCT 26/91) NM - NOT MEASURED



STRATIGRAPHIC AND INSTRUMENTATION LOG (BEDROCK)		(L-07)						
PROJECT NAME: ST. MARY'S LANDFILL		HOLE DESIGNATION: OW9A-91 (Page 4 of 4)						
PROJECT NO.: 0645		DATE COMPLETED: OCTOBER 4, 1991						
CLIENT: TOWN OF ST. MARY'S		DRILLING METHOD: 15cm AIR ROTARY / HQ CORE						
LOCATION: AS PER PLAN		CRA SUPERVISOR: J.C. MUGFORD						
DEPTH	DESCRIPTION OF STRATA	ELEVATION	MONITOR INSTALLATION	BENTONITE OR CASUAL	RUN NUMBER	CORRECTION	ROD	WRETT RETURN
m BGS		m AMSL				%	%	%
33.0			158.3mm Ø BOREHOLE					
34.0			SAND PACK					
35.0								
36.0	- light brown to buff argillaceous limestone, medium to high porosity - lighter colored with slight color laminations							
37.0	- water bearing fracture (@ 36.58m BGS)							
38.0	- darker colored with high concentrations of stylolites				1	100	45	
38.0	- water bearing fracture (@ 38.25m BGS)							
38.0	- water bearing fracture (@ 38.40m BGS)							
39.0	- water bearing fracture (@ 38.86m BGS)							
39.0	- water bearing fracture (@ 39.17m BGS)							
39.0	- water bearing fracture (@ 39.47m BGS)							
40.0	END OF HOLE @ 40.39 m BGS.	277.36	WELL SCREEN					
41.0			SCREEN DETAILS: Screened Interval: 38.86 to 40.39m BGS Length -1.5m Diameter -50.8mm Slot # 10 Material -Stainless Steel					
42.0			Sand pack interval: 37.19 to 40.39m BGS Material -# 3 Silica Sand					
43.0								
44.0								

NOTES: MEASURING POINT ELEVATIONS MAY CHANGE; REFER TO CURRENT ELEVATION TABLE

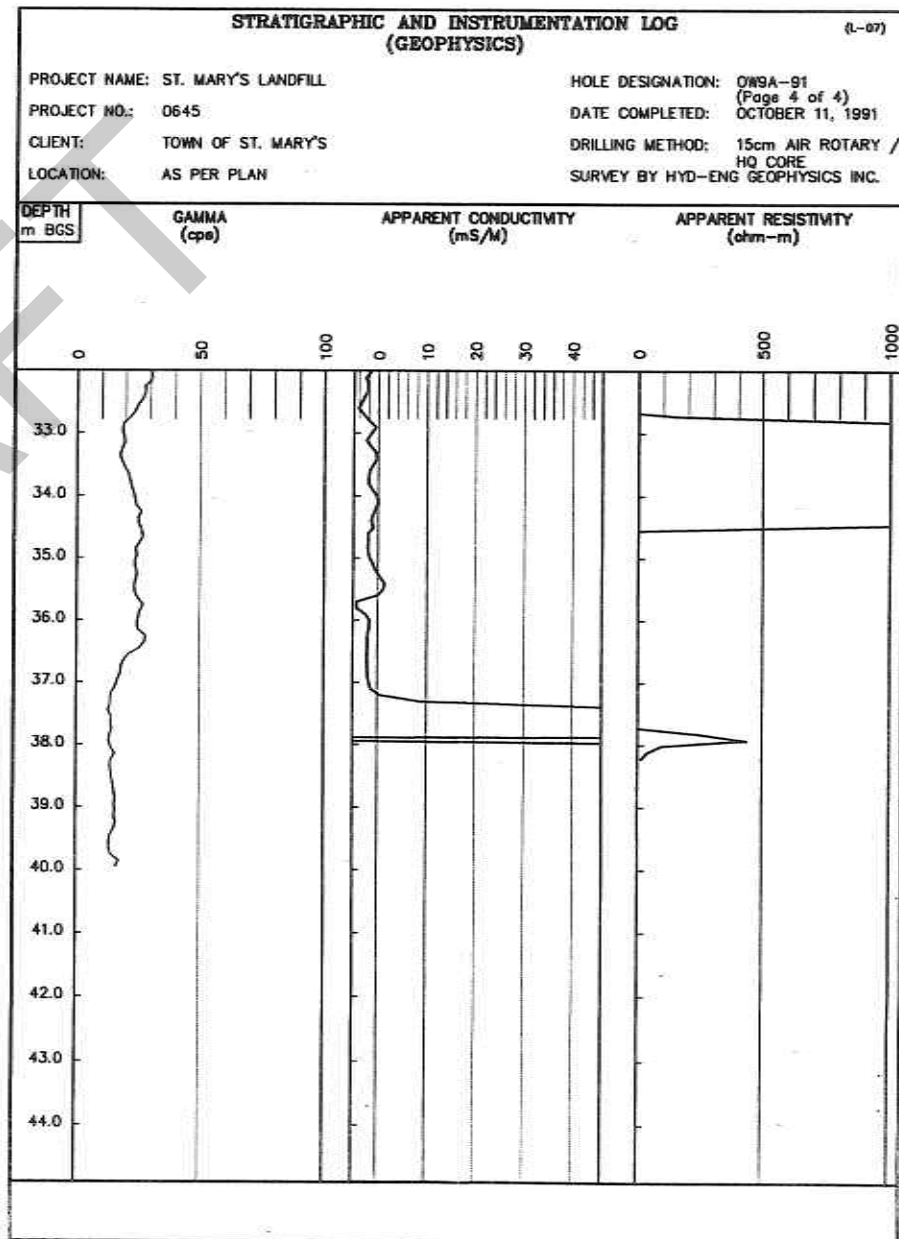☒ WATER FOUND ☒ STATIC WATER LEVEL NM - NOT MEASURED



STRATIGRAPHIC AND INSTRUMENTATION LOG (OVERBURDEN)

(L-08)

PROJECT NAME: ST. MARY'S LANDFILL

HOLE DESIGNATION: OW9B-91

PROJECT NO.: 0645

DATE COMPLETED: OCTOBER 1, 1991

CLIENT: TOWN OF ST. MARY'S

DRILLING METHOD: 108mm ID HSA

LOCATION: AS PER PLAN

CRA SUPERVISOR: J.C. MUGFORD

DEPTH m BGS	STRATIGRAPHIC DESCRIPTION & REMARKS	ELEVATION m AMSL	MONITOR INSTALLATION	SAMPLE			
				NUMBER	STATE	VALUE	
	REFERENCE POINT (Top of Riser) GROUND SURFACE	318.580 317.74					
1.0	ML/CL-SILT(TILL), some clay, some sand and small pebbles, rootlets, stiff to hard, well fractured, grey to brown, damp to moist - well developed sub-vertical fracture (0.3 to 0.45m BGS) - hard, some pebbles (small to large), no obvious fracturing			CONCRETE SEAL	1CS	X	
2.0				203.2mm ϕ BOREHOLE	2CS	X	
3.0				BENTONITE GROUT		X	
4.0		314.13		50.8mm ϕ PVC PIPE	3CS	X	
5.0				BENTONITE PELLET SEAL	4CS	X	
6.0	GM-GRAVEL, fine to medium grained, some sand, silt and stones, few cobbles, saturated	312.56		SAND PACK	5CS	X	
7.0	ML-SILT(TILL), little to some fine grained sand and fine gravel, little clay, very compacted, damp to moist - trace fine grained sand, trace clay, extremely dense, non-plastic, laminated, light grey and brown, damp	311.64		WELL SCREEN	6SS	X	>100
8.0	END OF HOLE @ 6.55 m BGS.	311.19					
9.0							
10.0							
11.0							
12.0							
13.0							

SCREEN DETAILS:
 Screened Interval: 5.18 to 6.10m BGS
 Length - 0.9m
 Diameter - 50.8mm
 Slot # 10
 Material - Stainless Steel
 Sand pack interval: 4.57 to 6.55m BGS
 Material - # 3 Silica Sand

NOTES: MEASURING POINT ELEVATIONS MAY CHANGE; REFER TO CURRENT ELEVATION TABLE

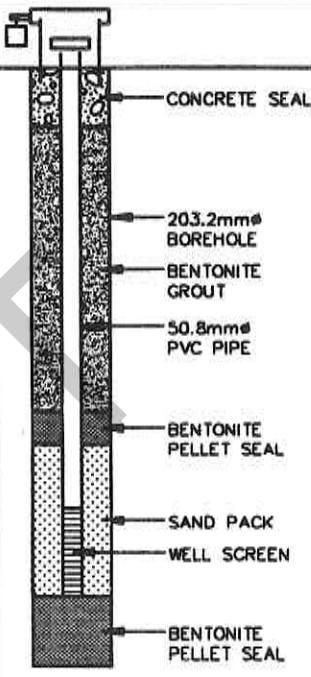
GRAIN SIZE ANALYSIS WATER FOUND STATIC WATER LEVEL (OCT 26, 1991)

STRATIGRAPHIC AND INSTRUMENTATION LOG (OVERBURDEN)

(L-14)

PROJECT NAME: ST. MARY'S LANDFILL
 PROJECT NO.: 0645
 CLIENT: TOWN OF ST. MARY'S
 LOCATION: AS PER PLAN

HOLE DESIGNATION: OW15-91
 DATE COMPLETED: OCTOBER 21, 1991
 DRILLING METHOD: 108mm ID HSA
 CRA SUPERVISOR: J.C. MUGFORD

DEPTH m BGS	STRATIGRAPHIC DESCRIPTION & REMARKS	ELEVATION m AMSL	MONITOR INSTALLATION	SAMPLE			
				NUMBER	STATE	VALUE	
	REFERENCE POINT (Top of Riser) GROUND SURFACE	318.670 317.82	 <p style="font-size: small;">CONCRETE SEAL 203.2mmϕ BOREHOLE BENTONITE GROUT 50.8mmϕ PVC PIPE BENTONITE PELLET SEAL SAND PACK WELL SCREEN BENTONITE PELLET SEAL</p> <p>SCREEN DETAILS: Screened Interval: 4.57 to 5.49m BGS Length -0.9m Diameter -50.8mm Slot # 10 Material -Stainless Steel Sand pack interval: 3.91 to 5.49m BGS Material -# 3 Silica Sand</p>				
1.0	ML/CL-SILT(TILL), some clay and sand, damp to moist						
2.0							
3.0		314.77					
4.0	ML-SILT(TILL), some clay and sand, trace gravel, slightly layered, firm, light brown, damp to moist	314.13			(1CS) (3.5 - 4.6m)	X	
5.0	ML/CL-SILT and CLAY(GLACIOLACUSTRINE), trace gravel, little very fine sand, layered, tan, moist	313.25					
6.0	SW/GW-SAND and GRAVEL, medium to coarse, some cobbles, salt and pepper color, saturated	312.03			(2CS) (4.6 - 5.8m)	X	
7.0	ML-SILT(TILL), some clay and sand, cobbles, dense, light brown, moist	311.62			(3CS)	X	
8.0	END OF HOLE @ 6.20 m BGS.				4CS	X	
9.0							
10.0							
11.0							
12.0							
13.0							

NOTES: MEASURING POINT ELEVATIONS MAY CHANGE; REFER TO CURRENT ELEVATION TABLE

GRAIN SIZE ANALYSIS ○ WATER FOUND ▽ STATIC WATER LEVEL ▼

STRATIGRAPHIC AND INSTRUMENTATION LOG (OVERBURDEN)

(L-16)

PROJECT NAME: ST. MARY'S LANDFILL
 PROJECT NO.: 0645
 CLIENT: TOWN OF ST. MARY'S
 LOCATION: AS PER PLAN

HOLE DESIGNATION: OW17-91
 DATE COMPLETED: NOVEMBER 16, 1991
 DRILLING METHOD: 95mm ID HSA
 CRA SUPERVISOR: J.C. MUGFORD

DEPTH m BGS	STRATIGRAPHIC DESCRIPTION & REMARKS	ELEVATION m AMSL	MONITOR INSTALLATION	SAMPLE		
				NUMBER	STATE	N'V VALUE
	REFERENCE ELEVATION (Top of Riser) GROUND SURFACE	318.39 317.39				
1.0	ML/CL-SILT(TILL), some clay, little sand, little gravel, few cobbles, very stiff, grey, damp - very cobbly			(1CS)	X	
2.0				2CS	X	
3.0		314.26				
		314.04				
4.0	ML/SM-SILT and SAND, very fine grained, compact, brown, saturated SW-SAND, little fine gravel, coarse grained, well graded, compact, brown, saturated	313.73		3SS	X	26
5.0	ML/CL-SILT(TILL), some clay, little sand and gravel, stiff, grey, moist - sand and gravel seams, wet (4.88 to 4.98m BGS and 5.08 to 5.13m BGS)	313.07		4SS	X	20
6.0	ML-SILT(TILL), some sand, little to some clay, little gravel, very hard, light brown, damp - sand seam, wet (5.49 to 5.59m BGS)	311.90		5SS	X	41
7.0				6SS	X	>60
8.0				7SS	X	53
9.0				8SS	X	53
10.0				9SS	X	58
11.0				10SS	X	>50
12.0			11SS	X	>70	
13.0	END OF HOLE @ 9.45 m BGS.	307.94				

SCREEN DETAILS:
 Screened Interval:
 2.74 to 5.79m BGS
 Length - 3.0m
 Diameter - 50.8mm
 Slot # 10
 Material - PVC
 Sand pack interval:
 2.34 to 6.05m BGS
 Material - # 2 Filter

NOTES: MEASURING POINT ELEVATIONS MAY CHANGE; REFER TO CURRENT ELEVATION TABLE

GRAIN SIZE ANALYSIS ○ WATER FOUND ∇ STATIC WATER LEVEL ▼ (NOV 22, 1991)

STRATIGRAPHIC AND INSTRUMENTATION LOG (OVERBURDEN)

(L-20)

PROJECT NAME: ST. MARY'S LANDFILL
 PROJECT NO.: 0645
 CLIENT: TOWN OF ST. MARY'S
 LOCATION: AS PER PLAN

HOLE DESIGNATION: OW21-91
 DATE COMPLETED: DECEMBER 9, 1991
 DRILLING METHOD: 95mm ID HSA
 CRA SUPERVISOR: J.C. MUGFORD

DEPTH m BGS	STRATIGRAPHIC DESCRIPTION & REMARKS	ELEVATION m AMSL	MONITOR INSTALLATION	SAMPLE			
				NUMBER	STATE	VALUE	
	REFERENCE POINT (Top of Riser) GROUND SURFACE	320.760 319.99					
-1.0	ML-SILT(TILL), little to some clay and sand, trace gravel, damp - hard, moist to wet						
-2.0	- damp			317.53			
-3.0							
-4.0	- very hard, damp						
-5.0					1SS	X	68
-6.0	ML/CL-SILT and CLAY (GLACIOLACUSTRINE), little sand and fine gravel, damp - little to some clay and fine sand, extremely dense, non-cohesive, tan, damp, layered - moist	314.61			2SS	X	71
-7.0	- some sand and clay, little fine gravel, very hard, brown, damp				3SS	X	>100
-8.0	ML-SILT and SAND(TILL), little clay, little gravel, extremely hard, light brown to grey, damp to moist END OF HOLE @ 7.70 m BGS.	312.92			4SS	X	93
-9.0		312.29			5SS	X	>100
-10.0							
-11.0							
-12.0							
-13.0							

SCREEN DETAILS:
 Screened Interval:
 6.17 to 7.70m BGS
 Length -1.5m
 Diameter -50.8mm
 Slot # 10
 Material -Stainless Steel
 Sand pack interval:
 5.33 to 7.70m BGS
 Material -# 2 Filter

NOTES: MEASURING POINT ELEVATIONS MAY CHANGE; REFER TO CURRENT ELEVATION TABLE

GRAIN SIZE ANALYSIS WATER FOUND STATIC WATER LEVEL (DEC 12, 1991)

STRATIGRAPHIC AND INSTRUMENTATION LOG (OVERBURDEN)

(L-24)

PROJECT NAME: ST. MARY'S LANDFILL
 PROJECT NO.: 0645
 CLIENT: TOWN OF ST. MARY'S
 LOCATION: AS PER PLAN

HOLE DESIGNATION: OW25-91
 DATE COMPLETED: DECEMBER 11, 1991
 DRILLING METHOD: 95mm ID HSA
 CRA SUPERVISOR: J.C. MUGFORD

DEPTH m BGS	STRATIGRAPHIC DESCRIPTION & REMARKS	ELEVATION m AMSL	MONITOR INSTALLATION	SAMPLE			
				NUMBER	STATE	VALUE	
	REFERENCE POINT (Top of Riser) GROUND SURFACE	323.420 322.86					
1.0	OL-SILT(TOPSOIL), little sand and clay, organics, black, moist	322.25					
2.0	ML/CL-SILT, some clay, little to some sand, stiff, light brown, moist, cohesive				1AR		
3.0	- hard, grey-brown						
4.0					2AR		
5.0	- stone						
6.0					3AR		
7.0					4SS		41
8.0	SP-SAND, trace silt and fine gravel, fine to medium grained fining upwards, very dense, salt and pepper colour, dry - silt and clay layer (2cm thick) - medium grained, wet	315.54 314.35			5SS		50
9.0	GW-GRAVEL, some sand and silt, fine, wet	313.93			6SS		37
10.0	ML-SILT, some sand, little to some clay, few large pebbles, very stiff, light grey-brown, moist to wet - gravel seam (5cm thick)	313.50			7SS		28
11.0	END OF HOLE @ 10.36 m BGS.	312.50			8SS		49

SCREEN DETAILS:
 Screened Interval:
 8.84 to 9.75m BGS
 Length - 0.9m
 Diameter - 50.8mm
 Slot # 10
 Material - Stainless Steel
 Sand pack interval:
 7.01 to 10.36m BGS
 Material - # 2 Filter

NOTES: MEASURING POINT ELEVATIONS MAY CHANGE; REFER TO CURRENT ELEVATION TABLE







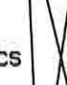

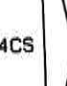
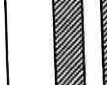

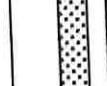
GRAIN SIZE ANALYSIS ○ WATER FOUND ▽ STATIC WATER LEVEL ▽ (DEC 13, 1991)

STRATIGRAPHIC AND INSTRUMENTATION LOG (OVERBURDEN)

(WL-01)
Page 1 of 2

PROJECT NAME: ST. MARYS LANDFILL
PROJECT NUMBER: 0645
CLIENT: TOWN OF ST. MARYS
LOCATION: AS PER PLAN

HOLE DESIGNATION: OW32-96
DATE COMPLETED: AUGUST 7, 1996
DRILLING METHOD: 108mm ID HSA
CRA SUPERVISOR: J. MUGFORD

DEPTH m BGS	STRATIGRAPHIC DESCRIPTION & REMARKS	ELEV. m AMSL	MONITOR INSTALLATION	SAMPLE			
				NUMBER	STATE	"N" VALUE	PID (ppm)
	REFERENCE POINT (Top of Riser) GROUND SURFACE	323.43 322.54					
-0.5	ML-SILT (FILL), little sand and clay, trace gravel, brown, damp - light and dark grey			CONCRETE SEAL	1CS		
-1.0		321.47 321.32					
-1.5	ML-SILT (BURIED TOPSOIL), little sand and clay, little vegetal matter, dark brown, moist ML-SILT (TILL), little sand and clay, firm, some fine fracturing, highly mottled light grey and brown			203mm Ø BOREHOLE	2CS		
-2.0	- some fine sand, wet (2.0 to 2.3m BGS)						
-2.5	- little coarse sand and fine gravel, stiff, slightly mottled, moist to wet - little gravel, hard augering, light brown, moist						
-3.0				BENTONITE GROUT	3CS		
-3.5	- becoming grey, moist						
-4.0	- grey, damp to moist						
-4.5				51mm Ø PVC PIPE	4CS		
-5.0	- massive						
-5.5				BENTONITE GRAVEL	5CS		
-6.0	- boulder						
-6.5				SAND PACK			

NOTES: MEASURING POINT ELEVATIONS MAY CHANGE; REFER TO CURRENT ELEVATION TABLE
WATER FOUND ▼ STATIC WATER LEVEL ▼

PROJECT NAME: ST. MARYS LANDFILL
 PROJECT NUMBER: 0645
 CLIENT: TOWN OF ST. MARYS
 LOCATION: AS PER PLAN

HOLE DESIGNATION: OW32-96
 DATE COMPLETED: AUGUST 7, 1996
 DRILLING METHOD: 108mm ID HSA
 CRA SUPERVISOR: J. MUGFORD

DEPTH m BGS	STRATIGRAPHIC DESCRIPTION & REMARKS	ELEV. m AMSL	MONITOR INSTALLATION	SAMPLE				
				NUMBER	STATE	'N' VALUE	PID (ppm)	
-7.5	ML-SILT (WATER LAID TILL), trace to little fine sand, trace clay, slightly stratified, light grey, damp to moist	315.38	<p>SAND PACK</p> <p>51mm Ø PVC PIPE</p> <p>203mm Ø BOREHOLE</p> <p>WELL SCREEN</p>	6CS				
-8.0								
-8.5								
-9.0	ML-SILT (TILL), little sand, gravel and clay, massive, grey-brown, moist	313.85			7CS			
-9.5								
-10.0								
-10.5	- seams of wet sand and silt @ 10.36 to 10.59 and 10.92 to 10.97m BGS				8CS			
-11.0	- massive till							
-11.5	END OF HOLE @ 11.58m BGS	310.96			9CS			
-12.0								
-12.5								
-13.0								
-13.5								

SCREEN DETAILS
 Screened Interval:
 9.91 to 11.43m BGS
 Length: 1.52m
 Diameter: 51mm
 Slot Size: #10
 Material: PVC
 Sand Pack:
 6.10 to 11.58m BGS
 Material: #1 Silica Sand



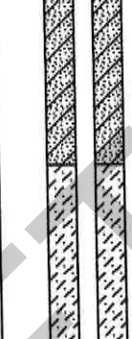
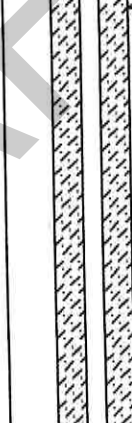
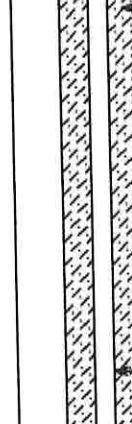
NOTES: MEASURING POINT ELEVATIONS MAY CHANGE; REFER TO CURRENT ELEVATION TABLE
 WATER FOUND ▼ STATIC WATER LEVEL ▼

STRATIGRAPHIC AND INSTRUMENTATION LOG (OVERBURDEN)

(WL-02)
Page 1 of 3

PROJECT NAME: ST. MARYS LANDFILL
PROJECT NUMBER: 0645
CLIENT: TOWN OF ST. MARYS
LOCATION: AS PER PLAN

HOLE DESIGNATION: OW33-96
DATE COMPLETED: AUGUST 8, 1996
DRILLING METHOD: 108mm ID HSA
CRA SUPERVISOR: J. MUGFORD

DEPTH m BGS	STRATIGRAPHIC DESCRIPTION & REMARKS	ELEV. m AMSL	MONITOR INSTALLATION	SAMPLE			
				NUMBER	STATE	'N' VALUE	PID (ppm)
	REFERENCE POINT (Top of Riser) GROUND SURFACE	321.57 320.66					
	ML-SILT (TOPSOIL), little sand, little vegetal matter, dark brown, moist						
-0.5	ML-SILT (TILL), little sand, trace gravel and clay, firm, light brown, damp to moist	320.36		1CS	X		
-1.0	- massive				X		
-1.5					X		
-2.0	- stone			2CS	X		
-2.5	- moist				X		
-3.0	- hard, damp				X		
-3.5					X		
-4.0	- massive, grey, damp to moist			3CS	X		
-4.5					X		
-5.0	- 25mm seam of wet sand, silt and gravel @ 5.03m BGS - slightly stratified below 5.03m BGS			4CS	X		
-5.5					X		
-6.0	- highly stratified - wet (dilatant) outwash silts			5CS	X		
-6.5	- massive, very hard, grey, damp to moist				X		

NOTES: MEASURING POINT ELEVATIONS MAY CHANGE; REFER TO CURRENT ELEVATION TABLE
WATER FOUND ∇ STATIC WATER LEVEL ∇

STRATIGRAPHIC AND INSTRUMENTATION LOG (OVERBURDEN)

PROJECT NAME: ST. MARYS LANDFILL
PROJECT NUMBER: 0645
CLIENT: TOWN OF ST. MARYS
LOCATION: AS PER PLAN

HOLE DESIGNATION: OW33-96
DATE COMPLETED: AUGUST 8, 1996
DRILLING METHOD: 108mm ID HSA
CRA SUPERVISOR: J. MUGFORD

DEPTH m BGS	STRATIGRAPHIC DESCRIPTION & REMARKS	ELEV. m AMSL	MONITOR INSTALLATION	SAMPLE			
				NUMBER	STATE	'N' VALUE	PID (ppm)
-7.5			BENTONITE GROUT	5CS	X		
-8.0			51mm Ø PVC PIPE	6CS	X		
-8.5	- sand and gravel, some silt, wet 8.61 to 8.71m BGS						
-9.0	- till with little gravel, damp to moist - cobbles @ 8.84, 9.14, 9.45 and 9.75m BGS		BENTONITE GRAVEL	7CS	X		
-9.5							
-10.0	- very moist		203mm Ø BOREHOLE				
-10.5	- hard, dry						
-11.0				8CS	X		
-11.5	- damp to moist		SAND PACK				
-12.0							
-12.5	- layers of silt, sand and clay - very moist to wet (12.70 to 12.75m BGS)		WELL SCREEN	9CS	X		
-13.0	- dry						
-13.5	- some sand, hard, brown, damp to moist Refusal	307.10		10CS	X		
	END OF HOLE @ 13.56m BGS						

NOTES: MEASURING POINT ELEVATIONS MAY CHANGE; REFER TO CURRENT ELEVATION TABLE
WATER FOUND ∇ STATIC WATER LEVEL ∇

STRATIGRAPHIC AND INSTRUMENTATION LOG (OVERBURDEN)

PROJECT NAME: ST. MARYS LANDFILL
 PROJECT NUMBER: 0645
 CLIENT: TOWN OF ST. MARYS
 LOCATION: AS PER PLAN

HOLE DESIGNATION: OW33-96
 DATE COMPLETED: AUGUST 8, 1996
 DRILLING METHOD: 108mm ID HSA
 CRA SUPERVISOR: J. MUGFORD

DEPTH m BGS	STRATIGRAPHIC DESCRIPTION & REMARKS	ELEV. m AMSL	MONITOR INSTALLATION	SAMPLE			
				NUMBER	STATE	"N" VALUE	PID (ppm)
-14.5 -15.0 -15.5 -16.0 -16.5 -17.0 -17.5 -18.0 -18.5 -19.0 -19.5 -20.0 -20.5			<p>SCREEN DETAILS Screened Interval: 11.89 to 13.41m BGS Length: 1.52m Diameter: 51mm Slot Size: #10 Material: PVC Sand Pack: 0.85 to 13.56m BGS Material: #1 Silica Sand</p>				





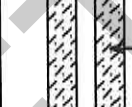
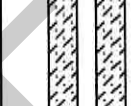
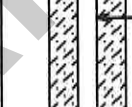
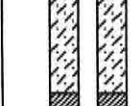

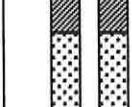
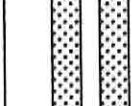
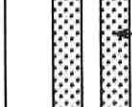
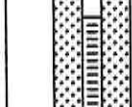

NOTES: MEASURING POINT ELEVATIONS MAY CHANGE; REFER TO CURRENT ELEVATION TABLE
 WATER FOUND ▼ STATIC WATER LEVEL ▼

STRATIGRAPHIC AND INSTRUMENTATION LOG (OVERBURDEN)

(WL-03)
Page 1 of 2

PROJECT NAME: ST. MARYS LANDFILL
PROJECT NUMBER: 0645
CLIENT: TOWN OF ST. MARYS
LOCATION: AS PER PLAN

HOLE DESIGNATION: OW34-96
DATE COMPLETED: AUGUST 9, 1996
DRILLING METHOD: 108mm ID HSA
CRA SUPERVISOR: J. MUGFORD

DEPTH m BGS	STRATIGRAPHIC DESCRIPTION & REMARKS	ELEV. m AMSL	MONITOR INSTALLATION	SAMPLE			
				NUMBER	STATE	"N" VALUE	PID (ppm)
	REFERENCE POINT (Top of Riser) GROUND SURFACE	321.59 320.77					
	Refer to OW33-96 for stratigraphic details.						
-0.5							
-1.0							
-1.5							
-2.0							
-2.5							
-3.0							
-3.5							
-4.0							
-4.5							
-5.0							
-5.5							
-6.0							
-6.5							

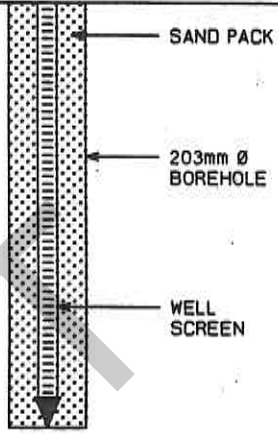
NOTES: MEASURING POINT ELEVATIONS MAY CHANGE; REFER TO CURRENT ELEVATION TABLE
WATER FOUND ∇ STATIC WATER LEVEL ∇

STRATIGRAPHIC AND INSTRUMENTATION LOG (OVERBURDEN)

(WL-03)
Page 2 of 2

PROJECT NAME: ST. MARYS LANDFILL
PROJECT NUMBER: 0645
CLIENT: TOWN OF ST. MARYS
LOCATION: AS PER PLAN

HOLE DESIGNATION: OW34-96
DATE COMPLETED: AUGUST 9, 1996
DRILLING METHOD: 108mm ID HSA
CRA SUPERVISOR: J. MUGFORD

DEPTH m BGS	STRATIGRAPHIC DESCRIPTION & REMARKS	ELEV. m AMSL	MONITOR INSTALLATION	SAMPLE			
				NUMBER	STATE	"N" VALUE	PID (ppm)
-7.5							
-8.0	ML-SILT (TILL), little sand, clay and gravel, trace cobbles, very hard, massive, brown, damp to moist	313.15	 <p style="margin-left: 20px;">SAND PACK</p> <p style="margin-left: 20px;">203mm Ø BOREHOLE</p> <p style="margin-left: 20px;">WELL SCREEN</p>				
-8.5	- dry to damp - wet			ICS			
-9.0				2CS			
-9.5	END OF HOLE @ 9.14m BGS	311.63					
-10.0			<p>SCREEN DETAILS</p> <p>Screened Interval: 5.94 to 8.99m BGS Length: 3.05m Diameter: 51mm Slot Size: #10 Material: PVC Sand Pack: 4.42 to 9.14m BGS Material: #1 Silica Sand</p>				
-10.5							
-11.0							
-11.5							
-12.0							
-12.5							
-13.0							
-13.5							

NOTES: MEASURING POINT ELEVATIONS MAY CHANGE; REFER TO CURRENT ELEVATION TABLE
WATER FOUND ▼ STATIC WATER LEVEL ▼



STRATIGRAPHIC AND INSTRUMENTATION LOG (OVERBURDEN)

PROJECT NAME: St. Marys Landfill
 PROJECT NUMBER: 645
 CLIENT: Town of St. Marys
 LOCATION: Town of St. Marys

HOLE DESIGNATION: MW32A-02
 DATE COMPLETED: September 17, 2002
 DRILLING METHOD: MUD ROTARY
 FIELD PERSONNEL: B. KEMPEL

DEPTH m BGS	STRATIGRAPHIC DESCRIPTION & REMARKS	ELEV. m	MONITOR INSTALLATION	SAMPLE				
				NUMBER	INTERVAL	REC (%)	N' VALUE	
	TOP OF RISER GROUND SURFACE	322.640 322.09						
0.5	TOPSOIL ML - SILT (TILL), trace to with sand, trace to with clay, mottled grey and brown	321.93	<p style="text-align: right; margin-right: 50px;">152 mm Ø BOREHOLE</p> <p style="text-align: right; margin-right: 50px;">102 mm Ø STEEL WELL CASING</p> <p style="text-align: right; margin-right: 50px;">CEMENT GROUT</p> <p style="text-align: right; margin-right: 50px;">51 mm Ø SCH 40 PVC RISER PIPE</p> <p style="text-align: right; margin-right: 50px;">BENTONITE GROUT</p>					
1.0								
1.5								
2.0								
2.5								
3.0								
3.5								
4.0	- grey at 3.66m BGS							
4.5								
5.0								
5.5								
6.0								
6.5								
7.0								
7.5								
8.0								
8.5								
9.0								
9.5								

NOTES: MEASURING POINT ELEVATIONS MAY CHANGE; REFER TO CURRENT ELEVATION TABLE

OVERBURDEN LOG MW32A.GPJ CRA_CORP.GDT 6/13/03



STRATIGRAPHIC AND INSTRUMENTATION LOG (OVERBURDEN)

PROJECT NAME: St. Marys Landfill
 PROJECT NUMBER: 645
 CLIENT: Town of St. Marys
 LOCATION: Town of St. Marys

HOLE DESIGNATION: MW32A-02
 DATE COMPLETED: September 17, 2002
 DRILLING METHOD: MUD ROTARY
 FIELD PERSONNEL: B. KEMPEL

DEPTH m BGS	STRATIGRAPHIC DESCRIPTION & REMARKS	ELEV. m	MONITOR INSTALLATION	SAMPLE					
				NUMBER	INTERVAL	REC (%)	'N' VALUE		
10.5 11.0 11.5 12.0 12.5 13.0 13.5 14.0 14.5 15.0 15.5 16.0 16.5 17.0 17.5 18.0 18.5 19.0 19.5									

DRAFT

OVERBURDEN LOG MW32A.GPJ CRA_CORP.GDT 6/13/03

NOTES: MEASURING POINT ELEVATIONS MAY CHANGE; REFER TO CURRENT ELEVATION TABLE



STRATIGRAPHIC AND INSTRUMENTATION LOG (OVERBURDEN)

PROJECT NAME: St. Marys Landfill
 PROJECT NUMBER: 645
 CLIENT: Town of St. Marys
 LOCATION: Town of St. Marys

HOLE DESIGNATION: MW32A-02
 DATE COMPLETED: September 17, 2002
 DRILLING METHOD: MUD ROTARY
 FIELD PERSONNEL: B. KEMPEL

DEPTH m BGS	STRATIGRAPHIC DESCRIPTION & REMARKS	ELEV. m	MONITOR INSTALLATION	SAMPLE				
				NUMBER	INTERVAL	REC (%)	'N' VALUE	
20.5 21.0 21.5 22.0 22.5 23.0 23.5 24.0 24.5 25.0 25.5 26.0 26.5 27.0 27.5 28.0 28.5 29.0 29.5	<p>- with cobbles at 23.77m BGS</p> <p>- 2' thick quartz boulder at 24.69m BGS</p> <p style="text-align: center;">END OF OVERBURDEN HOLE @ 27.74m BGS</p>		<p style="font-size: small;">152 mm Ø BOREHOLE</p> <p style="font-size: small;">102 mm Ø STEEL WELL CASING</p> <p style="font-size: small;">CEMENT GROUT</p> <p style="font-size: small;">51 mm Ø SCH 40 PVC RISER PIPE</p> <p style="font-size: small;">102 mm Ø BOREHOLE</p> <p style="font-size: small;">BENTONITE GROUT</p>					

NOTES: MEASURING POINT ELEVATIONS MAY CHANGE; REFER TO CURRENT ELEVATION TABLE

OVERBURDEN LOG MW32A.GPJ CRA_CORP.GDT 6/13/03



STRATIGRAPHIC AND INSTRUMENTATION LOG (BEDROCK)

PROJECT NAME: St. Marys Landfill

HOLE DESIGNATION: MW32A-02

PROJECT NUMBER: 645

DATE COMPLETED: September 17, 2002

CLIENT: Town of St. Marys

DRILLING METHOD: MUD ROTARY

LOCATION: Town of St. Marys

FIELD PERSONNEL: B. KEMPEL

DEPTH m BGS	STRATIGRAPHIC DESCRIPTION & REMARKS	ELEV. m	MONITOR INSTALLATION	RUN NUMBER	CORE RECOVERY %	ROD %
<div style="font-size: small; transform: rotate(-90deg); position: absolute; left: -40px; top: 50%; transform: translateY(-50%);"> BEDROCK LOG MW32A.GPJ CRA_CORP.GDT 6/13/03 </div>	<p>BEDROCK - LIMESTONE (Dundee Formation), light brown, competent</p>	<p>294.35</p>	<p style="text-align: right;">BENTONITE GROUT</p> <p style="text-align: right;">102 mm Ø BOREHOLE</p> <p style="text-align: right;">51 mm Ø SCH 40 PVC RISER PIPE</p> <p style="text-align: right;">BENTONITE HOLEPLUG</p>	<p>1</p> <p>2</p> <p>3</p>		

NOTES: MEASURING POINT ELEVATIONS MAY CHANGE; REFER TO CURRENT ELEVATION TABLE



STRATIGRAPHIC AND INSTRUMENTATION LOG (BEDROCK)

PROJECT NAME: St. Marys Landfill
 PROJECT NUMBER: 645
 CLIENT: Town of St. Marys
 LOCATION: Town of St. Marys

HOLE DESIGNATION: MW32A-02
 DATE COMPLETED: September 17, 2002
 DRILLING METHOD: MUD ROTARY
 FIELD PERSONNEL: B. KEMPEL

DEPTH m BGS	STRATIGRAPHIC DESCRIPTION & REMARKS	ELEV. m	MONITOR INSTALLATION	RUN NUMBER	CORE RECOVERY %	ROD %
37.5 38.0 38.5 39.0 39.5 40.0 40.5 41.0 41.5 42.0 42.5 43.0 43.5 44.0 44.5 45.0 45.5 46.0 46.5	<p style="text-align: center; font-size: 4em; opacity: 0.3; transform: rotate(-45deg);">DRAFT</p> <p style="margin-left: 20px;">- begin to lose drilling fluid to formation at 40.23m BGS</p> <p style="margin-left: 20px;">END OF BOREHOLE @ 43.28m BGS</p>	<p>278.80</p>		<p>4</p> <p>5</p>		
			<p>WELL DETAILS Screened interval: 281.85 to 278.80m Length: 3.05m Diameter: 51mm Slot Size: 10 Sand Pack: 285.51 to 278.80m Material: #2 SILCA SAND</p>			

NOTES: MEASURING POINT ELEVATIONS MAY CHANGE; REFER TO CURRENT ELEVATION TABLE

BEDROCK LOG MW32A.GPJ CRA_CORP.GDT #1/3/03

A108429

Measurements recorded in: Metric Imperial

Page 1 of 1

Well Owner's Information







Overburden and Bedrock Materials/Abandonment Sealing Record (see instructions on the back of this form)

General Colour	Most Common Material	Other Materials	General Description	Depth (m/ft)
				From To
Brown	Gravel	Sand	Rocked	0.0 2.2
Grey	clay		bliss	1.22 1.4

Annular Space

Depth Set at (m/ft)	Type of Sealant Used (Material and Type)	Volume Placed (m ³ /ft ³)
From To		
0.0 4.57	Bentonite clay	0.59

Results of Well Yield Testing

After test of well yield, water was:
 Clear and sand free
 Other, specify: [Blank]

If pumping discontinued, give reason: [Blank]

Time (min)	Draw Down		Recovery	
	Water Level (m/ft)	Time (min)	Water Level (m/ft)	Time (min)
1		1		
2		2		
3		3		
4		4		
5		5		
10		10		
15		15		
20		20		
25		25		
30		30		
40		40		
50		50		
60		60		

Pump intake set at (m/ft): [Blank]

Pumping rate (l/min / GPM): [Blank]

Duration of pumping: [Blank] hrs + [Blank] min

Final water level end of pumping (m/ft): [Blank]

If flowing give rate (l/min / GPM): [Blank]

Recommended pump depth (m/ft): [Blank]

Recommended pump rate (l/min / GPM): [Blank]

Well production (l/min / GPM): [Blank]

Disinfected? Yes No

Method of Construction

Cable Tool Diamond Rotary (Conventional) Jetting Rotary (Reverse) Driving Boring Air percussion Other, specify: [Blank]

Well Use

Public Commercial Not used Domestic Municipal Dewatering Livestock Test Hole Monitoring Irrigation Cooling & Air Conditioning Industrial Other, specify: [Blank]

Construction Record - Casing

Inside Diameter (cm/in)	Open Hole OR Material (Galvanized, Fibreglass, Concrete, Plastic, Steel)	Wall Thickness (cm/in)	Depth (m/ft)		Status of Well
			From	To	
5.39	Plastic	0.8	0.0	5.49	<input type="checkbox"/> Water Supply <input type="checkbox"/> Replacement Well <input type="checkbox"/> Test Hole <input type="checkbox"/> Recharge Well <input type="checkbox"/> Dewatering Well <input type="checkbox"/> Observation and/or Monitoring Hole <input type="checkbox"/> Alteration (Construction) <input type="checkbox"/> Abandoned, Insufficient Supply <input type="checkbox"/> Abandoned, Poor Water Quality <input type="checkbox"/> Abandoned, other, specify: [Blank] <input type="checkbox"/> Other, specify: [Blank]

Construction Record - Screen

Outside Diameter (cm/in)	Material (Plastic, Galvanized, Steel)	Slot No.	Depth (m/ft)		Status of Well
			From	To	
6.03	Plastic	10	5.49	6.4	<input type="checkbox"/> Water Supply <input type="checkbox"/> Replacement Well <input type="checkbox"/> Test Hole <input type="checkbox"/> Recharge Well <input type="checkbox"/> Dewatering Well <input type="checkbox"/> Observation and/or Monitoring Hole <input type="checkbox"/> Alteration (Construction) <input type="checkbox"/> Abandoned, Insufficient Supply <input type="checkbox"/> Abandoned, Poor Water Quality <input type="checkbox"/> Abandoned, other, specify: [Blank] <input type="checkbox"/> Other, specify: [Blank]

Water Details

Water found at Depth (m/ft): [Blank] Kind of Water: Fresh Untested Gas Other, specify: [Blank]

Water found at Depth (m/ft): [Blank] Kind of Water: Fresh Untested Gas Other, specify: [Blank]

Water found at Depth (m/ft): [Blank] Kind of Water: Fresh Untested Gas Other, specify: [Blank]

Well Contractor and Well Technician Information






Map of Well Location

Please provide a map below following instructions on the back.

Comments: [Blank]

Well owner's information package delivered: Yes No

Date Package Delivered: 2010/06/21/10

Date Work Completed: 2010/06/21/10

Ministry Use Only

Audit No.: Z102059

Received: [Signature]



Measurements recorded in: Metric Imperial

Page 1 of 1

Well Owner's Information

First Name, Last Name / Organization, E-mail Address, Mailing Address, Municipality, Province, Postal Code, Telephone No.

Well Location

Address of Well Location, Township, Lot, Concession, County/District/Municipality, City/Town/Village, Province, Postal Code, UTM Coordinates, Northing, Municipal Plan and Sublot Number

Overburden and Bedrock Materials/Abandonment Sealing Record

Table with columns: General Colour, Most Common Material, Other Materials, General Description, Depth From, Depth To

Annular Space: Depth Set at, Type of Sealant Used, Volume Placed

Results of Well Yield Testing: After test of well yield, water was, Draw Down, Recovery, Pumping rate, Duration of pumping, Final water level end of pumping, If flowing give rate, Recommended pump depth, Recommended pump rate, Well production, Disinfected?

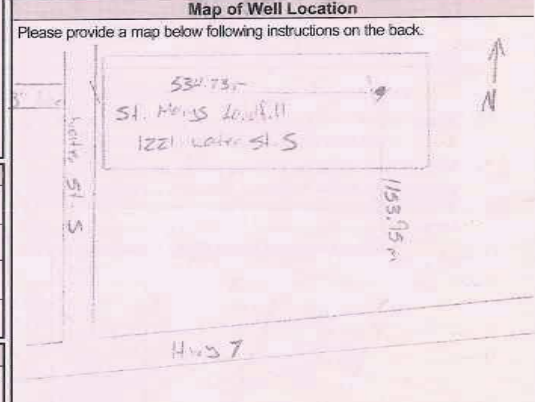
Method of Construction, Well Use

Construction Record - Casing: Inside Diameter, Open Hole OR Material, Wall Thickness, Depth, Status of Well

Construction Record - Screen: Outside Diameter, Material, Slot No., Depth

Water Details, Hole Diameter

Well Contractor and Well Technician Information



Well Technician's Licence No., Signature of Technician and/or Contractor, Date Submitted

Well owner's information package delivered, Date Package Delivered, Date Work Completed

Ministry Use Only: Audit No. 2102053

STRATIGRAPHIC AND INSTRUMENTATION LOG (OVERBURDEN)

(L-09)

PROJECT NAME: ST. MARY'S LANDFILL
 PROJECT NO.: 0645
 CLIENT: TOWN OF ST. MARY'S
 LOCATION: AS PER PLAN

HOLE DESIGNATION: BH10-91
 (Page 1 of 2)
 DATE COMPLETED: OCTOBER 15, 1991
 DRILLING METHOD: 108mm ID HSA
 CRA SUPERVISOR: J.C. MUGFORD

DEPTH m BGS	STRATIGRAPHIC DESCRIPTION & REMARKS	ELEVATION m AMSL	MONITOR INSTALLATION	SAMPLE			
				NUMBER	STATE	VALUE	
	GROUND SURFACE	317.37					
1.0	ML-SILT(TILL), little fine sand, little to some clay, little gravel, stoney, soft, moist, fractured to 0.30m - very hard, light brown, dry to damp			1CS	X		
2.0	- little to some clay, some sand, very stiff, light to medium grey-brown, damp			(2CS) (1.2 - 2.1m)	X		
3.0	- some clay, softer, massive, moist			3CS	X		
4.0	ML-SILT(GLACIOLACUSTRINE), some clay, soft, layered, moist to wet, dilatant - some clay, occasional pebble, more massive, less layering	313.56		203.2mm Ø BOREHOLE	4CS	X	
5.0	GW/SW-GRAVEL and SAND, gravel is fine, sand is fine to coarse grained, little to some silt, brown, saturated	312.19			5CS	X	
6.0	ML-SILT, (GLACIOLACUSTRINE), trace to some clay, few pebbles, slightly layered, light brown and grey, damp	311.43			6CS	X	
7.0	ML-SILT(TILL), some clay, some sand, occasional pebbles, stones, very hard, stiff, brown to dark brown, damp - increasing gravel content	310.97		BENTONITE GROUT	7CS	X	
8.0					8CS	X	
9.0	SW-SAND, fine to coarse grained, some coarse gravel, little to some silt, brown, saturated	308.84 308.68			9CS	X	
10.0	ML-SILT(TILL), some clay, little to some coarse sand and gravel, few cobbles, very hard, stiff, brown and grey, damp - few cobbles					X	
11.0	- fine to coarse sand seam with some silt and gravel, wet (2cm thick)					X	
12.0	- horizontal fracturing					X	
13.0						X	

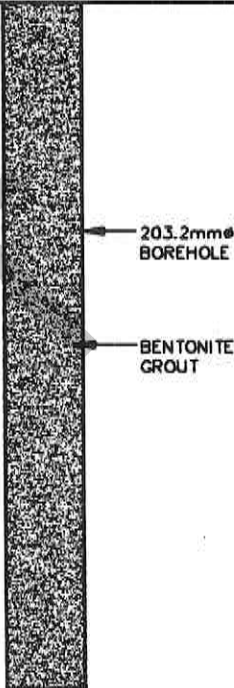
NOTES: MEASURING POINT ELEVATIONS MAY CHANGE; REFER TO CURRENT ELEVATION TABLE
 GRAIN SIZE ANALYSIS ○ WATER FOUND ▽ STATIC WATER LEVEL ▽

STRATIGRAPHIC AND INSTRUMENTATION LOG (OVERBURDEN)

(L-09)

PROJECT NAME: ST. MARY'S LANDFILL
 PROJECT NO.: 0645
 CLIENT: TOWN OF ST. MARY'S
 LOCATION: AS PER PLAN

HOLE DESIGNATION: BH10-91
 (Page 2 of 2)
 DATE COMPLETED: OCTOBER 15, 1991
 DRILLING METHOD: 108mm ID HSA
 CRA SUPERVISOR: J.C. MUGFORD

DEPTH m BGS	STRATIGRAPHIC DESCRIPTION & REMARKS	ELEVATION m AMSL	MONITOR INSTALLATION	SAMPLE		
				NUMBER	STATE	VALUE
14.0				10CS	X	
15.0				11CS	X	
16.0				12CS	X	
17.0	- fine to medium grained sand seam, little silt, wet, (6cm thick)			13CS	X	
18.0	- trace sand, moist			14CS	X	
19.0						
20.0	LIMESTONE (BEDROCK) END OF HOLE @ 20.12 m BGS.	297.56 297.25				
21.0						
22.0						
23.0						
24.0						
25.0						
26.0						

NOTES: MEASURING POINT ELEVATIONS MAY CHANGE; REFER TO CURRENT ELEVATION TABLE
 GRAIN SIZE ANALYSIS ○ WATER FOUND ▽ STATIC WATER LEVEL ▽

STRATIGRAPHIC AND INSTRUMENTATION LOG (OVERBURDEN)

(L-10)

PROJECT NAME: ST. MARY'S LANDFILL

HOLE DESIGNATION: BH11-91
(Page 1 of 2)

PROJECT NO.: 0645

DATE COMPLETED: OCTOBER 10, 1991

CLIENT: TOWN OF ST. MARY'S

DRILLING METHOD: 108mm ID HSA

LOCATION: AS PER PLAN

CRA SUPERVISOR: J.C. MUGFORD

DEPTH m BGS	STRATIGRAPHIC DESCRIPTION & REMARKS	ELEVATION m AMSL	MONITOR INSTALLATION	SAMPLE			
				NUMBER	STATE	VALUE	
	GROUND SURFACE	316.25					
	SM-SAND, some silt, some roots, loose, brown moist	316.10	CONCRETE SEAL		X		
- 1.0	ML-SILT(TILL), little to some clay and sand, little gravel, hard, very stiff, light brown and grey, damp	315.34		1CS	X		
- 2.0	ML/SM-SILT and SAND(GLACIOLACUSTRINE), fine grained, little clay, trace pebbles	314.42		(2CS) (1.8 - 3.1m)	X		
- 3.0	ML/CL-SILT(TILL), some clay, little sand, trace gravel, hard, very stiff, unfractured, light brown to grey, damp to moist			X			
- 4.0	SM/ML-SILT(GLACIOLACUSTRINE), some fine grained sand, trace clay, poorly graded, well-layered (undulating), tan, damp to moist - fine sand seam, little to some silt, saturated (4.45m to 4.50m BGS)	312.44		203.2mm Ø BOREHOLE	3CS	X	
- 5.0				X	4CS	X	
- 6.0				X	5CS	X	
- 7.0	ML/CL-SILT(TILL), some clay, some fine to coarse gravel, little sand, few cobbles, very hard, stiff, light brown to grey, damp - oblique fracture with silt infilling - dry to damp	310.00		BENTONITE GROUT	6CS	X	
- 8.0				X	7CS	X	
- 9.0				X	8CS	X	
- 10.0	- 2cm wet pocket (@ 9.9m BGS) - softer (10.0m to 10.5m BGS)			X	9CS	X	
- 11.0				X			
- 12.0				X			
- 13.0	ML-SILT(GLACIOLACUSTRINE), little to some clay, little fine sand, occasional pebble, layered, varved, light grey to light brown, damp to moist	303.45					

NOTES: MEASURING POINT ELEVATIONS MAY CHANGE; REFER TO CURRENT ELEVATION TABLE

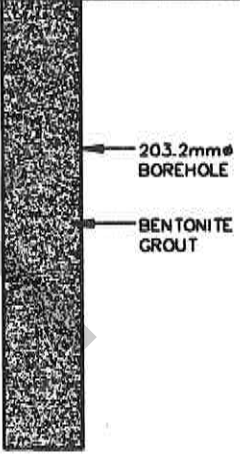
GRAIN SIZE ANALYSIS ○ WATER FOUND ▽ STATIC WATER LEVEL ▽

STRATIGRAPHIC AND INSTRUMENTATION LOG (OVERBURDEN)

(L-10)

PROJECT NAME: ST. MARY'S LANDFILL
 PROJECT NO.: 0645
 CLIENT: TOWN OF ST. MARY'S
 LOCATION: AS PER PLAN

HOLE DESIGNATION: BH11-91
 (Page 2 of 2)
 DATE COMPLETED: OCTOBER 10, 1991
 DRILLING METHOD: 108mm ID HSA
 CRA SUPERVISOR: J.C. MUGFORD

DEPTH m BGS	STRATIGRAPHIC DESCRIPTION & REMARKS	ELEVATION m AMSL	MONITOR INSTALLATION	SAMPLE		
				NUMBER	STATE	VALUE
14.0	ML-SILT(TILL), little to some fine sand and clay, little gravel, very dense, hard, damp - becoming silt with some sand and little clay, partially cemented	301.95		10CS	X	
15.0				11CS	X	
16.0				12CS	X	
17.0	LIMESTONE(BEDROCK), light grey and brown, layered, massive	298.88				
18.0	END OF HOLE @ 17.68 m BGS.	298.57				
19.0						
20.0						
21.0						
22.0						
23.0						
24.0						
25.0						
26.0						

NOTES: MEASURING POINT ELEVATIONS MAY CHANGE; REFER TO CURRENT ELEVATION TABLE
 GRAIN SIZE ANALYSIS ○ WATER FOUND ▽ STATIC WATER LEVEL ▽

STRATIGRAPHIC AND INSTRUMENTATION LOG (OVERBURDEN)

(L-11)

PROJECT NAME: ST. MARY'S LANDFILL
 PROJECT NO.: 0645
 CLIENT: TOWN OF ST. MARY'S
 LOCATION: AS PER PLAN

HOLE DESIGNATION: BH12-91
 (Page 1 of 2)
 DATE COMPLETED: OCTOBER 16, 1991
 DRILLING METHOD: 108mm ID HSA
 CRA SUPERVISOR: J.C. MUGFORD

DEPTH m BGS	STRATIGRAPHIC DESCRIPTION & REMARKS	ELEVATION m AMSL	MONITOR INSTALLATION	SAMPLE		
				NUMBER	STATE	VALUE
	GROUND SURFACE	317.07				
1.0	ML-SILT(TILL), some clay, little sand, trace gravel, few cobbles, soft, well fractured, light brown to brown, damp - very hard, occasional fracture			1CS	X	
2.0				2CS	X	
3.0	ML-SILT(OUTWASH), some very fine grained sand, trace clay, occasional pebble, compact, poorly graded, tan, saturated	314.17		(3CS) (2.9 - 4.1m)	X	
4.0	ML-SILT(TILL), some clay, some sand, little gravel, hard, very stiff, slight horizontal fracturing and layering, brown, damp	312.96		(4CS) (4.3 - 5.8m)	X	
5.0				5CS	X	
6.0				6CS	X	
7.0	- trace to little gravel, frequent pebbles and cobbles, stiff, medium brown, damp			7CS	X	
8.0	- sand, silt and gravel seam (8.23 to 8.38m BGS)			8CS	X	
9.0	- wet seam			9CS	X	
10.0	- wet seam				X	
11.0	- little clay and sand, trace gravel, crumbly and fissile, light brown-grey, dry to damp				X	
12.0	- dry sand seam (2cm thick)				X	
13.0	- frequent sub-horizontal to oblique fractures, dark brown, moist (13.4 to 14.3m BGS)				X	


NOTES: MEASURING POINT ELEVATIONS MAY CHANGE; REFER TO CURRENT ELEVATION TABLE
 GRAIN SIZE ANALYSIS ○ WATER FOUND ∇ STATIC WATER LEVEL ▼

STRATIGRAPHIC AND INSTRUMENTATION LOG (OVERBURDEN)




(L-11)

PROJECT NAME: ST. MARY'S LANDFILL
 PROJECT NO.: 0645
 CLIENT: TOWN OF ST. MARY'S
 LOCATION: AS PER PLAN

HOLE DESIGNATION: BH12-91
 (Page 2 of 2)
 DATE COMPLETED: OCTOBER 16, 1991
 DRILLING METHOD: 108mm ID HSA
 CRA SUPERVISOR: J.C. MUGFORD

DEPTH m BGS	STRATIGRAPHIC DESCRIPTION & REMARKS	ELEVATION m AMSL	MONITOR INSTALLATION	SAMPLE		
				NUMBER	STATE	VALUE
14.0	- occasional thin varved intervals		 <p>203.2mmϕ BOREHOLE</p> <p>BENTONITE GROUT</p>	10CS	X	
15.0	- oblique fractures, moist (14.94 to 15.40m BGS) - little clay, trace to little gravel, hard, blocky structure, medium brown-grey, damp			11CS	X	
16.0				12CS	X	
17.0	- less pebbles			13CS	X	
18.0	- layered silts (18.29 to 19.20m BGS)			14CS	X	
19.0		297.87				
	SP-SAND, fine grained, little to some silt, poorly graded, dry					
20.0	LIMESTONE (BEDROCK) END OF HOLE @ 19.96 m BGS.	297.11				
21.0						
22.0						
23.0						
24.0						
25.0						
26.0						

NOTES: MEASURING POINT ELEVATIONS MAY CHANGE; REFER TO CURRENT ELEVATION TABLE

GRAIN SIZE ANALYSIS  WATER FOUND  STATIC WATER LEVEL 

STRATIGRAPHIC AND INSTRUMENTATION LOG (OVERBURDEN)

(L-12)

PROJECT NAME: ST. MARY'S LANDFILL
 PROJECT NO.: 0645
 CLIENT: TOWN OF ST. MARY'S
 LOCATION: AS PER PLAN

HOLE DESIGNATION: BH13-91
 (Page 1 of 2)
 DATE COMPLETED: OCTOBER 18, 1991
 DRILLING METHOD: 108mm ID HSA
 CRA SUPERVISOR: J.C. MUGFORD

DEPTH m BGS	STRATIGRAPHIC DESCRIPTION & REMARKS	ELEVATION m AMSL	MONITOR INSTALLATION	SAMPLE		
				NUMBER	STATE	VALUE
	GROUND SURFACE	313.79				
1.0	ML-SILT(OUTWASH), little sand, little clay, few pebbles, stiff, interlayered, brown and tan, damp	312.88		1CS	X	
2.0	ML/CL-SILT(TILL), some clay, some sand, trace gravel, hard, stiff, damp - fractured			2CS	X	
3.0	- fine to coarse grained sand seam, trace silt, wet (2cm thick)			3CS	X	
4.0	- horizontal fracture, shiny			4CS	X	
5.0	- no fractures observed			(5CS) (4.6 - 5.6m)	X	
6.0				6CS	X	
7.0				7CS	X	
8.0				8CS	X	
9.0	- frequent horizontal to sub-vertical fractures, shiny, smooth, moist (9.14 to 10.67m BGS)			9CS	X	
10.0	- dry to damp			10CS	X	
11.0	- little to some clay, damp					
12.0		307.54				
13.0	ML-SILT and SAND(TILL), little gravel, trace to little clay, compact, non-cohesive, tan to light brown, moist, partially cemented					

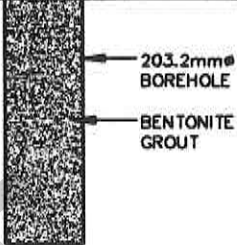
NOTES: MEASURING POINT ELEVATIONS MAY CHANGE; REFER TO CURRENT ELEVATION TABLE
 GRAIN SIZE ANALYSIS ○ WATER FOUND ∇ STATIC WATER LEVEL ▼

STRATIGRAPHIC AND INSTRUMENTATION LOG (OVERBURDEN)

(L-12)

PROJECT NAME: ST. MARY'S LANDFILL
 PROJECT NO.: 0645
 CLIENT: TOWN OF ST. MARY'S
 LOCATION: AS PER PLAN

HOLE DESIGNATION: BH13-91
 (Page 2 of 2)
 DATE COMPLETED: OCTOBER 18, 1991
 DRILLING METHOD: 108mm ID HSA
 CRA SUPERVISOR: J.C. MUGFORD

DEPTH m BGS	STRATIGRAPHIC DESCRIPTION & REMARKS	ELEVATION m AMSL	MONITOR INSTALLATION	SAMPLE		
				N U M B E R	S T A T E	V A L U E
14.0	- very moist		 <p style="font-size: small;">203.2mm Ø BOREHOLE BENTONITE GROUT</p>	(11CS)	X	
15.0				(13.3 - 14.8m)	X	
16.0	LIMESTONE (BEDROCK) END OF HOLE @ 15.54 m BGS.	298.25		12CS	X	
17.0						
18.0						
19.0						
20.0						
21.0						
22.0						
23.0						
24.0						
25.0						
26.0						

NOTES: MEASURING POINT ELEVATIONS MAY CHANGE; REFER TO CURRENT ELEVATION TABLE

GRAIN SIZE ANALYSIS ○ WATER FOUND ▽ STATIC WATER LEVEL ▼

STRATIGRAPHIC AND INSTRUMENTATION LOG (OVERBURDEN)

(L-13)

PROJECT NAME: ST. MARY'S LANDFILL
 PROJECT NO.: 0645
 CLIENT: TOWN OF ST. MARY'S
 LOCATION: AS PER PLAN

HOLE DESIGNATION: BH14-91
 DATE COMPLETED: OCTOBER 21, 1991
 DRILLING METHOD: 108mm ID HSA
 CRA SUPERVISOR: J.C. MUGFORD

DEPTH m BGS	STRATIGRAPHIC DESCRIPTION & REMARKS	ELEVATION m AMSL	MONITOR INSTALLATION	SAMPLE		
				NUMBER	STATE	VALUE
	GROUND SURFACE	317.60				
-1.0	ML/CL-SILT(TILL), some sand and clay, damp					
-2.0						
-3.0	ML-SILT(GLACIOLACUSTRINE), some clay, little fine grained sand, few pebbles, soft to firm, layered, light brown to brown, moist	314.60				
-4.0					1CS	X
-5.0	ML-SILT(TILL), little to some sand, little clay, trace gravel, few cobbles, firm, light brown, moist	313.13			2CS	X
-6.0	ML-SILT(OUTWASH), little to some very fine sand, trace clay, occasional pebble, compact, tan, wet - occasional fine to medium grained sand seam, wet (2cm thick)	312.42			3CS	X
-7.0	ML/CL-SILT(TILL), some clay and sand, trace gravel, very stiff, medium to dark brown, moist - damp	311.20			4CS	X
-8.0	END OF HOLE @ 7.57 m BGS.	310.03				
-9.0						
-10.0						
-11.0						
-12.0						
-13.0						

NOTES: MEASURING POINT ELEVATIONS MAY CHANGE; REFER TO CURRENT ELEVATION TABLE

GRAIN SIZE ANALYSIS ○ WATER FOUND ▽ STATIC WATER LEVEL ▼

STRATIGRAPHIC AND INSTRUMENTATION LOG (OVERBURDEN)

(L-15)

PROJECT NAME: ST. MARY'S LANDFILL
 PROJECT NO.: 0645
 CLIENT: TOWN OF ST. MARY'S
 LOCATION: AS PER PLAN

HOLE DESIGNATION: BH16-91
 DATE COMPLETED: OCTOBER 21, 1991
 DRILLING METHOD: 108mm ID HSA
 CRA SUPERVISOR: J.C. MUGFORD

DEPTH m BGS	STRATIGRAPHIC DESCRIPTION & REMARKS	ELEVATION m AMSL	MONITOR INSTALLATION	SAMPLE		
				NUMBER	STATE	VALUE
	GROUND SURFACE	317.24				
1.0	ML-SILT(TILL), some clay and sand, damp to moist					
2.0						
3.0	ML/CL-SILT and CLAY(GLACIOLACUSTRINE), trace to little fine sand, layered, firm, tan to light brown, moist	314.50				
3.5		313.89				
4.0	ML-SILT(TILL), some fine grained sand, little clay, firm, tan, saturated	313.43			(1CS)	
4.5	SW-SAND, coarse grained, little silt, little gravel, little fine grained sand, saturated				(2.7 - 3.4m)	
5.0					2CS	
6.0	- some gravel				3CS	
7.0	ML/CL-SILT(TILL), some clay, stiff, brown, damp to moist	310.53			4CS	
7.5	- fine to medium grained sand seam, wet (20cm thick)	309.92				
8.0	END OF HOLE @ 7.32 m BGS.					
9.0						
10.0						
11.0						
12.0						
13.0						

NOTES: MEASURING POINT ELEVATIONS MAY CHANGE; REFER TO CURRENT ELEVATION TABLE
 GRAIN SIZE ANALYSIS ○ WATER FOUND ▽ STATIC WATER LEVEL ▽

STRATIGRAPHIC AND INSTRUMENTATION LOG (OVERBURDEN)

(L-17)

PROJECT NAME: ST. MARY'S LANDFILL
 PROJECT NO.: 0645
 CLIENT: TOWN OF ST. MARY'S
 LOCATION: AS PER PLAN

HOLE DESIGNATION: BH18-91
 DATE COMPLETED: NOVEMBER 16, 1991
 DRILLING METHOD: 95mm ID HSA
 CRA SUPERVISOR: J.C. MUGFORD

DEPTH m BGS	STRATIGRAPHIC DESCRIPTION & REMARKS	ELEVATION m AMSL	MONITOR INSTALLATION	SAMPLE			
				NUMBER	STATE	VALUE	
	GROUND SURFACE	317.00					
	GM-GRAVEL(FILL), some silt, some sand, loose brown, moist						
1.0	ML-SILT(TILL), some sand, little to some clay, little gravel, hard, light brown, damp to moist	316.39					
2.0					1SS	X	50
3.0	- damp						
4.0	ML/CL-SILT and CLAY(GLACIOLACUSTRINE), occasional pebble, hard, layered, damp	313.42			2SS	X	52
					3SS	X	48
5.0	ML-SILT(OUTWASH), little sand and clay, fining upwards, very dense, brown, wet, dilatant	312.12			4SS	X	77
	ML-SILT(TILL), some sand, some clay, little gravel, grey-brown, hard, damp to moist	311.77			5SS	X	79
6.0					6SS	X	27
7.0	SW-SAND, trace silt, well graded, medium dense, salt and pepper colour, saturated	310.75			7SS	X	43
	ML/CL-SILT(TILL), some clay, some sand, little gravel, hard, grey-brown, damp	310.29					
	END OF HOLE @ 7.47 m BGS.	309.53					
8.0							
9.0							
10.0							
11.0							
12.0							
13.0							

NOTES: MEASURING POINT ELEVATIONS MAY CHANGE; REFER TO CURRENT ELEVATION TABLE

GRAIN SIZE ANALYSIS ○ WATER FOUND ∇ STATIC WATER LEVEL ▼

STRATIGRAPHIC AND INSTRUMENTATION LOG (OVERBURDEN)

(L-18)

PROJECT NAME: ST. MARY'S LANDFILL

HOLE DESIGNATION: BH19-91

PROJECT NO.: 0645

DATE COMPLETED: NOVEMBER 16, 1991

CLIENT: TOWN OF ST. MARY'S

DRILLING METHOD: 95mm ID HSA

LOCATION: AS PER PLAN

CRA SUPERVISOR: J.C. MUGFORD

DEPTH m BGS	STRATIGRAPHIC DESCRIPTION & REMARKS	ELEVATION m AMSL	MONITOR INSTALLATION	SAMPLE			
				NUMBER	STATE	VALUE	
	GROUND SURFACE	317.39					
-1.0	ML/CL-SILT(TILL), some clay and sand, moist						
-2.0	SW/GM-SAND and GRAVEL, little silt, loose, wet, occasional silt layer	315.56					
-3.0							
-4.0	- coarse grained sand				1SS	X	35
-5.0	SM-SILT and SAND, very fine grained, very dense, light brown, wet	312.36 312.21			2SS	X	80
-6.0	ML/CL-SILT(TILL), some clay, some sand, little gravel, hard, medium brown-grey, damp						
-7.0	END OF HOLE @ 6.71 m BGS.	310.68			3SS	X	76
-8.0							
-9.0							
-10.0							
-11.0							
-12.0							
-13.0							

NOTES: MEASURING POINT ELEVATIONS MAY CHANGE; REFER TO CURRENT ELEVATION TABLE

GRAIN SIZE ANALYSIS WATER FOUND STATIC WATER LEVEL

STRATIGRAPHIC AND INSTRUMENTATION LOG (OVERBURDEN)

(L-19)

PROJECT NAME: ST. MARY'S LANDFILL

HOLE DESIGNATION: BH20-91

PROJECT NO.: 0645

DATE COMPLETED: DECEMBER 9, 1991

CLIENT: TOWN OF ST. MARY'S

DRILLING METHOD: 95mm ID HSA

LOCATION: AS PER PLAN

CRA SUPERVISOR: J.C. MUGFORD

DEPTH m BGS	STRATIGRAPHIC DESCRIPTION & REMARKS	ELEVATION m AMSL	MONITOR INSTALLATION	SAMPLE		
				NUMBER	STATE	VALUE
	GROUND SURFACE	315.62				
-1.0	ML-SILT(TILL), little to some clay and sand, trace gravel, hard, damp			1SS	X	69
-2.0	ML-SILT(TILL, REWORKED LACUSTRINE), some clay, trace to little fine sand, hard, light brown, damp - few dark brown moist clayey seams, few small pebbles, no obvious layering	314.09		2SS	X	69
-3.0	- laminated silt and clay layers, hard, light brown, damp	313.09		3SS	X	91
-4.0	ML/SM-SILT(LACUSTRINE), little to some very fine sand, trace clay, tan, dilatant, wet, dense, trace layering, non-cohesive - very dense, slight layering, few dilatant sand pores - undulating silt and sand bedding layers (2 to 4cm thick)	311.50		4SS	X	86
-5.0				5SS	X	77
-6.0	ML-SILT(TILL), some clay and sand, trace gravel, hard, brown - fine to medium sand and silt layers, wet (0.5 to 1.5cm thick @ 4.27, 4.36, 4.45 and 4.54m BGS)			6SS	X	76
-7.0	- little to some sand, few large pebbles, extremely hard, damp - little gravel	308.91		7SS	X	67
-8.0	END OF HOLE @ 6.71 m BGS.			8SS	X	54
-9.0				9SS	X	54
-10.0						
-11.0						
-12.0						
-13.0						

NOTES: MEASURING POINT ELEVATIONS MAY CHANGE; REFER TO CURRENT ELEVATION TABLE

GRAIN SIZE ANALYSIS ○ WATER FOUND ▽ STATIC WATER LEVEL ▼

STRATIGRAPHIC AND INSTRUMENTATION LOG (OVERBURDEN)

(L-21)

PROJECT NAME: ST. MARY'S LANDFILL

HOLE DESIGNATION: BH22-91

PROJECT NO.: 0645

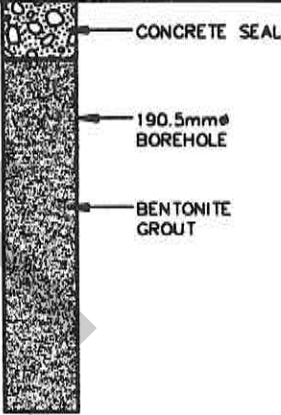
DATE COMPLETED: DECEMBER 10, 1991

CLIENT: TOWN OF ST. MARY'S

DRILLING METHOD: 95mm ID HSA

LOCATION: AS PER PLAN

CRA SUPERVISOR: J.C. MUGFORD

DEPTH m BGS	STRATIGRAPHIC DESCRIPTION & REMARKS	ELEVATION m AMSL	MONITOR INSTALLATION	SAMPLE		
				NUMBER	STATE	VALUE
	GROUND SURFACE	314.22				
1.0	SW-SAND, little silt, trace gravel, fine to medium grained, loose, brown, saturated	313.61		1SS	X	21
	ML-SILT(TILL), some sand, little gravel, trace to little clay, hard, brown, moist	313.15		2SS	X	74
2.0	GW-GRAVEL, some sand, little silt, saturated	312.70		3SS	X	53
	ML-SILT(TILL), some sand, little clay and gravel, hard, light brown, moist			4SS	X	50
3.0	- some clay, grey			5SS	X	40
4.0	- very stoney (3.66 to 4.27m BGS)					
4.0	END OF HOLE (REFUSAL) @ 4.27 m BGS.	309.95				
5.0						
6.0						
7.0						
8.0						
9.0						
10.0						
11.0						
12.0						
13.0						

NOTES: MEASURING POINT ELEVATIONS MAY CHANGE; REFER TO CURRENT ELEVATION TABLE

GRAIN SIZE ANALYSIS



WATER FOUND



STATIC WATER LEVEL




STRATIGRAPHIC AND INSTRUMENTATION LOG (OVERBURDEN)

(L-22)

PROJECT NAME: ST. MARY'S LANDFILL
 PROJECT NO.: 0645
 CLIENT: TOWN OF ST. MARY'S
 LOCATION: AS PER PLAN

HOLE DESIGNATION: BH23-91
 DATE COMPLETED: DECEMBER 11, 1991
 DRILLING METHOD: 95mm ID HSA
 CRA SUPERVISOR: J.C. MUGFORD

DEPTH m BGS	STRATIGRAPHIC DESCRIPTION & REMARKS	ELEVATION m AMSL	MONITOR INSTALLATION	SAMPLE		
				NUMBER	STATE	VALUE
	GROUND SURFACE	313.97				
1.0	ML-SILT(LACUSTRINE), little to some very fine sand, trace clay, occasional small pebble, non-cohesive, medium dense, tan, moist	313.51	 <p>CONCRETE SEAL</p> <p>190.5mm Ø BOREHOLE</p> <p>BENTONITE GROUT</p>	1SS	X	25
	ML-SILT(TILL), some sand, little clay, little gravel, stiff, brown, damp	313.21		2SS	X	56
2.0	SM-SAND and SILT, some gravel, very dense, brown, moist to wet	312.45		3SS	X	38
3.0	ML-SILT(TILL), some clay and sand, trace gravel, hard, brown, damp to moist - stones and gravel (2.29 to 3.05m BGS)			4SS	X	60
4.0	- damp			5SS	X	>100
5.0	END OF HOLE @ 5.18 m BGS.	308.79				
6.0						
7.0						
8.0						
9.0						
10.0						
11.0						
12.0						
13.0						

NOTES: MEASURING POINT ELEVATIONS MAY CHANGE; REFER TO CURRENT ELEVATION TABLE

GRAIN SIZE ANALYSIS ○ WATER FOUND ∇ STATIC WATER LEVEL ▼

STRATIGRAPHIC AND INSTRUMENTATION LOG (OVERBURDEN)

(L-23)

PROJECT NAME: ST. MARY'S LANDFILL

HOLE DESIGNATION: BH24-91

PROJECT NO.: 0645

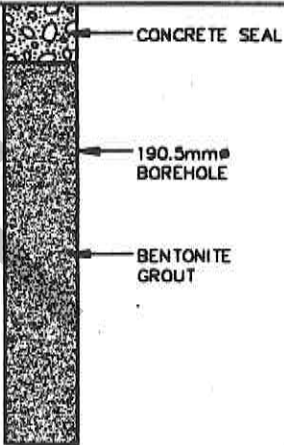
DATE COMPLETED: DECEMBER 11, 1991

CLIENT: TOWN OF ST. MARY'S

DRILLING METHOD: 95mm ID HSA

LOCATION: AS PER PLAN

CRA SUPERVISOR: J.C. MUGFORD

DEPTH m BGS	STRATIGRAPHIC DESCRIPTION & REMARKS	ELEVATION m AMSL	MONITOR INSTALLATION	SAMPLE		
				NUMBER	STATE	VALUE
	GROUND SURFACE	313.97				
1.0	ML-SILT(TILL), some sand and clay, little gravel, hard, light brown, damp			1AR	X	
2.0	- stoney, brown			2AR	X	
3.0				3AR	X	
4.0					X	
5.0	END OF HOLE @ 4.57 m BGS.	309.40				
6.0						
7.0						
8.0						
9.0						
10.0						
11.0						
12.0						
13.0						

NOTES: MEASURING POINT ELEVATIONS MAY CHANGE; REFER TO CURRENT ELEVATION TABLE
 GRAIN SIZE ANALYSIS ○ WATER FOUND ∇ STATIC WATER LEVEL ▼

STRATIGRAPHIC AND INSTRUMENTATION LOG (OVERBURDEN)

(L-25)

PROJECT NAME: ST. MARY'S LANDFILL

HOLE DESIGNATION: BH26-91

PROJECT NO.: 0645


DATE COMPLETED: DECEMBER 12, 1991

CLIENT: TOWN OF ST. MARY'S


DRILLING METHOD: 95mm ID HSA

LOCATION: AS PER PLAN

CRA SUPERVISOR: J.C. MUGFORD

DEPTH m BGS	STRATIGRAPHIC DESCRIPTION & REMARKS	ELEVATION m AMSL	MONITOR INSTALLATION	SAMPLE		
				NUMBER	STATE	VALUE
	GROUND SURFACE	316.96				
1.0	ML-SILT(TILL), some clay and sand, little gravel, hard, grey-brown, moist, cohesive	315.95	 <p style="margin-left: 20px;">CONCRETE SEAL</p> <p style="margin-left: 20px;">190.5mmϕ BOREHOLE</p> <p style="margin-left: 20px;">BENTONITE GROUT</p>	1SS	X	38
2.0	ML/SM-SILT(LACUSTRINE), some fine sand, little clay, very dense, tan, moist to wet, faint layering, non-cohesive	315.13		2SS	X	40
3.0	ML-SILT(TILL, REWORKED LACUSTRINE), some fine sand, little to some clay, trace gravel light grey-brown, damp to moist, cohesive -occasional clay seam with thin (.5cm thick) silt and fine sand layering, damp to moist, occasional moist oblique fracture			3SS	X	28
4.0	- trace fine pebbles			4SS	X	38
5.0	GW-GRAVEL, some sand, trace silt, stoney, very dense, saturated	312.24		5SS	X	47
6.0	SW-SAND, some gravel, fine to coarse grained, very dense, salt and pepper colour, saturate	311.63		6SS	X	76
7.0	ML/SM-SILT, some fine sand, trace clay, tan, saturated	311.02		7SS	X	43
8.0	ML-SILT(TILL), some sand and clay, trace to little gravel, hard, light grey-brown, damp to moist	310.71		8SS	X	36
8.23	END OF HOLE @ 8.23 m BGS.	308.73		9SS	X	80
9.0						
10.0						
11.0						
12.0						
13.0						

NOTES: MEASURING POINT ELEVATIONS MAY CHANGE; REFER TO CURRENT ELEVATION TABLE

GRAIN SIZE ANALYSIS  WATER FOUND  STATIC WATER LEVEL 

STRATIGRAPHIC AND INSTRUMENTATION LOG (OVERBURDEN)

(L-26)

PROJECT NAME: ST. MARY'S LANDFILL

HOLE DESIGNATION: BH27-91

PROJECT NO.: 0645


DATE COMPLETED: DECEMBER 12, 1991

CLIENT: TOWN OF ST. MARY'S

DRILLING METHOD: 95mm ID HSA

LOCATION: AS PER PLAN

CRA SUPERVISOR: J.C. MUGFORD

DEPTH m BGS	STRATIGRAPHIC DESCRIPTION & REMARKS	ELEVATION m AMSL	MONITOR INSTALLATION	SAMPLE		
				NUMBER	STATE	VALUE
	GROUND SURFACE	<i>316.01</i>				
-1.0	ML-SILT(TILL), some sand and clay, little gravel, light brown, damp		 <p style="font-size: small;">CONCRETE SEAL</p> <p style="font-size: small;">190.5mm Ø BOREHOLE</p> <p style="font-size: small;">BENTONITE GROUT</p>			
-2.0	ML-SILT(LACUSTRINE), some clay and fine sand, dense, tan, damp, layered	<i>314.49</i>		1SS	X	40
-3.0				2SS	X	47
-4.0	SW-SAND, some gravel, fine to coarse grained, well graded, very dense, saturated	<i>312.20</i>				
-5.0	ML-SILT(TILL), some sand and clay, little gravel, very hard, light brown, damp to moist	<i>311.29</i>		3SS	X	50
-6.0				4SS	X	>50
-7.0						
-8.0				5SS	X	94
-8.23	END OF HOLE @ 8.23 m BGS.	<i>307.78</i>				
-9.0						
-10.0						
-11.0						
-12.0						
-13.0						

NOTES: MEASURING POINT ELEVATIONS MAY CHANGE; REFER TO CURRENT ELEVATION TABLE


GRAIN SIZE ANALYSIS ○ WATER FOUND ∇ STATIC WATER LEVEL ▼

STRATIGRAPHIC AND INSTRUMENTATION LOG (OVERBURDEN)

(L-27)

PROJECT NAME: ST. MARY'S LANDFILL
 PROJECT NO.: 0645
 CLIENT: TOWN OF ST. MARY'S
 LOCATION: AS PER PLAN

HOLE DESIGNATION: BH28-91
 DATE COMPLETED: DECEMBER 12, 1991
 DRILLING METHOD: 95mm ID HSA
 CRA SUPERVISOR: J.C. MUGFORD

DEPTH m BGS	STRATIGRAPHIC DESCRIPTION & REMARKS	ELEVATION m AMSL	MONITOR INSTALLATION	SAMPLE		
				NUMBER	STATE	VALUE
	GROUND SURFACE	313.50				
-1.0	ML-SILT(TILL), some sand and clay, little gravel, very stoney, hard, brown, damp - moist - damp		 <p style="font-size: small;">CONCRETE SEAL 190.5mm Ø BOREHOLE BENTONITE GROUT</p>			
-2.0				1SS	⊗	32
-3.0				2SS	⊗	44
-4.0				3SS	⊗	
-5.0				4SS	⊗	54
-6.0		306.95				
-7.0	END OF HOLE @ 6.55 m BGS.					
-8.0						
-9.0						
-10.0						
-11.0						
-12.0						
-13.0						


NOTES: MEASURING POINT ELEVATIONS MAY CHANGE; REFER TO CURRENT ELEVATION TABLE
 GRAIN SIZE ANALYSIS ○ WATER FOUND ⊗ STATIC WATER LEVEL ▼

STRATIGRAPHIC AND INSTRUMENTATION LOG (OVERBURDEN)

(L-28)

PROJECT NAME: ST. MARY'S LANDFILL
 PROJECT NO.: 0645
 CLIENT: TOWN OF ST. MARY'S
 LOCATION: AS PER PLAN

HOLE DESIGNATION: BH29-91
 DATE COMPLETED: DECEMBER 13, 1991
 DRILLING METHOD: 95mm ID HSA
 CRA SUPERVISOR: J.C. MUGFORD

DEPTH m BGS	STRATIGRAPHIC DESCRIPTION & REMARKS	ELEVATION m AMSL	MONITOR INSTALLATION	SAMPLE		
				N U M B E R	S T A T E	V A L U E
	GROUND SURFACE	314.24				
1.0	GW-GRAVEL(FILL), some silt and sand, dense, moist	313.33				
2.0	ML-SILT(TILL), some clay and sand, little gravel, hard, brown, damp - sand seam (0.5cm thick)			1SS	X	32
3.0	- very hard			2SS	X	43
4.0				3SS	X	66
5.0				4SS	X	86
6.0						
7.0	END OF HOLE @ 6.71 m BGS.	307.53				
8.0						
9.0						
10.0						
11.0						
12.0						
13.0						

NOTES: MEASURING POINT ELEVATIONS MAY CHANGE; REFER TO CURRENT ELEVATION TABLE
 GRAIN SIZE ANALYSIS ○ WATER FOUND ∇ STATIC WATER LEVEL ▼

STRATIGRAPHIC AND INSTRUMENTATION LOG (OVERBURDEN)

(L-29)

PROJECT NAME: ST. MARY'S LANDFILL

HOLE DESIGNATION: BH30-91

PROJECT NO.: 0645

DATE COMPLETED: DECEMBER 13, 1991

CLIENT: TOWN OF ST. MARY'S

DRILLING METHOD: 95mm ID HSA

LOCATION: AS PER PLAN

CRA SUPERVISOR: J.C. MUGFORD

DEPTH m BGS	STRATIGRAPHIC DESCRIPTION & REMARKS	ELEVATION m AMSL	MONITOR INSTALLATION	SAMPLE		
				NUMBER	STATE	VALUE
	GROUND SURFACE	317.61				
1.0	ML-SILT(TILL), some sand and clay, little gravel, stoney, hard, brown, damp			1AR	X	
2.0						
3.0	ML-SILT(LACUSTRINE), some clay, little to some fine sand, medium dense, tan, moist	315.32		2AR	X	
4.0	ML/SM-SILT(OUTWASH), some fine sand, trace clay, very dense, tan, wet - fine to medium grained sand and silt seam, wet (3.35 to 3.51m and 3.81 to 4.11m BGS) - occasional pebble, coarsely layered, very dense, wet - silt with little fine sand and clay	314.56		3SS	X	72
5.0				4SS	X	>50
6.0					5SS	X
7.0	ML-SILT(TILL), some clay and sand, little gravel, stoney, very hard, brown, damp - moist	312.43		6SS	X	36
8.0				7SS	X	36
8.23	END OF HOLE @ 8.23 m BGS.	309.38		8SS	X	69
9.0						
10.0						
11.0						
12.0						
13.0						

NOTES: MEASURING POINT ELEVATIONS MAY CHANGE; REFER TO CURRENT ELEVATION TABLE

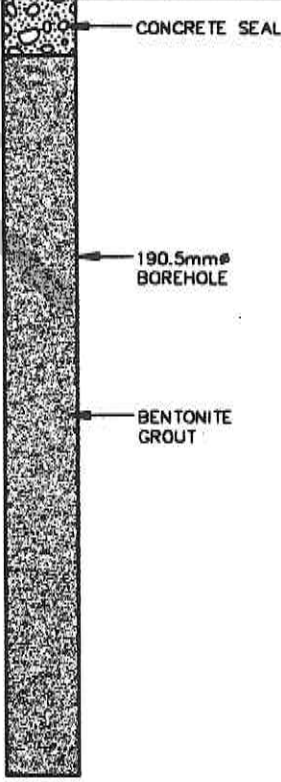
GRAIN SIZE ANALYSIS ○ WATER FOUND ∇ STATIC WATER LEVEL ▼

STRATIGRAPHIC AND INSTRUMENTATION LOG (OVERBURDEN)




(L-30)

PROJECT NAME: ST. MARY'S LANDFILL
 PROJECT NO.: 0645
 CLIENT: TOWN OF ST. MARY'S
 LOCATION: AS PER PLAN

HOLE DESIGNATION: BH31-91
 DATE COMPLETED: DECEMBER 13, 1991
 DRILLING METHOD: 95mm ID HSA
 CRA SUPERVISOR: J.C. MUGFORD

DEPTH m BGS	STRATIGRAPHIC DESCRIPTION & REMARKS	ELEVATION m AMSL	MONITOR INSTALLATION	SAMPLE		
				NUMBER	STATE	VALUE
	GROUND SURFACE	316.52				
1.0	ML-SILT(TILL), some sand and clay, trace gravel, hard, brown, damp					
2.0				15S	X	49
3.0	ML/SM-SILT(LACUSTRINE), little fine sand, little to some clay, hard, tan, moist to wet gradational layering - silt with some fine sand (3.20 to 3.51m BGS)	313.78				
4.0		2SS	X	58		
5.0	ML-SILT(TILL), some sand and clay, little gravel, hard, brown, damp	312.25				
6.0				3SS	X	52
7.0	- very hard, dry to damp					
8.0				4SS	X	46
8.0	END OF HOLE @ 8.08 m BGS.	308.44		5SS	X	>100
9.0						
10.0						
11.0						
12.0						
13.0						

NOTES: MEASURING POINT ELEVATIONS MAY CHANGE; REFER TO CURRENT ELEVATION TABLE

GRAIN SIZE ANALYSIS  WATER FOUND  STATIC WATER LEVEL 

Appendix C4
Landfill Test Pit Logs
St. Marys Landfill

Test Pit No	Depth Interval	Soil Description	Soil Sample		Groundwater
			No.	Depth	
TP 1		Elevation: 314.61 masl			No water seepage observed
	0 - 0.25	Medium grey clayey SILT; friable; contains roots; moist (FILL)			
	0.25 - 0.30	Dark grey SILT, organic matter (TOPSOIL)			
	0.30 - 2.10	Medium grey silty CLAY, some sand, some gravel; bedded to 0.66 then massive; stiff to very stiff; moist (TILL) Becoming gravelly at bottom of pit with sandy seams, trace cobbles; wet	S1 S2	0.45 1.0	
TP 2		Elevation: 316.14 masl			No water seepage observed
	0 - 1.75	Light to medium grey gravelly SILT, some clay, some sand, some cobbles; weathered; soft to firm; moist becoming wet around 1.0 m Becoming sandy at bottom of pit Steel pipe in pit bottom (FILL)	S1 S2	1.05 1.75	
TP 3		Elevation: 318.52 masl			No water seepage observed
	0 - 2.70	Medium grey gravelly sandy SILT, trace clay, some cobbles (rounded to subrounded); loose to soft; some caving of pit sidewalls; moist (FILL) Wet seams and inclusions of stiff clay and hard till below 2.2 m	S1 S2 S3	1.05 2.25 2.70	
TP 4		Elevation: 316.34 masl			No water seepage observed
	0 - 0.20	Medium brown SILT, some organic matter (TOPSOIL)			
	0.20 - 2.30	Light brown SILT, some gravel, some sand, trace cobbles, trace boulder; seams of stiff clay; stiff; weathered (FILL)	S1	1.00	
	2.30 - 2.60	Black SILT, some sand; wire fragment; slight odour; moist (FILL)			
TP 5		Elevation: 318.29 masl			No water seepage observed
	0 - 0.60	Light brown cobbly SILT, some sand, some gravel; loose, friable; moist (FILL)			
	0.60 - 1.90	Light grey SILT and fine SAND; low plastic; massive; dense; moist (native waterlaid deposit)	S1	1.40	
	1.90 - 2.00	Medium grey SILT and CLAY, some sand, some gravel, trace cobbles; hard; moist (TILL)	S2	2.00	

Appendix C4
Landfill Test Pit Logs
St. Marys Landfill

Test Pit No	Depth Interval	Soil Description	Soil Sample		Groundwater
			No.	Depth	
TP 6		Elevation: 314.10 masl			No water seepage observed Cattails in water filled depression nearby likely due to poor drainage and not a shallow water table
	0 - 0.70	Light brown silty SAND and GRAVEL, some cobbles; compact; saturated	S1	0.35	
	0.70 - 2.50	Light grey SILT and fine SAND; low plastic; massive; dense; moist (native waterlaid deposit) Becoming saturated around 2.3-2.4 m	S2 S3	1.2 2.5	
TP 7		Elevation: 314.93 masl			No water seepage observed
	0 - 2.20	Light brown sandy, gravelly SILT, some cobbles (rounded/subrounded), trace small boulders; massive; stiff; moist (FILL) Caving sidewalls Becoming saturated around 1.9 m	S1 S2	1.4 2.2	
TP 8		Elevation: 314.62 masl			No water seepage observed
	0 - 0.25	Medium brown SILT and CLAY, some organic matter containing roots; friable; moist to wet (TOPSOIL)			
	0.25 - 1.50	Medium grey-brown SILT and CLAY, trace sand, trace gravel, trace cobbles; fractured to 0.5 m very stiff to hard; moist (TILL)	S1	0.90	
TP 9		Elevation: 314.14 masl			No water seepage observed
	0 - 0.30	Dark brown SILT, some fine sand, some organic matter; wet (TOPSOIL)			
	0.30 - 0.60	Medium brown SILT, fine sand; moist			
	0.60 - 0.75	Medium brown silty fine to coarse SAND & fine GRAVEL; loose to compact; wet	S1	0.65	
	0.75 - 1.40	Light grey silty fine SAND; varved; dense; moist	S2	1.30	
TP 10		Elevation: 312.47 masl			Water seepage around 1.0 m
	0 - 0.15	Medium brown SILT, some sand, some gravel, some organic matter (TOPSOIL)			
	0.15 - 1.00	Medium brown SILT, SAND, GRAVEL (rounded), ROCK fragments (angular) (FILL) Difficult to dig below 1.0 m due to amount of rock rubble	S1	1.00	

Appendix C4
Landfill Test Pit Logs
St. Marys Landfill

Test Pit No	Depth Interval	Soil Description	Soil Sample		Groundwater
			No.	Depth	
TP 11		Elevation: 313.23 masl			No water seepage observed
	0 - 0.30	Medium grey SILT and CLAY, some sand, trace gravel, some organic matter (FILL)			
	0.30 - 1.40	Medium grey CLAY and SILT, some sand, trace gravel, trace cobbles (rounded); weathered to 1.3 m; very stiff to hard; moist (TILL)	S1	1.30	
TP 12		Elevation: 314.14 masl			No water seepage observed
	0 - 0.10	Dark brown SILT, organic matter (TOPSOIL)			
	0.10 - 1.30	Light grey-brown SILT, some clay, trace sand, trace gravel; stiff to very stiff; moist	S1	1.30	
TP 13		Elevation: 315.86 masl			No water seepage observed
	0 - 0.15	Medium grey CLAY and SILT, trace organic matter; loose; moist			
	0.15 - 1.30	Medium grey CLAY and SILT, trace sand, trace gravel, trace cobbles; weathered to 0.7 m; very stiff to hard; moist (TILL)	S1	0.80	
CKD		Elevation: 323.94 masl			No water seepage observed
	0 - 0.30	Dark Brown SILT, some organic matter; moist (TOPSOIL)			
	0.30 - 0.50	Light grey, silt like, loose, dry (cement kiln dust)	S1	0.50	

Logged on November 5, 2015 by J. Rutherford
 All measurements are in metres unless otherwise indicated.
 Soil samples will be retained for three months from date of report.

Well-Material

Outer Casing: 10'6" x 12" T & C
Inner Casing
Screen
Plug
Gravel

Pump

No. 38414 Setting BP-MB 100'
No. Stages 6 Length Bowl 5'-7"
Bowl 10" Size & Lgth. Suction 10' x 8"
Head TF Size Column 2"

Materials or setting details other than standard
Impellers: Trim
Bowl ALL BRONZE. LINE SHAFT & COUPLINGS - St. St. 1/2"

Motor

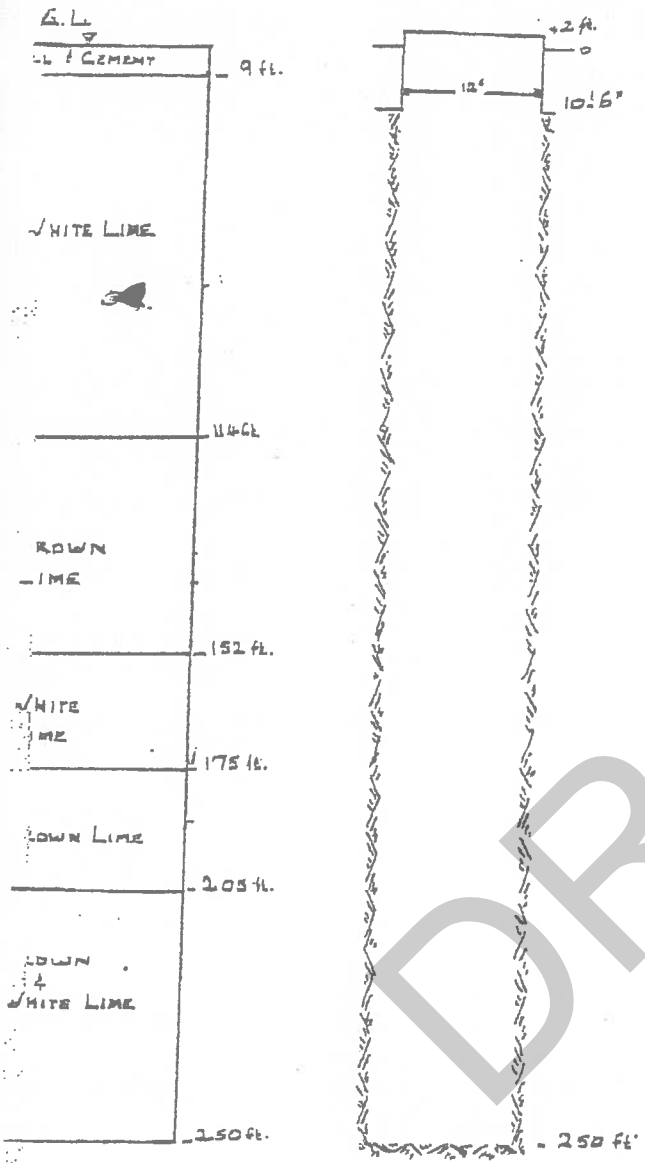
Make G.E. Phase 3
H. P. 60 Cycles 60
R. P. M. 1800 Volts 550
Type K Amps. 58.5
Frame 444-P Serial YPS 1103030
Bearing Nos.

Special Equipment

Installation: Feb. 20, 1958.

Well No. 4

B. P. referred to original ground level +2'
Clear depth below B. P. 249'-10"
Started June 17, 1957 Final Test Feb 20, 1958
Preliminary Test July 2, 1957 Static Level 32'-9"
Final Test _____ Pumping Level 50'
Guarantee _____ 1 GPM Capacity 846 1 GPM
Contract Pressure _____ # Pressure Pump 75 #
Length Air Line 114' Main _____ #



DRAFT

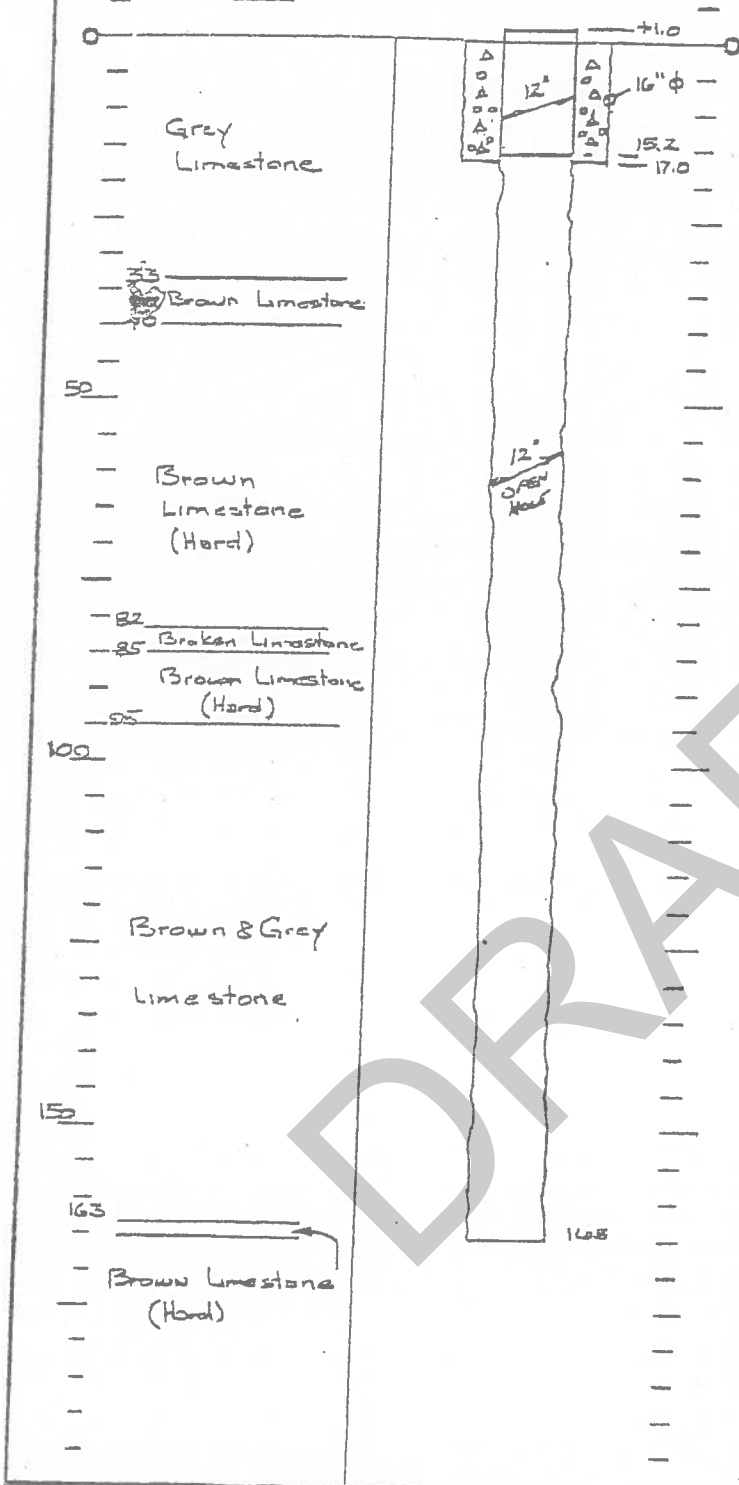
INTERNATIONAL WATER SUPPLY LTD.
MONTREAL LONDON, CANADA SASKATOON
OAKVILLE WATER SUPPLY CONTRACTORS VANCOUVER

ST. MARYS CEMENT CO.
ST. MARYS ONT

DRILLED BY: J. Mc GEEHY DRAWN BY: FCB
INSTALLED BY: G. KAYE APPROVED BY: [Signature]

WELL DIAGRAM

LOG



WELL MATERIAL

Outer Casing: 12 " dia., " Wall Thk. Matl.: ST.
 Cemented from 0' 0" to 17' 0"
 Inner Casing: " dia., " Wall Thk. Matl.:
 Screen: Make " dia., Opening & Matl.:
 Plug: Type, Matl., Other:
 Gravel: Type, Size, Quantity

WELL TEST DATA

Preliminary Test Date: Sept 29/75 by T. Kyle
 Static Level: 5.78 ft. " below M.P. ± 1.70
 Pumping Rate IGM: 785
 Pumping Duration: 2 hrs. min
 Pumping Level at Test End: 33.0 ft (AIR LINE)
 Performance Plots: dd-t Dwg. A-75556
 dd-r Dwg. A-75557

Final Test: Date by
 Rated Well Capacity IGM
 Pumping Rate IGM Static level
 Pumping level " at hrs. min.
 Pump pressure: psi Main pressure psi
 Shut off: AGH psi W.L.
 Clear Well Depth from B.P. " Air Line "

PUMP & MOTOR DATA (cont. Curve)

Pump Make Lyle Rating 625 IGM @ 344' TH
 Head: Type TF 818 S.N. 80911
 Column: 70' X 8" X 1 1/2": Shaft Mil: X
 Bowl: 10THC Stage 2 Curve: 185 193-30
 Suction: 8" dia. 10' 0" Long
 Special: Zinc Sleeves Taped Oil Line
 Other:
 Motor Make: WEST Frame: 404TP SN: 195 7222
 100 HP, 3 ph. 60 hz. 1800 rpm 575
 Bearing No. Upper 7222
 Lower 6314 22C3

Special Equipment

① Amortized Column Pipe In&Out
 ② SS 3" Cone Strainer

WELL REVISIONS AND REHABILITATION

DATE	WORK DONE	BY

International Water Supply Limited

SASKATOON - BARRIE - MONTREAL

CLIENT: ST. MARYS CEMENT CO.

WELL NO: WELL 1/75 (No 6)

DRILLED BY: T. KYLE

DATE: Sept 25

DRAWN: BLH

INSTALLED BY:

DATE:

DATE: OCT 3/75

PROJECT: 04-1112-056

RECORD OF DRILLHOLE: BH-S3

SHEET 1 OF 6

LOCATION: N 4786842.9 ; E 488576.4

DRILLING DATE: Aug. 7, 2003 - Aug. 13, 2003

DATUM: NAD 83

INCLINATION: -90° AZIMUTH: —

DRILL RIG: CME 75

DRILLING CONTRACTOR: ALL-TERRAIN

DEPTH SCALE METRES	DRILLING RECORD	DESCRIPTION	SYMBOLIC LOG	ELEV. DEPTH (m)	RUN No.	PENETRATION RATE (m/min)	FLUSH	COLOUR & RETURN	RECOVERY				DISCONTINUITY DATA			HYDRAULIC CONDUCTIVITY			Diametral Ind. (MPa)		NOTES WATER LEVELS INSTRUMENTATION	
									TOTAL CORE %	SOLID CORE %	R.Q.D. %	FRACT. INDEX PER 3m	B Angle	DIP w.r.t. CORE AXIS	TYPE AND SURFACE DESCRIPTION	K cm/sec	10 ³	10 ²	10 ¹	Ind. 1		Ind. 2
0		GROUND SURFACE		325.03																		
0		UPPER GLACIAL TILL (0.0m to 5.39m) Stiff to hard, medium reddish brown becoming medium dark grey below 3 m, moist, massive textured SILTY CLAY with sand and trace to some matrix supported gravel, occasional cobbles and boulders of limestone, dolostone and igneous composition.	[Symbolic Log]	0.00																	Top of Casing elev. 325.757 Top of Pipe elev. 325.655	
1																						
2	159mm I.D. HOLLOW STEM AUGER																				Concrete Seal in Upper 1m 159mm Borehole	
3																						
4																						
5	August 8, 2003																					
6		GLACIOLACUSTRINE SILT (5.39m to 6.16m) Firm to compact, light grey, moist to wet, dilatent, bedded SILT and CLAYEY SILT.	[Symbolic Log]	318.84 5.39																	123mm Borehole	
7	123mm PQ CORE HOLE	LOWER GLACIAL TILL (6.16m to 18.29m) Hard, medium brownish grey, moist, massive textured SILTY CLAY to CLAYEY SILT with sand and trace to some matrix supported gravel, cobbles and boulders of limestone, dolostone and igneous composition.	[Symbolic Log]	318.87 6.16																	Bentonite Grout	
8																					Sch 40, 51mm dia. flush threaded pvc riser pipe	
9																						
10																						

CONTINUED NEXT PAGE

MISS-ROCK-2 041112056AARCK.GPJ GAL-CANADA.GDT 4/1/05 JDR

DEPTH SCALE

1 : 50



LOGGED: KJC

CHECKED:

PROJECT: 04-1112-056

RECORD OF DRILLHOLE: BH-S3

SHEET 2 OF 6

LOCATION: N 4786842.9 ; E 488576.4

DRILLING DATE: Aug. 7, 2003 - Aug. 13, 2003

DATUM: NAD 83

INCLINATION: -90° AZIMUTH: —

DRILL RIG: CME 75

DRILLING CONTRACTOR: ALL-TERRAIN

DEPTH SCALE METRES	DRILLING RECORD	DESCRIPTION	SYMBOLIC LOG	ELEV. DEPTH (m)	RUN No.	PENETRATION RATE (m/min)	COLOUR % RETURN	RECOVERY			FRACT. INDEX PER 3m	DISCONTINUITY DATA			HYDRAULIC CONDUCTIVITY			Diameter Point Indent (MPa)	RMC -G' AVG	NOTES WATER LEVELS INSTRUMENTATION
								TOTAL CORE %	SOLID CORE %	R.Q.D. %		B Angle	DIP w.r.t CORE AXIS	K _v cm/sec	K _h cm/sec	K _z cm/sec				
10	— CONTINUED FROM PREVIOUS PAGE —	LOWER GLACIAL TILL (6.16m to 18.29m) Hard, medium brownish grey, moist, massive textured SILTY CLAY to CLAYEY SILT with sand and trace to some matrix supported gravel, cobbles and boulders of limestone, dolostone and igneous composition.	[Symbolic Log: Diagonal Hatching]	7																
11				8																
12				9																
13				10																
14				11																
15	August 8, 2003			12																
16	123mm PO CORE HOLE			13																
17				14																
18				15																
19	August 11, 2003			16																
20				17																
18		BEDROCK SURFACE DUNDEE FORMATION	[Symbolic Log: Brick Pattern]	306.74 18.29	1															
19					2															
20	August 12, 2003				3															
		CONTINUED NEXT PAGE																		

MISS-ROCK-2 04112056AARCK.GPJ GAL-CANADA.GDT 4/1/05 JDR

DEPTH SCALE
1 : 50



LOGGED: KJC
CHECKED:

PROJECT: 04-1112-056

RECORD OF DRILLHOLE: BH-S3

SHEET 3 OF 6

LOCATION: N 4786842.9 ;E 488576.4

DRILLING DATE: Aug. 7, 2003 - Aug. 13, 2003

DATUM: NAD 83

INCLINATION: -90° AZIMUTH: —

DRILL RIG: CME 75

DRILLING CONTRACTOR: ALL-TERRAIN

DEPTH SCALE METRES	DRILLING RECORD	DESCRIPTION	SYMBOLIC LOG	ELEV. DEPTH (m)	RUN No.	PENETRATION RATE (m/min)	COLOUR & RETURN	RECOVERY		FRACT INDEX PER .3m	DISCONTINUITY DATA		HYDRAULIC CONDUCTIVITY K, cm/sec	Diametral Point Load Index (MPa)	R.M.C. -2 AVG	NOTES WATER LEVELS INSTRUMENTATION								
								TOTAL CORE %	SOLID CORE %		R.O.D. %	TYPE AND SURFACE DESCRIPTION												
								FLUSH	BD - Bedding FO - Foliation CO - Contact OR - Orthogonal CL - Cleavage		PL - Planar CU - Curved UN - Undulating ST - Stepped IR - Irregular	PD - Polished K - Slickensided SM - Smooth Ro - Rough MB - Mechanical Breakermarks					BR - Broken Rock							
— CONTINUED FROM PREVIOUS PAGE —																								
20	123mm PQ CORE HOLE	DUNDEE FORMATION LIMESTONE (18.29m to 24.32m depth) Fresh, weathered on open bedding partings, light creamy grey to light tan grey, very fine to fine grained, non-porous, thin to medium bedded, partly fossiliferous (rugose corals) LIMESTONE. Limestone tends to separate on open bedding partings. Formation has sharp basal contact. □ from 18.29 to 23.10 m, predominately very fine to fine grained thin to medium bedded creamy grey limestone □ from 23.10 to 24.32 bioturbated limestone with numerous burrow casts	[Symbolic Log: Bricks]	3												Monitoring well pipe								
21																	Bentonite Grout							
22																		Bentonite gravel seal						
23																			PVC Washer					
24																				Open 96mm Drillhole				
25																					UPPER LUCAS FORMATION LIMESTONE (25.91m to 37.19m) Fresh, weathered on open bedding partings, light to medium tan to brownish grey, interbedded very fine to fine grained, non-porous to faintly porous, locally pitted to vuggy, thin to medium bedded, laminar textured (stromatolitic) in part and locally oolitic, weakly stylolitic, partly fossiliferous LIMESTONE with dark tan sections of porous, faintly petroliferous limestone. Basal contact marked by porous horizon. □ from 24.32 to 25.37 m laminar textured limestone with soft sediment slump structures □ from 25.37 to 25.65 m Dundee Marker Bed, medium grey, mottled lithoclastic dolostone with rip-up clasts at base. □ from 30.57 to 30.80 m medium grey, mottled porous to pitted dolostone marker bed, sharp basal contact □ from 31.73 to 31.94 m dark grey, porous, laminar, faintly petroliferous argillaceous dolostone bed			
26																						300.71 24.32		
27																							289.66 25.37 289.38 25.65 289.12 25.91	
28																								August 12, 2003
29																								
30	CONTINUED NEXT PAGE																							

MISS-ROCK-2 041112056AARCK.GPJ GAL-CANADA.GDT 4/1/05 JDR



PROJECT: 04-1112-056

RECORD OF DRILLHOLE: BH-S3

SHEET 4 OF 6

LOCATION: N 4786842.9 E 488576.4

DRILLING DATE: Aug. 7, 2003 - Aug. 13, 2003

DATUM: NAD 83

INCLINATION: -90° AZIMUTH: —

DRILL RIG: CME 75

DRILLING CONTRACTOR: ALL-TERRAIN

DEPTH SCALE METRES	DRILLING RECORD	DESCRIPTION	SYMBOLIC LOG	ELEV.		RUN No.	PENETRATION RATE (m/min)	FLUSH % RETURN	RECOVERY		R.Q.D. %	FRACT. INDEX PER 3m	DISCONTINUITY DATA		HYDRAULIC CONDUCTIVITY K, cm/sec	Diameter Index (MPa)	RMC % AVG.	NOTES WATER LEVELS INSTRUMENTATION	
				DEPTH (m)					TOTAL CORE %	SOLID CORE %			B Angle	DIP w.r.t CORE AXIS					TYPE AND SURFACE DESCRIPTION
30		-- CONTINUED FROM PREVIOUS PAGE --																	
					294.46														
					30.57														
					294.23														
					30.80														
31																			
32	August 12, 2003	UPPER LUCAS FORMATION DOLOMITIC LIMESTONE (25.91m to 37.19m) Fresh, weathered on open bedding partings, light to medium tan to brownish grey, interbedded very fine to fine grained, non-porous to faintly porous, locally pitted to vuggy, thin to medium bedded, laminar textured (stromatolitic) In part and locally oolitic, weakly stylolitic, partly fossiliferous dolomitic LIMESTONE with dark tan sections of porous, faintly petroliferous limestone. Basal contact marked by porous horizon · from 30.57 to 30.80 m medium grey, mottled porous to pitted dolostone marker bed, sharp basal contact · from 31.73 to 31.94 m dark grey, porous, laminar, faintly petroliferous argillaceous dolostone bed			293.30														
					31.73														
					293.09														
					31.94														
33																			
34																			
35		UPPER LUCAS FORMATION becomes dolomitic limestone from 30.57 m to 37.19 m																	
36																			
37	August 13, 2003	LOWER LUCAS FORMATION DOLOSTONE (37.19m to 50.44m) Transitional contact with overlying strata Fresh, faintly weathered in some beds, moderately weathered on open bedding partings, light to medium tan to brownish grey, very fine to fine grained, non-porous to faintly to moderately porous, thin to medium bedded laminar textured DOLOSTONE with faintly petroliferous beds. · from 37.19m to 37.34m dark brownish grey, argillaceous dolostone · from 38.05m to 38.19m angular intraformational dolostone breccia · from 38.79m to 39.03m dark grey argillaceous partings and brown porous, faintly petroliferous dolostone with void at 39.03m where drill water circulation lost			287.84														
					37.19														
					37.34														
38					286.98														
					38.05														
					38.19														
39					286.24														
					38.79														
					286.00														
					39.03														
					285.57														
					39.50														
40																			
		CONTINUED NEXT PAGE																	

MISS-ROCK-2 041112056AARCK.GPJ GAL-CANADA.GDT 4/1/05 JDR

DEPTH SCALE

1 : 50



LOGGED: KJC

CHECKED:

PROJECT: 04-1112-056

RECORD OF DRILLHOLE: BH-S3

SHEET 6 OF 6

LOCATION: N 4786842.9 ; E 488576.4

DRILLING DATE: Aug. 7, 2003 - Aug. 13, 2003

DATUM: NAD 83

INCLINATION: -90° AZIMUTH: —

DRILL RIG: CME 75

DRILLING CONTRACTOR: ALL-TERRAIN

DEPTH SCALE METRES	DRILLING RECORD	DESCRIPTION	SYMBOLIC LOG	ELEV. DEPTH (m)	RUN No.	PENETRATION RATE (m/min)	FLUSH	COLOUR	RETURN	JN - Joint		BD - Bedding		PL - Planar		PO - Polished		BR - Broken Rock		NOTES: For additional abbreviations refer to list of abbreviations & symbols.	WATER LEVELS INSTRUMENTATION	
										FLT - Fault	FO - Foliation	CU - Curved	K - Slickensided	UN - Undulating	SM - Smooth	Ro - Rough	MB - Mechanical Breakevents					
										SHR - Shear	CO - Contact	ST - Stepped	Ro - Rough	ST - Stepped	Ro - Rough	MB - Mechanical Breakevents						
50		— CONTINUED FROM PREVIOUS PAGE —																				
		LOWER LUCAS FORMATION CONTINUED		274.59	22																	Open 96mm Drillhole
		END OF BOREHOLE		50.44																		
51																						
52																						
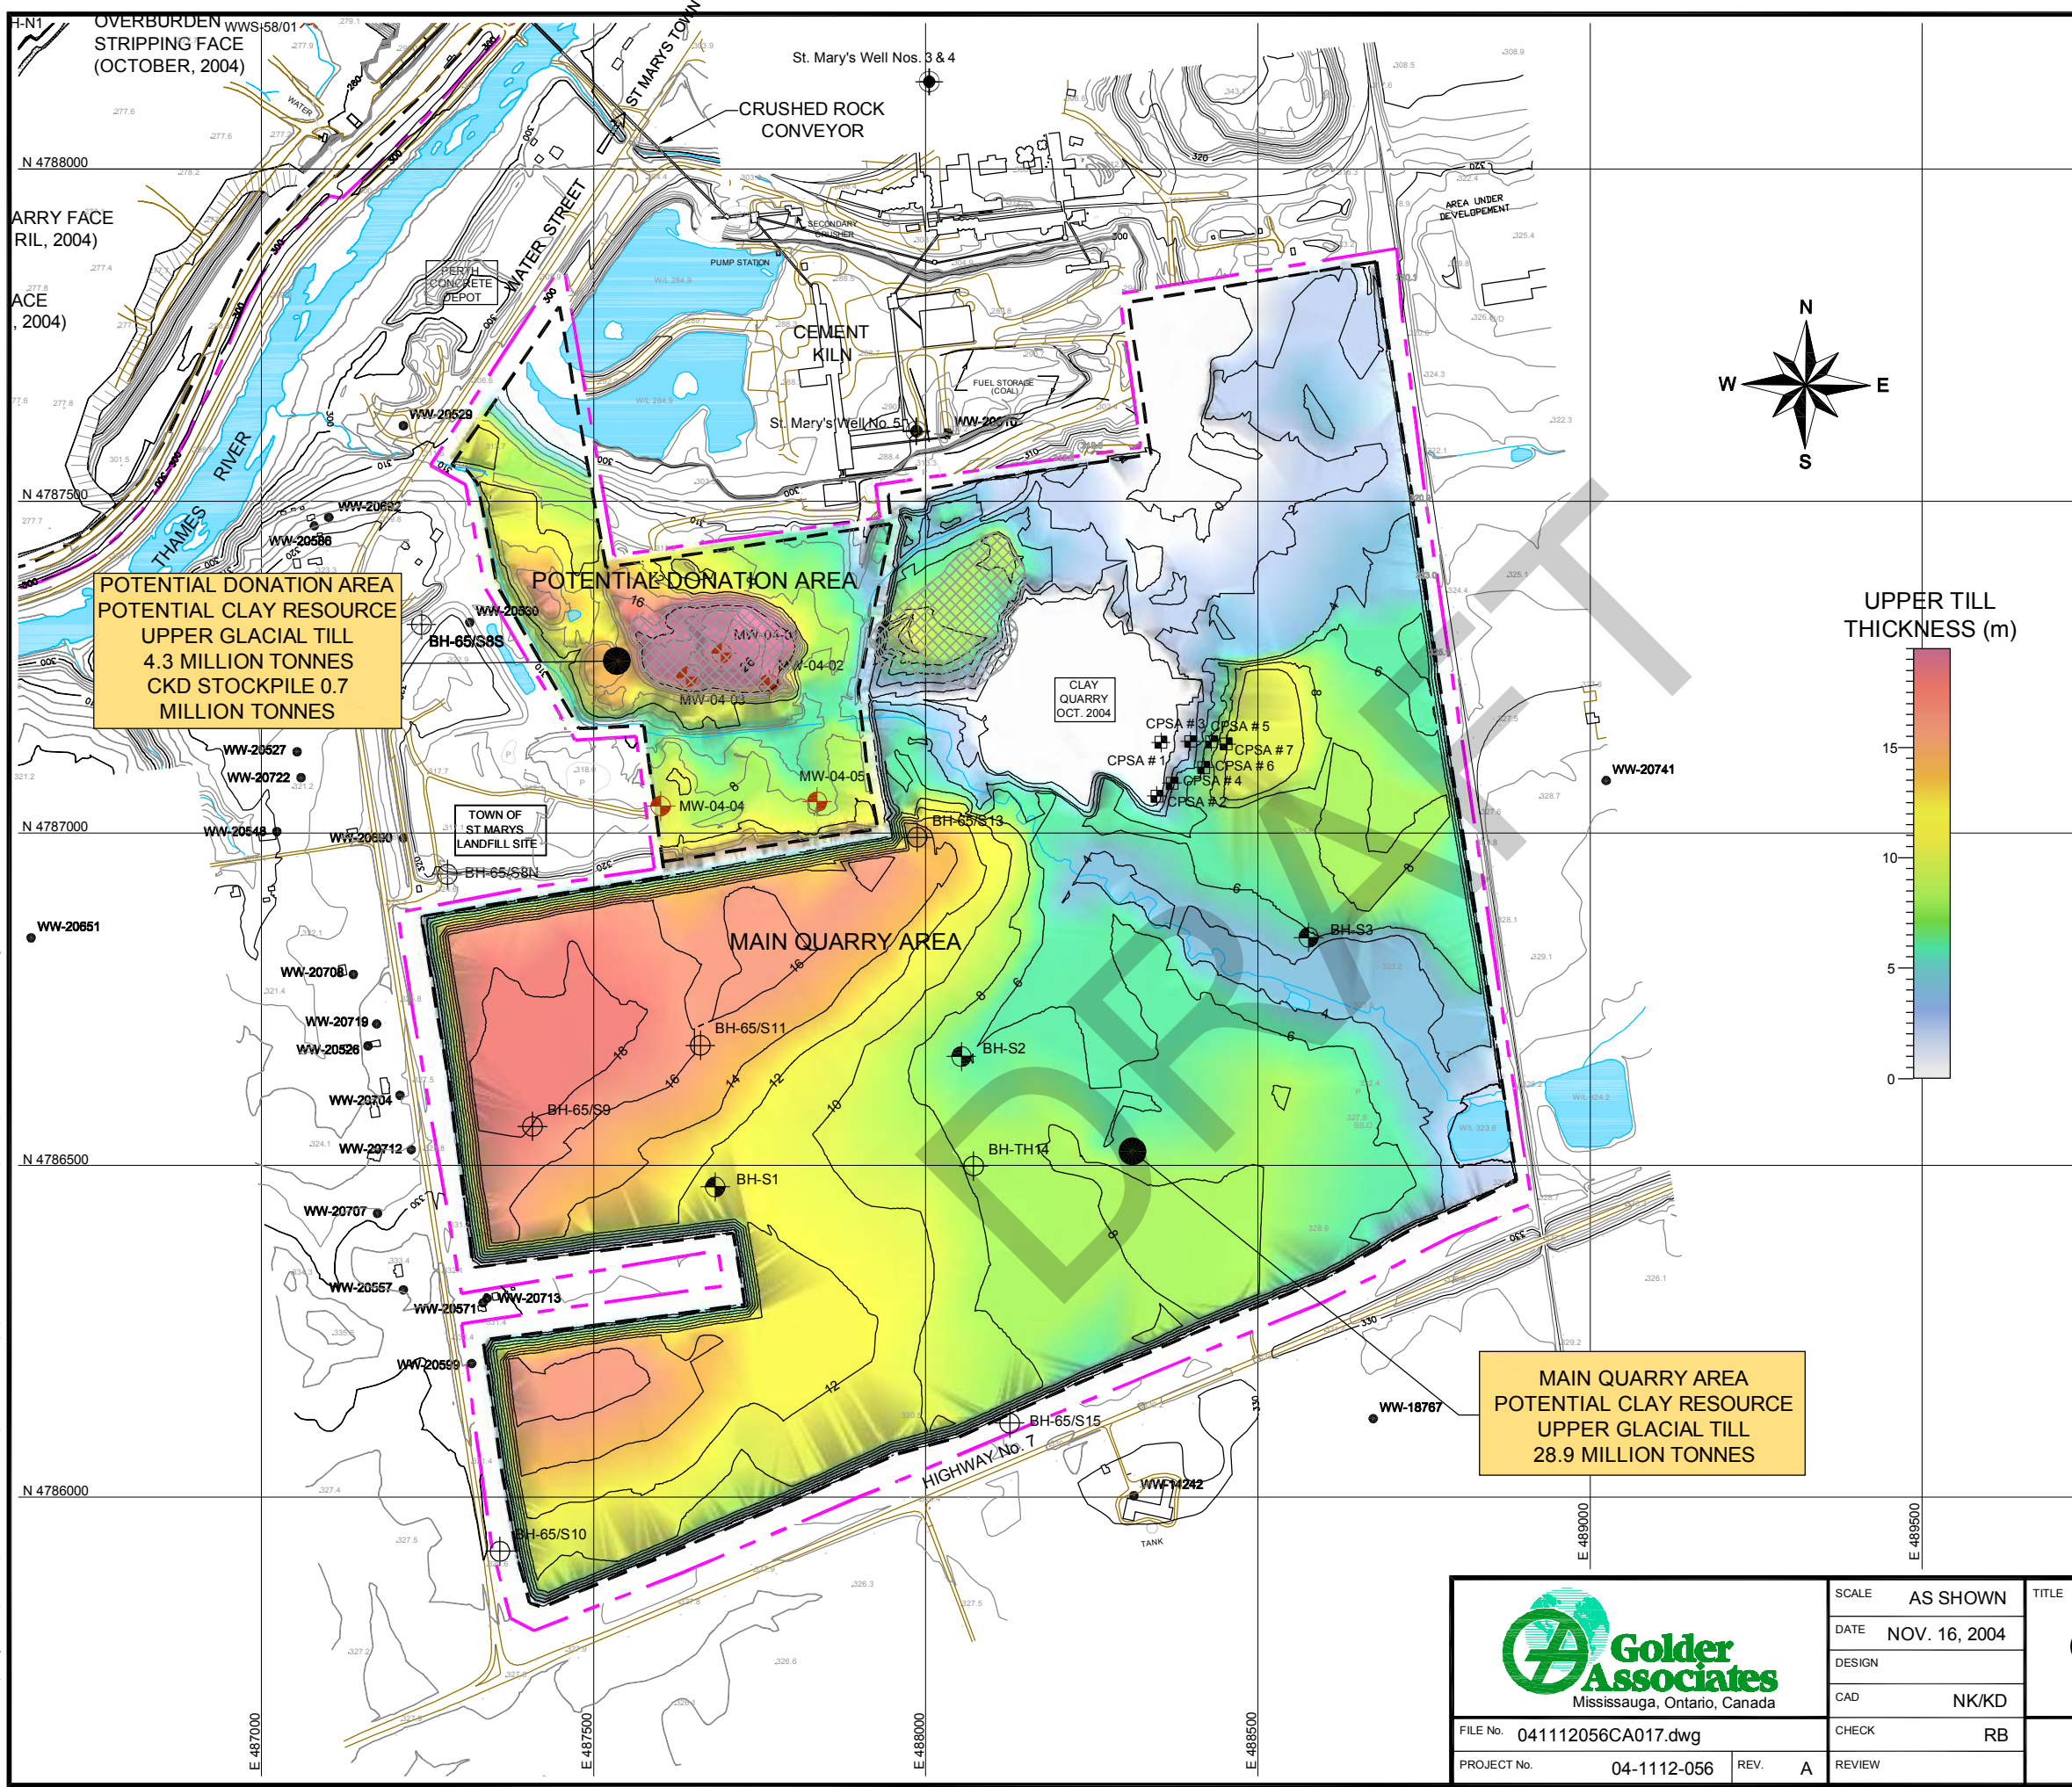
MISS-ROCK-2 041112056AARCK.GPJ GAL-CANADA.GDT 4/1/05 JDR

DEPTH SCALE
1 : 50




LOGGED: KJC
CHECKED:

PLOT DATE: November 22, 2004
 FILENAME: T:\Projects\2004\04-1112-056 (SCC, Ontario)\-CA- Combined Reports\041112056CA017.dwg



LEGEND

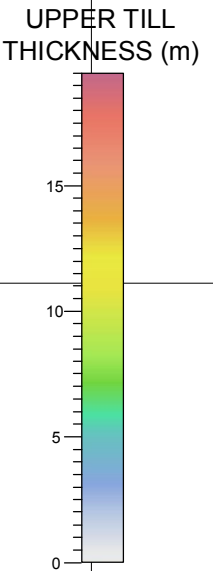- QUARRY LICENCE BOUNDARY
- QUARRY EXCAVATION SETBACK
- BOREHOLE LOCATION FROM CURRENT INVESTIGATION FOR LANDFILL AREA, REPORT GOLDR NO. 04-1112-047
- TEST PITS LOCATION FROM CURRENT INVESTIGATION, 2004
- BOREHOLE LOCATION DRILLED BY GOLDR, 2000
- WATER WELL SUPPLY LOCATION - MINISTRY OF ENVIRONMENT (MOE) WWIS DATABASE
- BOREHOLE LOCATION - DRILLED BY ST. MARY'S CEMENT, 1965
- MUNICIPAL / INDUSTRIAL WATER SUPPLY WELLS
- CKD STOCKPILE




- NOTES**
1. THIS FIGURE IS TO BE READ IN CONJUNCTION WITH THE ATTACHED REPORT.
 2. THE CURRENT EXCAVATION FACE AT THE QUARRY WAS SURVEYED BY AGM SURVEYING AND ENGINEERING, DRAWING No. SM 0412T1.dwg (OCTOBER, 2004).
 3. THE TEST PITS WERE SURVEYED BY AGM SURVEYING AND ENGINEERING BY REPORT No. SM-CEM-34 (SEPTEMBER, 2004).
 4. LOCATIONS OF 1958, 1965 AND 1974 BOREHOLES AND MOE WELLS ARE APPROXIMATE ONLY.
 5. TONNAGE ESTIMATES BASED ON VOLUMES WITH BULK DENSITY OF 2.0 T/m³ FOR SOIL.

REFERENCE

BASE MAP FROM ST. MARYS CEMENT INC. TOPOGRAPHIC SURVEY UPDATED SEPTEMBER 2004, DRAWING No. MP 001 V.01 (3D CONTOURS), UTM NAD83.

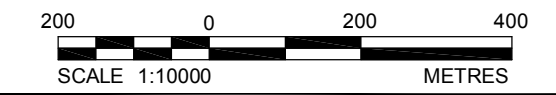OCTOBER 2004 SURVEY OF THOMAS ST. QUARRY FACE AND OVERBURDEN STRIPPING FACE AND SOUTH QUARRY CLAY PIT OBTAINED FROM AGM, FILE NAME SM0412T1.DWG, DATED OCT. 7, 2004, SCALE 1:2000.




**MAIN QUARRY AREA
 POTENTIAL CLAY RESOURCE
 UPPER GLACIAL TILL
 28.9 MILLION TONNES**

**POTENTIAL DONATION AREA
 POTENTIAL CLAY RESOURCE
 UPPER GLACIAL TILL
 4.3 MILLION TONNES
 CKD STOCKPILE 0.7
 MILLION TONNES**

<p>Golder Associates Mississauga, Ontario, Canada</p>	SCALE AS SHOWN	<p>TITLE</p> <p>INFERRED THICKNESS OF POTENTIAL CLAY RESOURCE SOUTH QUARRY</p>
	DATE NOV. 16, 2004	
FILE No. 041112056CA017.dwg	DESIGN	<p>ST. MARY'S CEMENT Co.</p>
PROJECT No. 04-1112-056	CAD NK/KD	
REV. A	CHECK RB	FIGURE 17
	REVIEW	

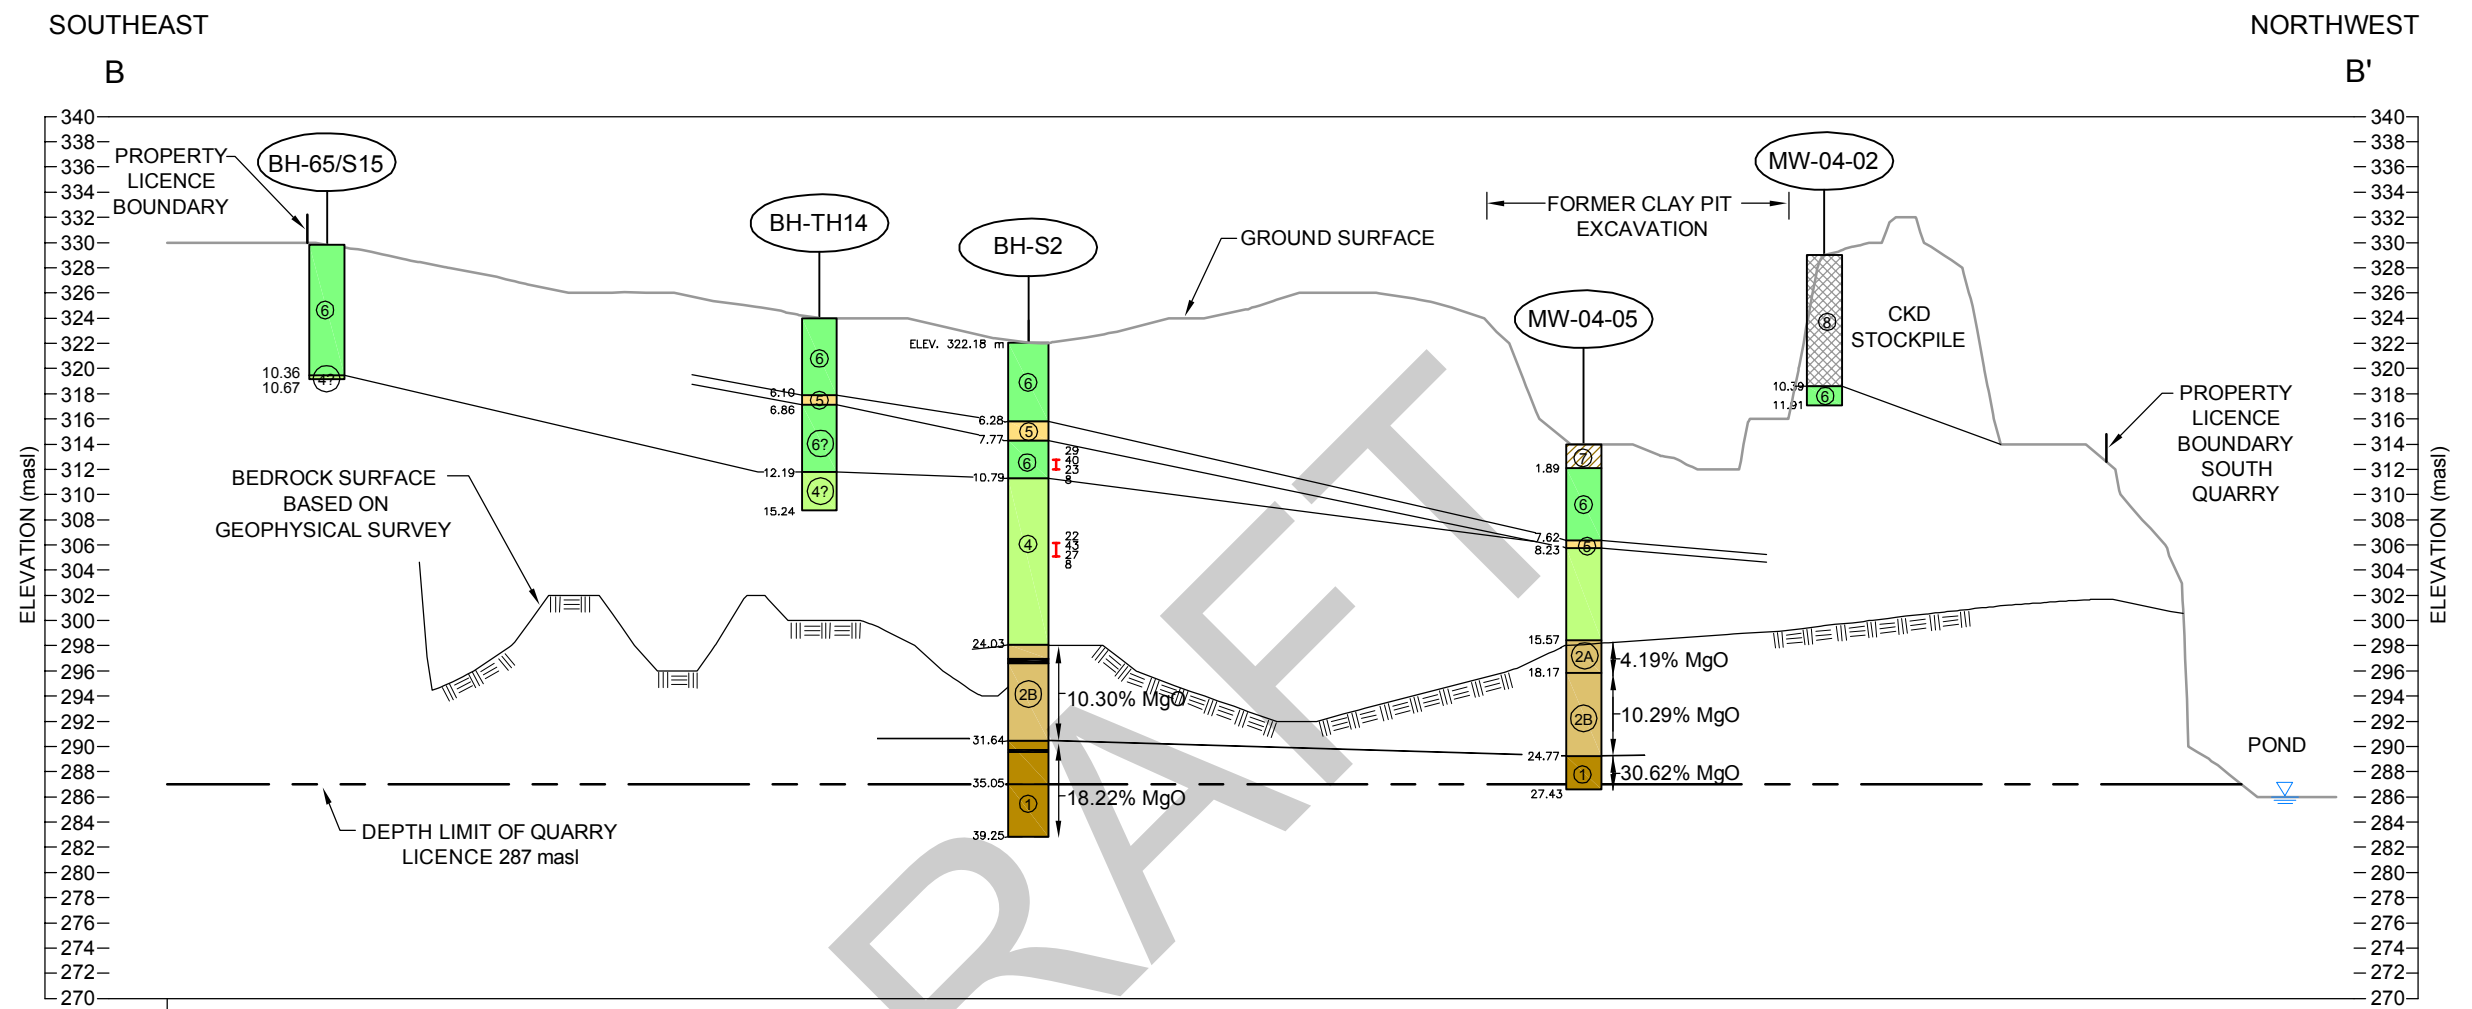PLOT DATE: November 22, 2004
 FILENAME: T:\Projects\2004\04-1112-056 (SCC,Ontario)\04-1112-056 -CA- Combined Reports\041112056CA014.dwg



STRATIGRAPHY

SURFICIAL DEPOSITS

- FILL, loose to compact, grey, silt to sand, cement kiln dust
- FILL, loose to compact, brown, silty sand to sand and gravel
- UPPER GLACIAL TILL Very stiff to hard, medium dark grey, moist, massive textured, well graded SILTY CLAY with sand and trace to some matrix support gravel and occasional cobbles of limestone, dolostone, igneous composition.
- MIDDLE GLACIOLACUSTRINE SILT Firm to compact, light grey, moist to wet, dialatent, massive textured, well graded to thinly bedded SILT and CLAYEY SILT.
- LOWER GLACIAL TILL Hard, medium brownish grey, moist to dry appearing, massive textured SILTY CLAY to CLAYEY SILT with sand and trace to some matrix supported gravel, occasional cobbles and boulders of limestone, dolostone and igneous composition. Cobbles and boulders increase to 10 to 20 percent near base of sequence.

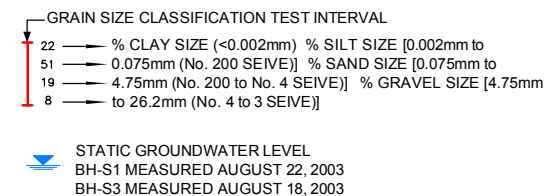
BEDROCK DEPOSITS

- DUNDEE FORMATION LIMESTONE Fresh, weathered on open bedding partings, light creamy grey to light tan grey, very fine to fine grained, non-porous, thin to medium bedded, partly fossiliferous (rugose corals) LIMESTONE (3A) and Dolomitic Limestone (3B) Limestone tends to separate on open bedding partings.
- UPPER LUCAS FORMATION DOLOMITIC LIMESTONE Fresh, weathered on open bedding partings, light to medium tan to brownish grey, interbedded very fine to fine grained, non-porous to faintly porous, locally pitted to vuggy, thin to medium bedded, laminar textured (stromatolitic) in part and locally oolitic, weakly stylolitic, partly fossiliferous LIMESTONE (2A) and Dolomitic Limestone (2B) with dark tan sections of porous, faintly petroliferous limestone.
- LOWER LUCAS FORMATION DOLOSTONE Fresh, faintly weathered in some beds, moderately weathered on open bedding partings, light to medium tan to brownish grey, very fine to fine grained, faintly to moderately porous, thin to medium bedded, laminar textured DOLOMITIC LIMESTONE to DOLOSTONE with faintly petroliferous beds.



NOTE

FOR LOCATION OF SECTION B - B' REFER TO FIGURE 10

LEGEND



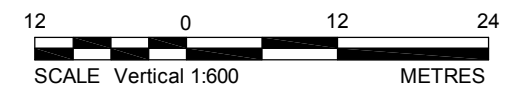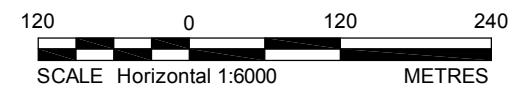12.49% MgO LENGTH AVERAGED MAGNESIUM OXIDE PERCENT CONCENTRATION OF SOIL AND BEDROCK BASED ON WHOLE ROCK ANALYSES



SCALE	AS SHOWN
DATE	NOV. 15, 2004
DESIGN	
CAD	KD
CHECK	RB
REVIEW	

SUB-SURFACE CONDITIONS SECTION B-B' SOUTH QUARRY

FILE No. 041112056CA014.dwg
PROJECT No. 04-1112-056 REV. A


ST. MARY'S CEMENT Co.

GRAIN SIZE DISTRIBUTION

ST. MARY'S LANDFILL SITE - 979-645.

OW4-80 - 2.5 FEET.

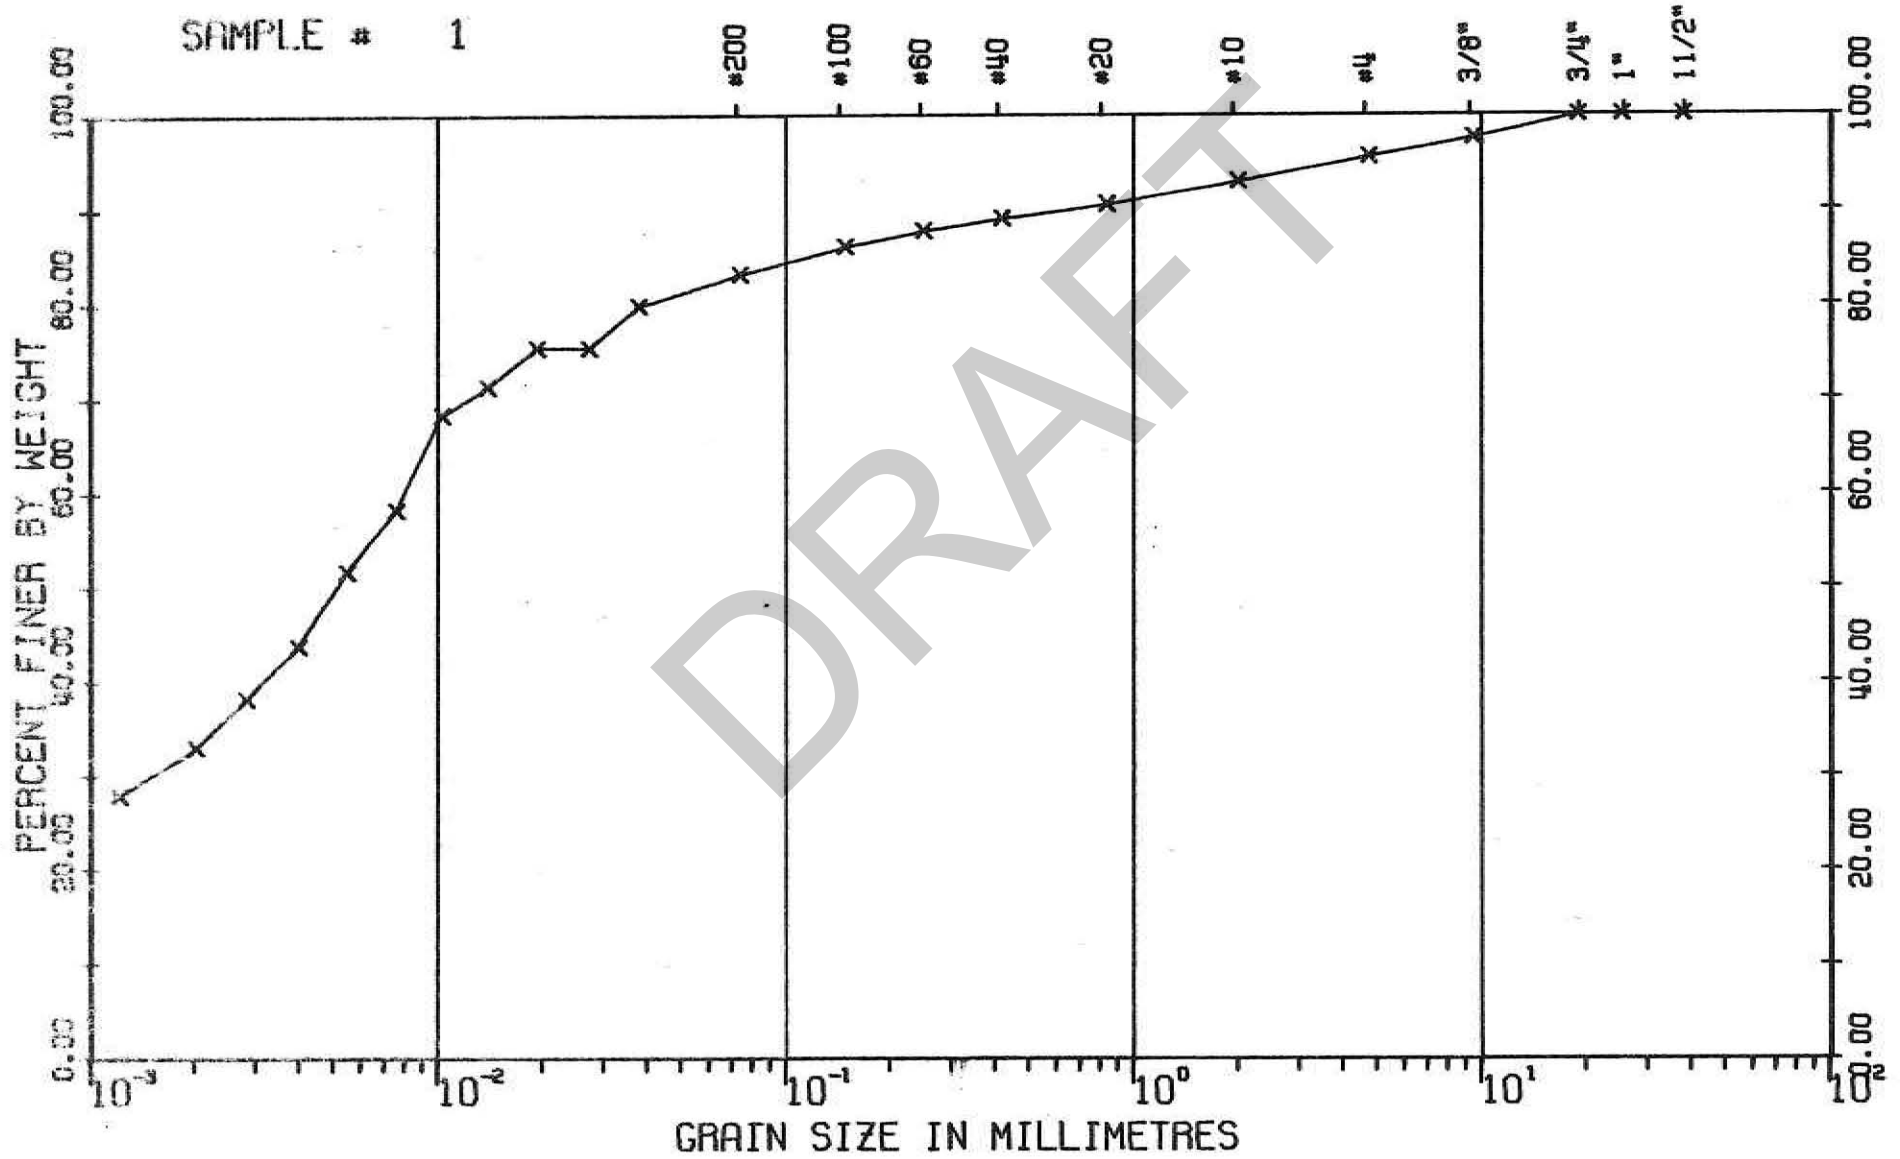SAMPLE # 1




GRAIN SIZE DISTRIBUTION

ST. MARY'S LANDFILL. 979-645

OW4-80 - 5 FEET.

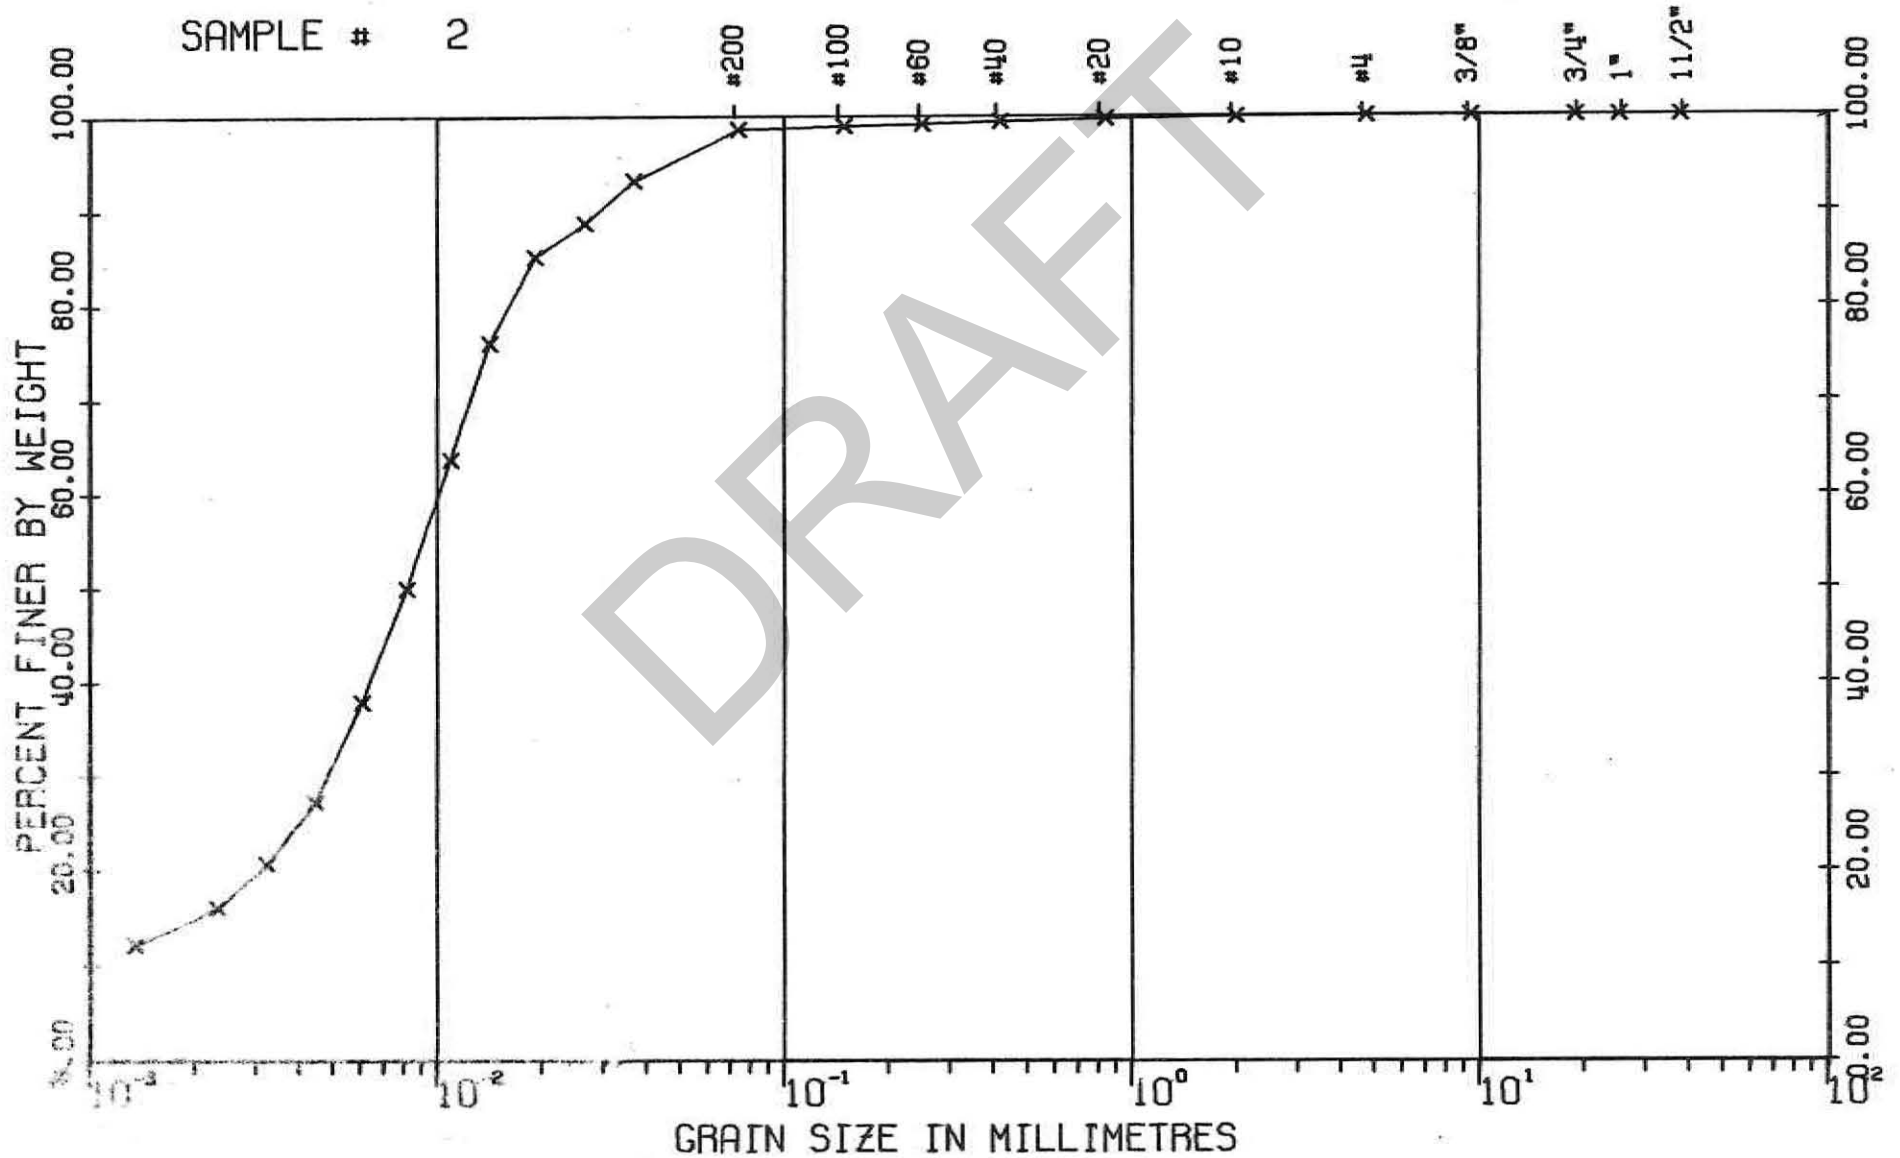SAMPLE # 2




GRAIN SIZE DISTRIBUTION

ST. MARY'S LANDFILL. 979-645

OW4-80 - 17.5 FEET.

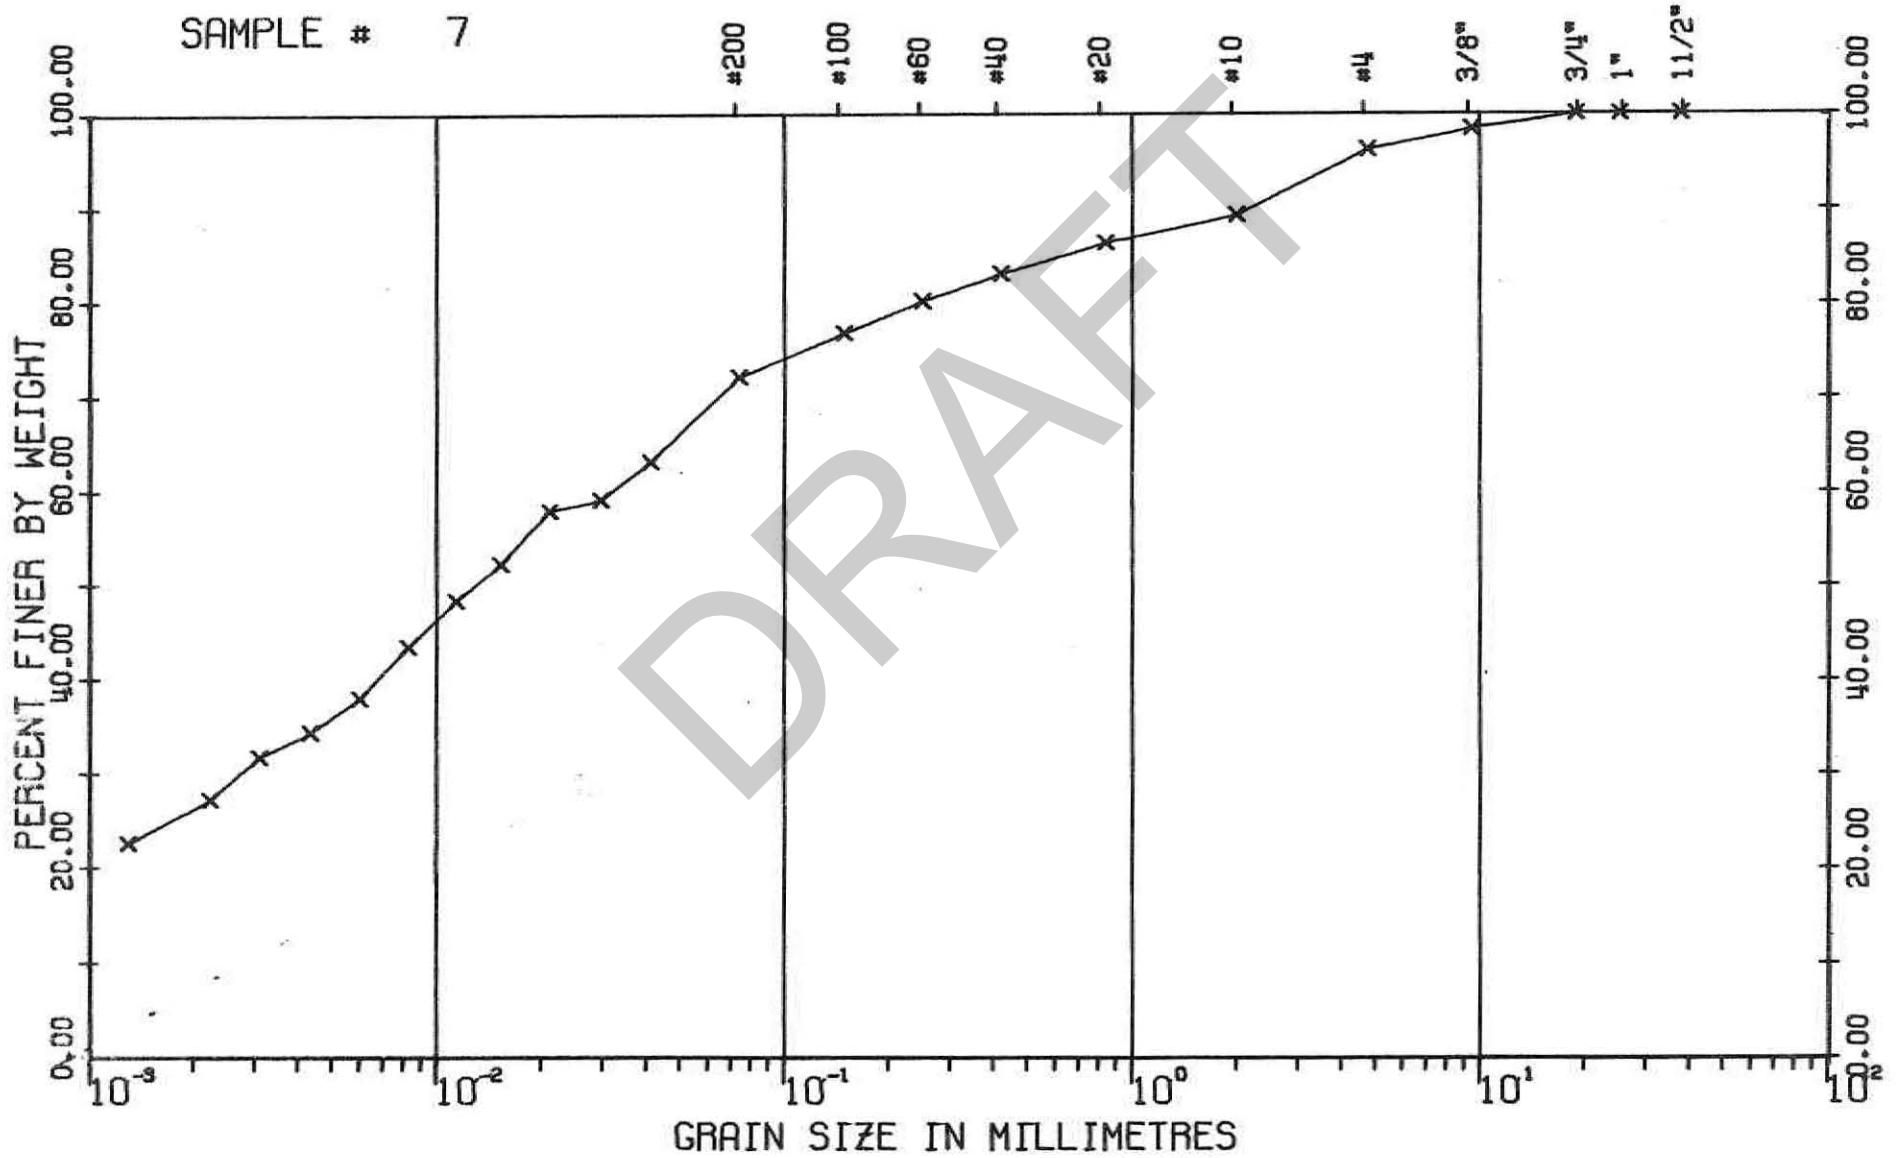SAMPLE # 7




GRAIN SIZE DISTRIBUTION

ST. MARY'S LANDFILL, 979-645


OW1-80 - 20 FEET.

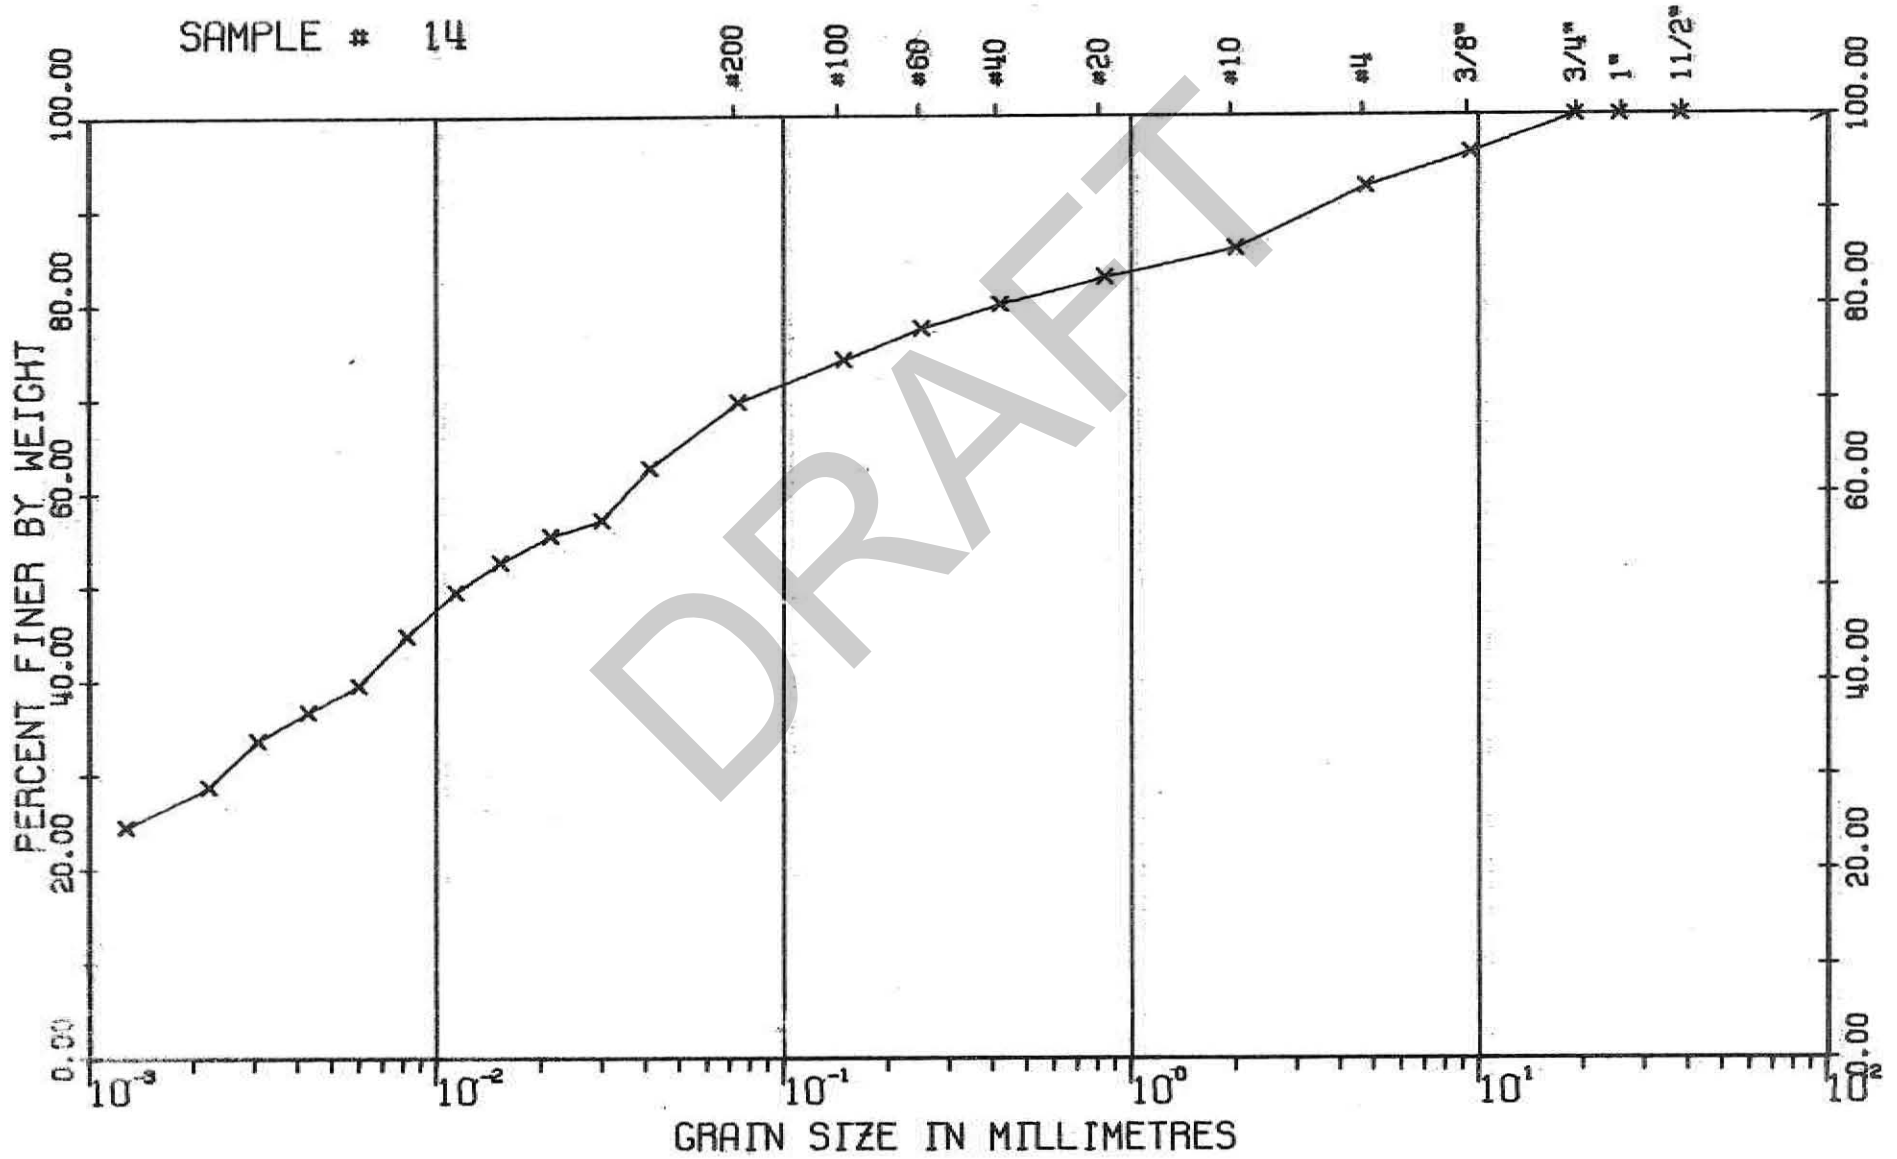SAMPLE # 14



GRAIN SIZE CURVE

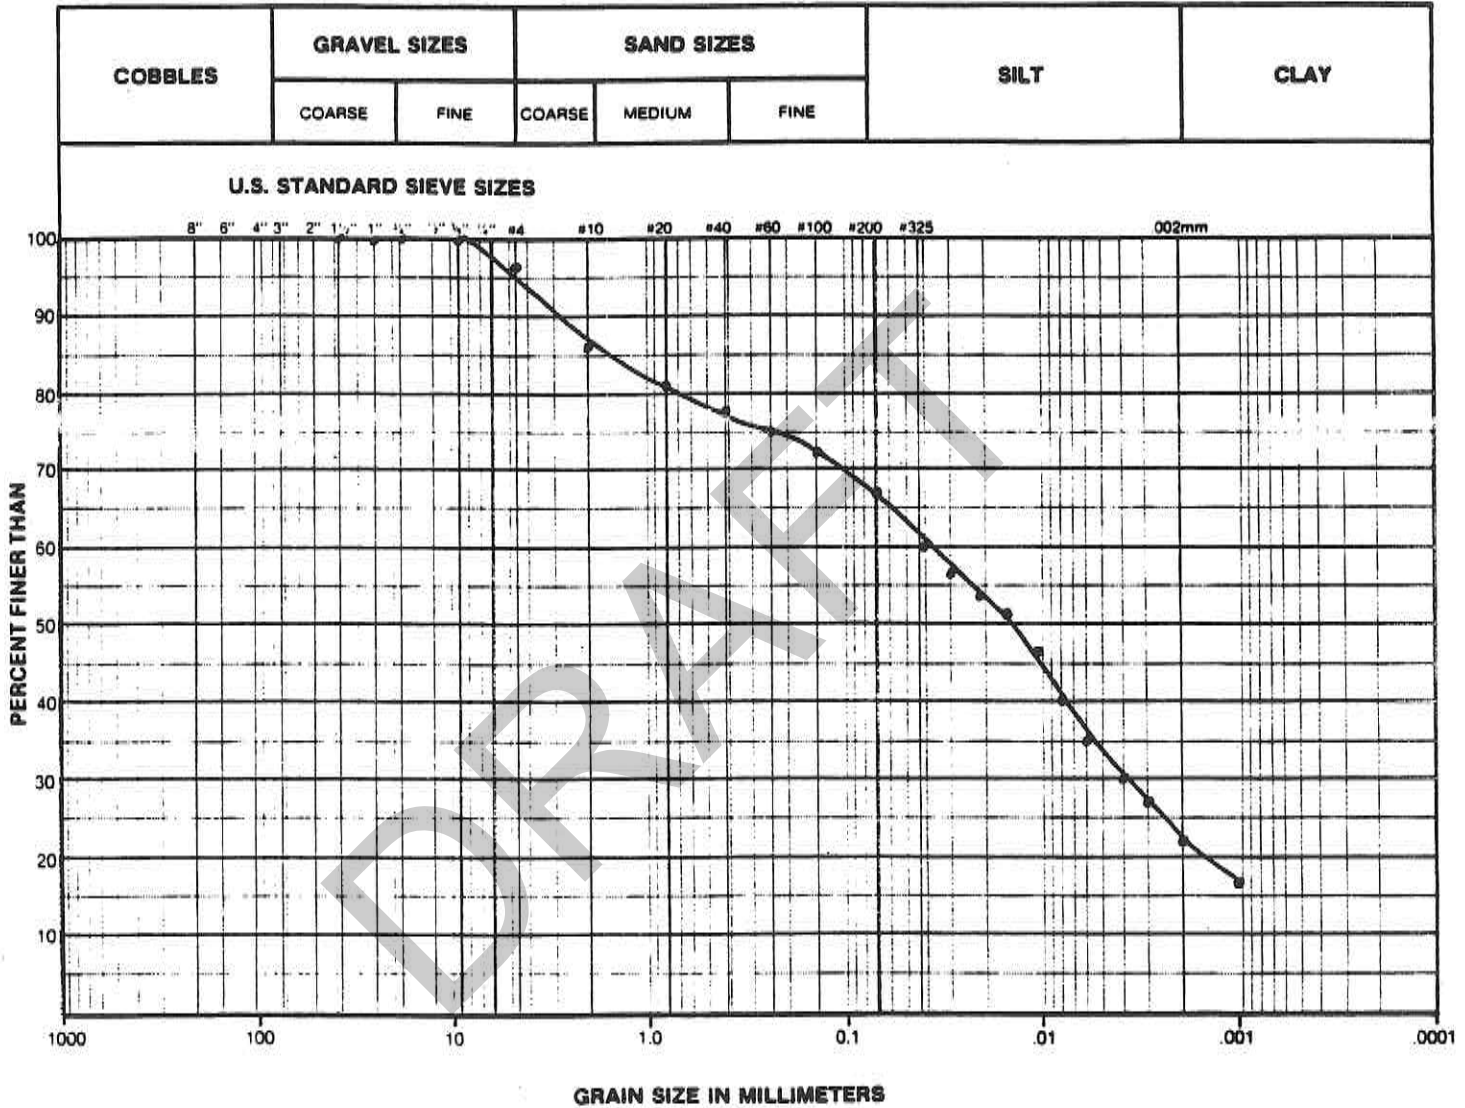CLIENT: ST. MARY'S LF
 PROJECT NUMBER: 0645
 LAB. NUMBER: CR. 3582
 LOCATION: BH10-91
 HOLE: — SAMPLE: 2CS
 DEPTH: 4-7 FT.
 TECHNICIAN: T. GERARDI DATE: NOVEMBER 4/91



HAZEN PERMEABILITY ESTIMATE $(D_{10})^2 = 4.8E-07$ cm/sec

NOTE: D_{10} = GRAINSIZE IN mm AT 10% FINER THAN


REMARKS: SILT, SOME SAND, LITTLE CLAY
TRACE GRAVEL

NOTE: UNIFIED SOIL CLASSIFICATION SYSTEM

SOIL CLASSIFICATION DESCRIPTIVE MODIFIERS		SUMMARY
AND	36-50 %	GRAVEL <u>3.77</u> %
SOME	21-35 %	SAND <u>28.68</u> %
LITTLE	11-20 %	SILT <u>46.66</u> %
TRACE	1-10 %	CLAY <u>20.88</u> %

GRAIN SIZE CURVE

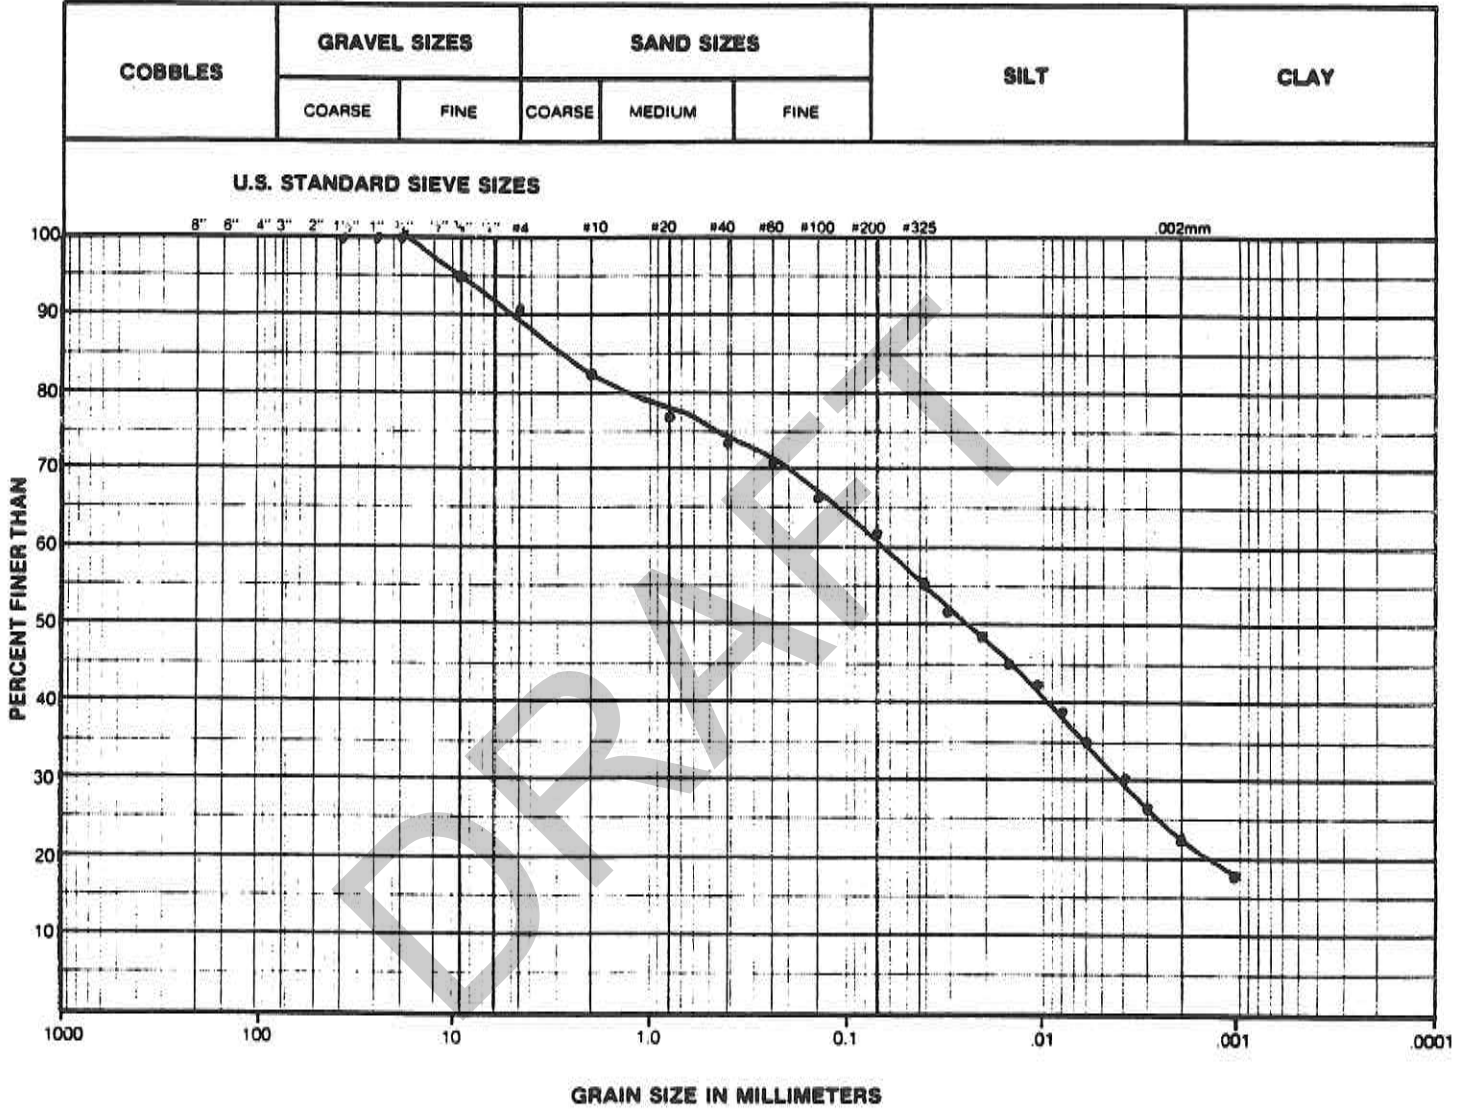CLIENT: ST. MARY'S LF
 PROJECT NUMBER: 0645
 LAB. NUMBER: CR 3583
 LOCATION: BH10-91
 HOLE: — SAMPLE: 6CS
 DEPTH: 24-28 FT
 TECHNICIAN: T. GERARD DATE: NOVEMBER 4/91



HAZEN PERMEABILITY ESTIMATE $(D_{10})^2 = 4.1E-07$ cm/sec

NOTE: D_{10} = GRAINSIZE IN mm AT 10% FINER THAN

REMARKS: SILT, SOME SAND, SOME CLAY
TRACE GRAVEL

NOTE: UNIFIED SOIL CLASSIFICATION SYSTEM

SOIL CLASSIFICATION
 DESCRIPTIVE MODIFIERS


AND 36-50 %
 SOME 21-35 %
 LITTLE 11-20 %
 TRACE 1-10 %

SUMMARY

GRAVEL 9.06 %
 SAND 29.34 %
 SILT 39.94 %
 CLAY 21.66 %

GRAIN SIZE CURVE

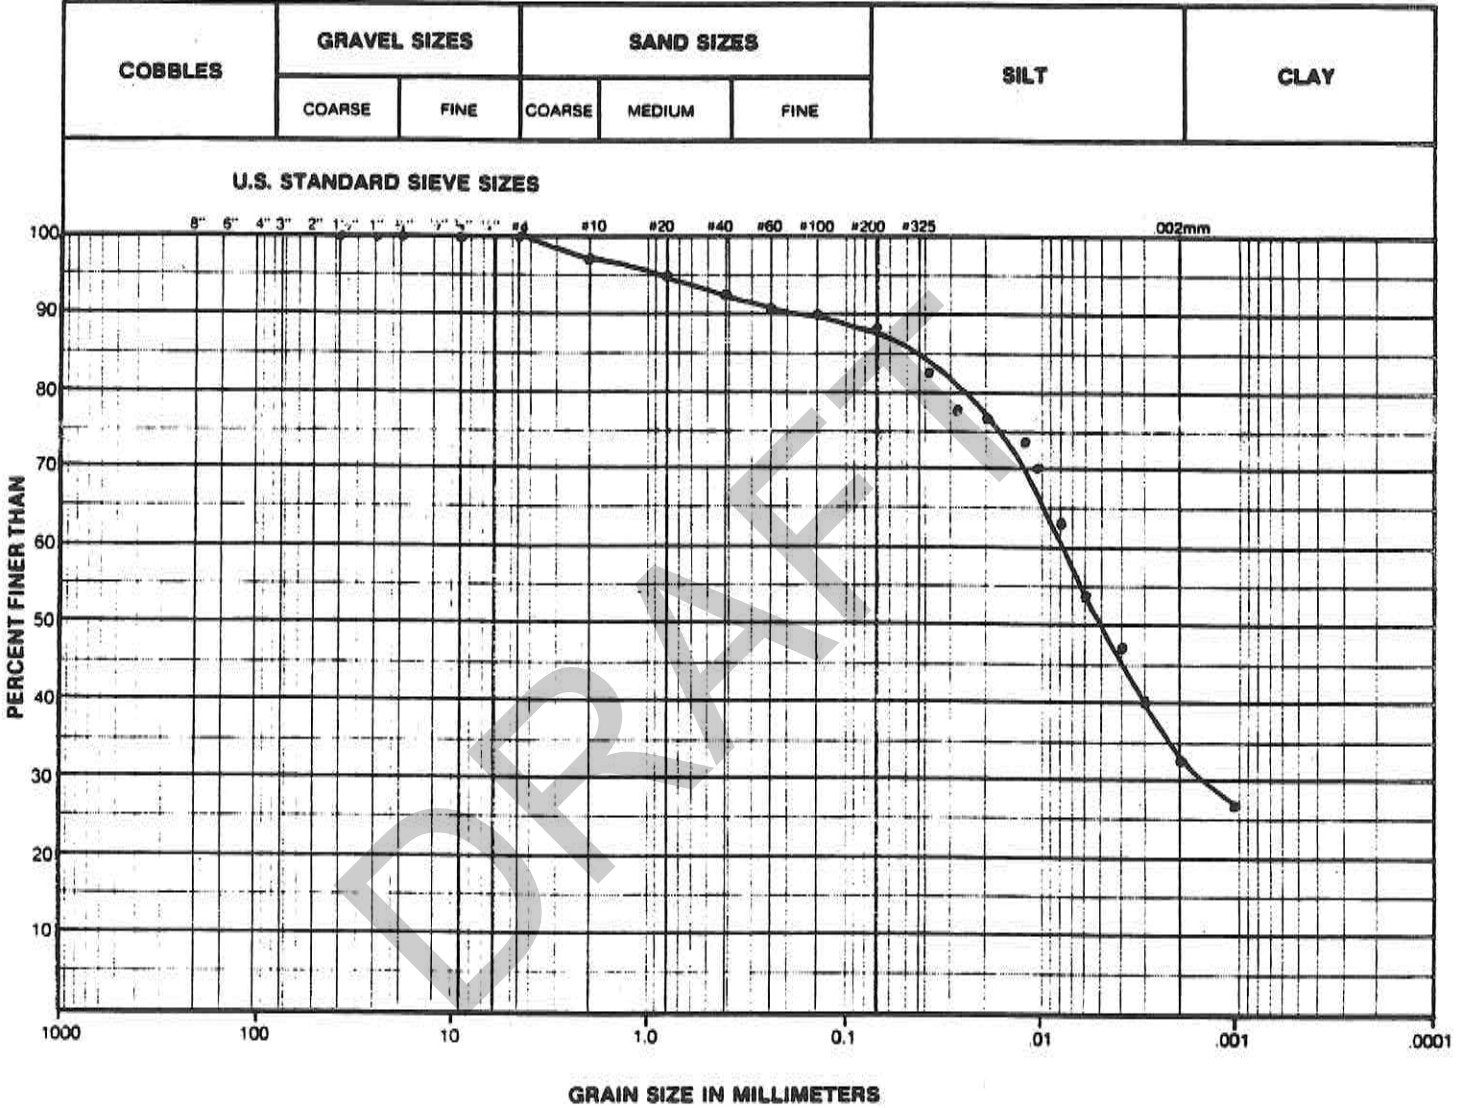CLIENT: *ST. MARY'S LF*
 PROJECT NUMBER: *0645*
 LAB. NUMBER: *CR 3587*
 LOCATION: *BN11-91*
 HOLE: _____ SAMPLE: *JCS*
 DEPTH: *6-10 FT.*
 TECHNICIAN: *T. GERARDI* DATE: *NOVEMBER 4/91*



HAZEN PERMEABILITY ESTIMATE $(D_{10})^2 = 1.1E-07$ cm/sec

NOTE: D_{10} = GRAINSIZE IN mm AT 10% FINER THAN

REMARKS: *SILT, SOME CLAY, LITTLE SAND*

NOTE: UNIFIED SOIL CLASSIFICATION SYSTEM

**SOIL CLASSIFICATION
 DESCRIPTIVE MODIFIERS**


AND 36-50 %
 SOME 21-35 %
 LITTLE 11-20 %
 TRACE 1-10 %

SUMMARY

GRAVEL *0* %
 SAND *12.22* %
 SILT *55.93* %
 CLAY *31.85* %

GRAIN SIZE CURVE

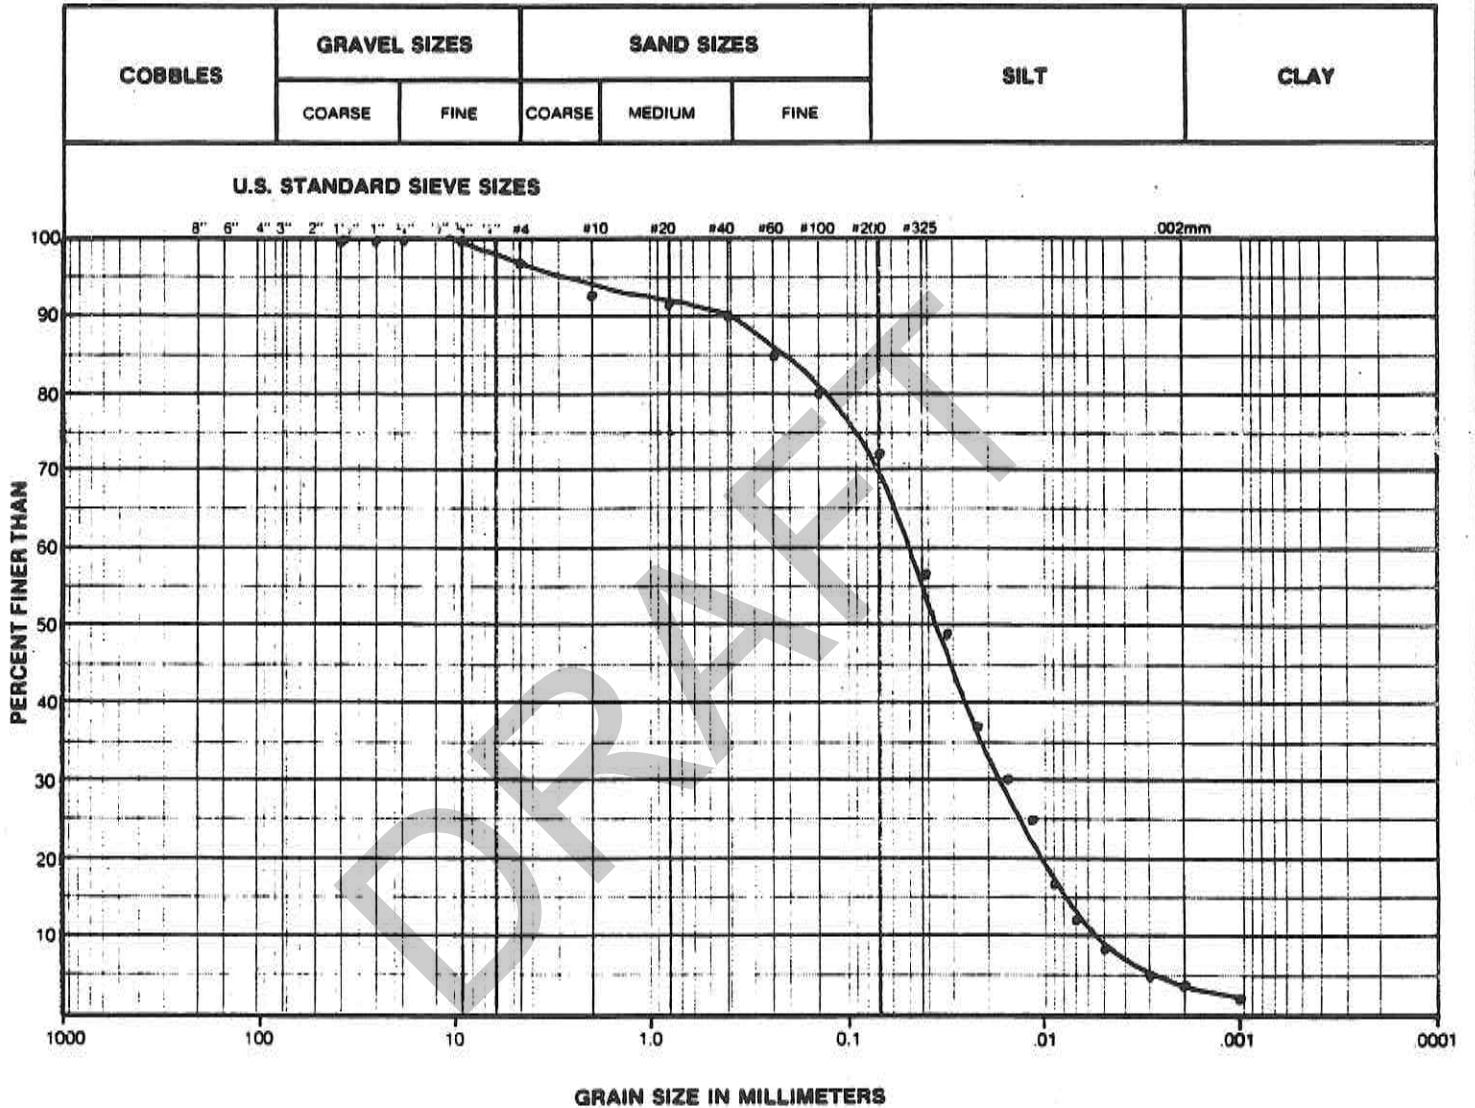CLIENT: ST. MARY'S LF
 PROJECT NUMBER: DL45
 LAB. NUMBER: CR 3588
 LOCATION: BH12-91
 HOLE: SAMPLE: 3CS
 DEPTH: 9.5 - 13.5 FT
 TECHNICIAN: T. GERARDI DATE: NOVEMBER 4/91



HAZEN PERMEABILITY ESTIMATE $(D_{10})^2 = 3.5 \times 10^{-5}$ cm/sec

NOTE: D_{10} = GRAINSIZE IN mm AT 10% FINER THAN

REMARKS: SILT, SOME SAND, TRACE CLAY,
TRACE GRAVEL

NOTE: UNIFIED SOIL CLASSIFICATION SYSTEM

SOIL CLASSIFICATION
 DESCRIPTIVE MODIFIERS


SUMMARY

AND 36-50 %
 SOME 21-35 %
 LITTLE 11-20 %
 TRACE 1-10 %

GRAVEL 2.90 %
 SAND 25.51 %
 SILT 68.22 %
 CLAY 3.36 %

GRAIN SIZE CURVE

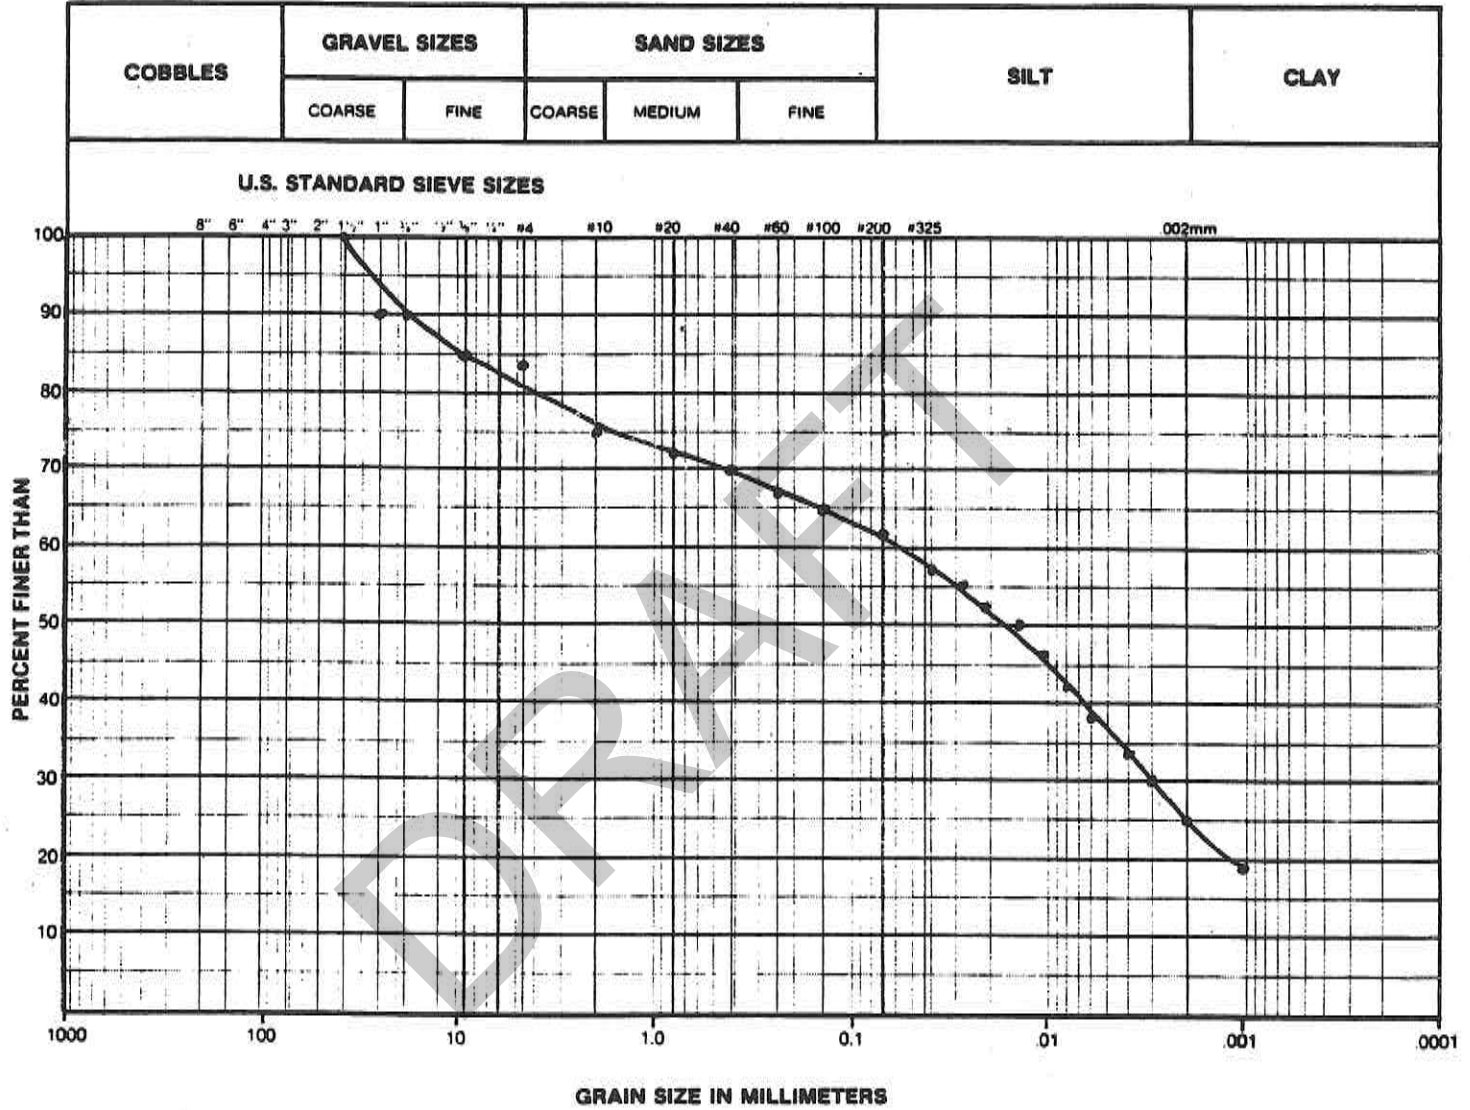
CLIENT: ST. MARY'S LF
 PROJECT NUMBER: 0645
 LAB. NUMBER: CR 3589
 LOCATION: BN12-91
 HOLE: SAMPLE: 4CS
 DEPTH: 14-19 FT
 TECHNICIAN: T. GERARDI DATE: NOVEMBER 6/91



HAZEN PERMEABILITY ESTIMATE $(D_{10})^2 = 3.1E-07$ cm/sec	SOIL CLASSIFICATION		SUMMARY
	DESCRIPTIVE MODIFIERS		
NOTE: D_{10} = GRAIN SIZE IN mm AT 10% FINER THAN	AND	36-50 %	GRAVEL <u>16.45</u> %
REMARKS : <u>SILT, SOME CLAY, SOME SAND,</u> <u>LITTLE GRAVEL</u>	SOME	21-35 %	SAND <u>21.57</u> %
	LITTLE	11-20 %	SILT <u>38.33</u> %
	TRACE	1-10 %	CLAY <u>23.64</u> %
NOTE: UNIFIED SOIL CLASSIFICATION SYSTEM			

GRAIN SIZE CURVE

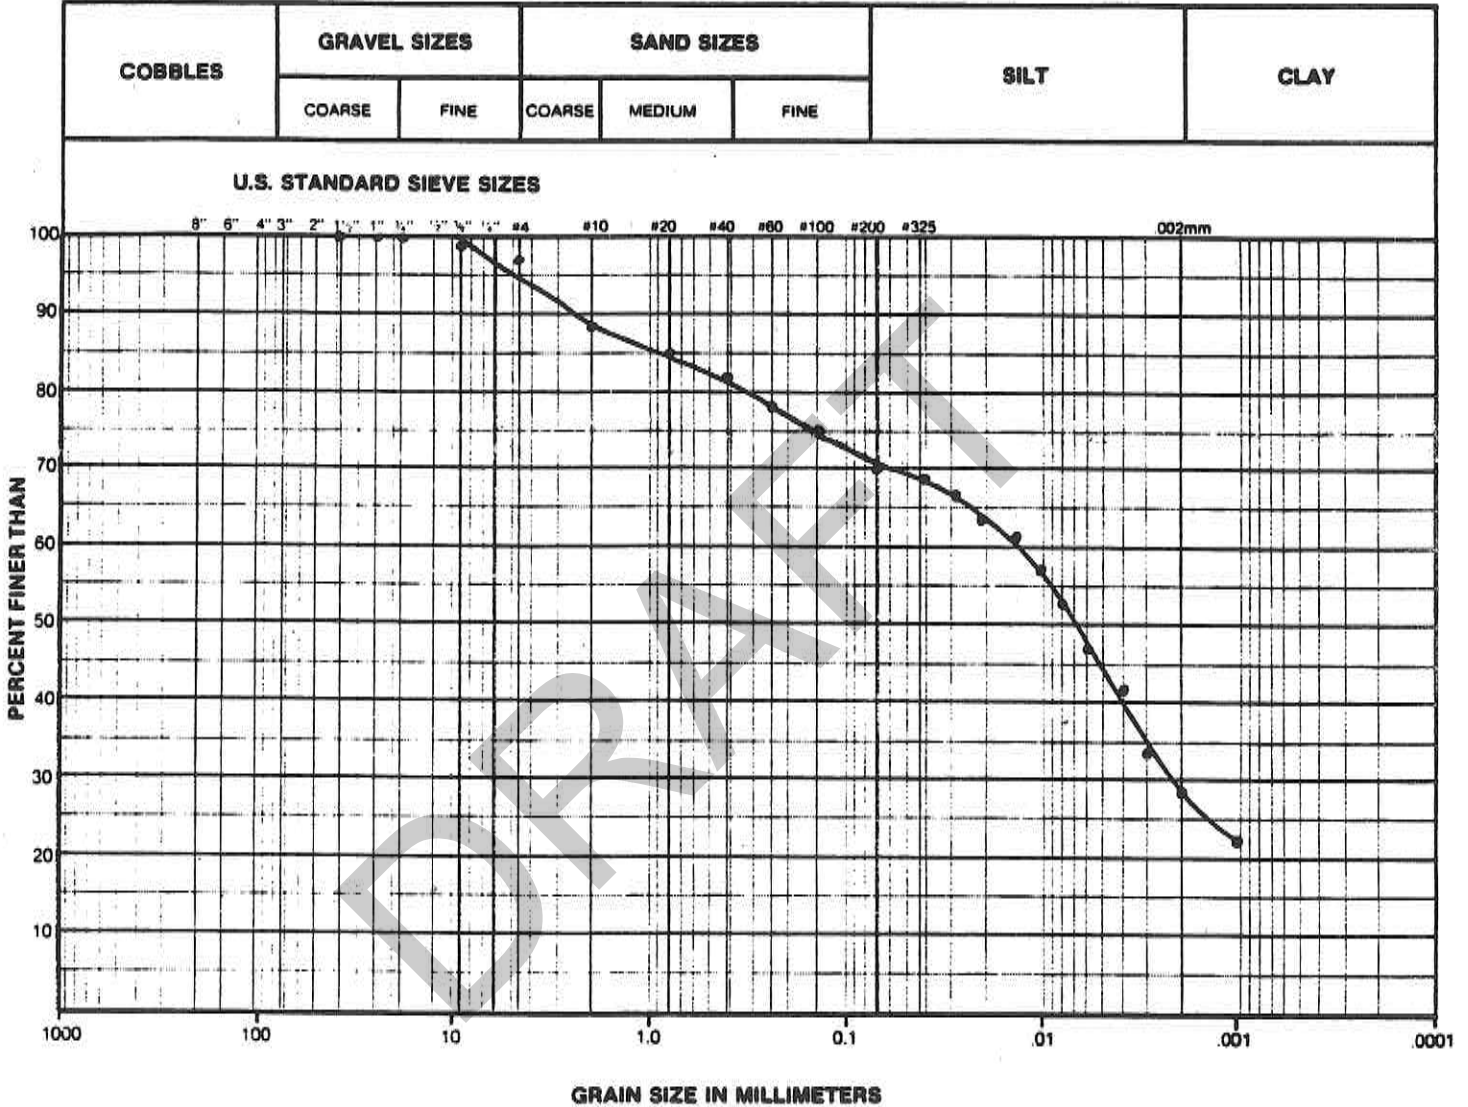CLIENT: *ST. MARY'S LE*
 PROJECT NUMBER: *D645*
 LAB. NUMBER: *CR 3590*
 LOCATION: *BH 13-91*
 HOLE: *—* SAMPLE: *4CS*
 DEPTH: *15-18.5 FT*
 TECHNICIAN: *T. GERARDI* DATE: *NOVEMBER 4/91*



HAZEN PERMEABILITY ESTIMATE (D₁₀)² = 2.7E-07 cm/sec

NOTE: D₁₀ = GRAINSIZE IN mm AT 10% FINER THAN

REMARKS: SILT, SOME CLAY, SOME SAND,
TRACE GRAVEL

NOTE: UNIFIED SOIL CLASSIFICATION SYSTEM

SOIL CLASSIFICATION
 DESCRIPTIVE MODIFIERS


SUMMARY

AND	36-50%	GRAVEL	<u>2.93</u>	%
SOME	21-35%	SAND	<u>26.71</u>	%
LITTLE	11-20%	SILT	<u>42.27</u>	%
TRACE	1-10%	CLAY	<u>28.09</u>	%

GRAIN SIZE CURVE

CLIENT: ST. MARY'S LF
 PROJECT NUMBER: 0645
 LAB. NUMBER: CR 3591
 LOCATION: BH13-91
 HOLE: SAMPLE: 10C5
 DEPTH: 43.5 - 48.5 FT
 TECHNICIAN: T. GERARDI DATE: NOVEMBER 6/91

COBBLES	GRAVEL SIZES		SAND SIZES			SILT	CLAY
	COARSE	FINE	COARSE	MEDIUM	FINE		

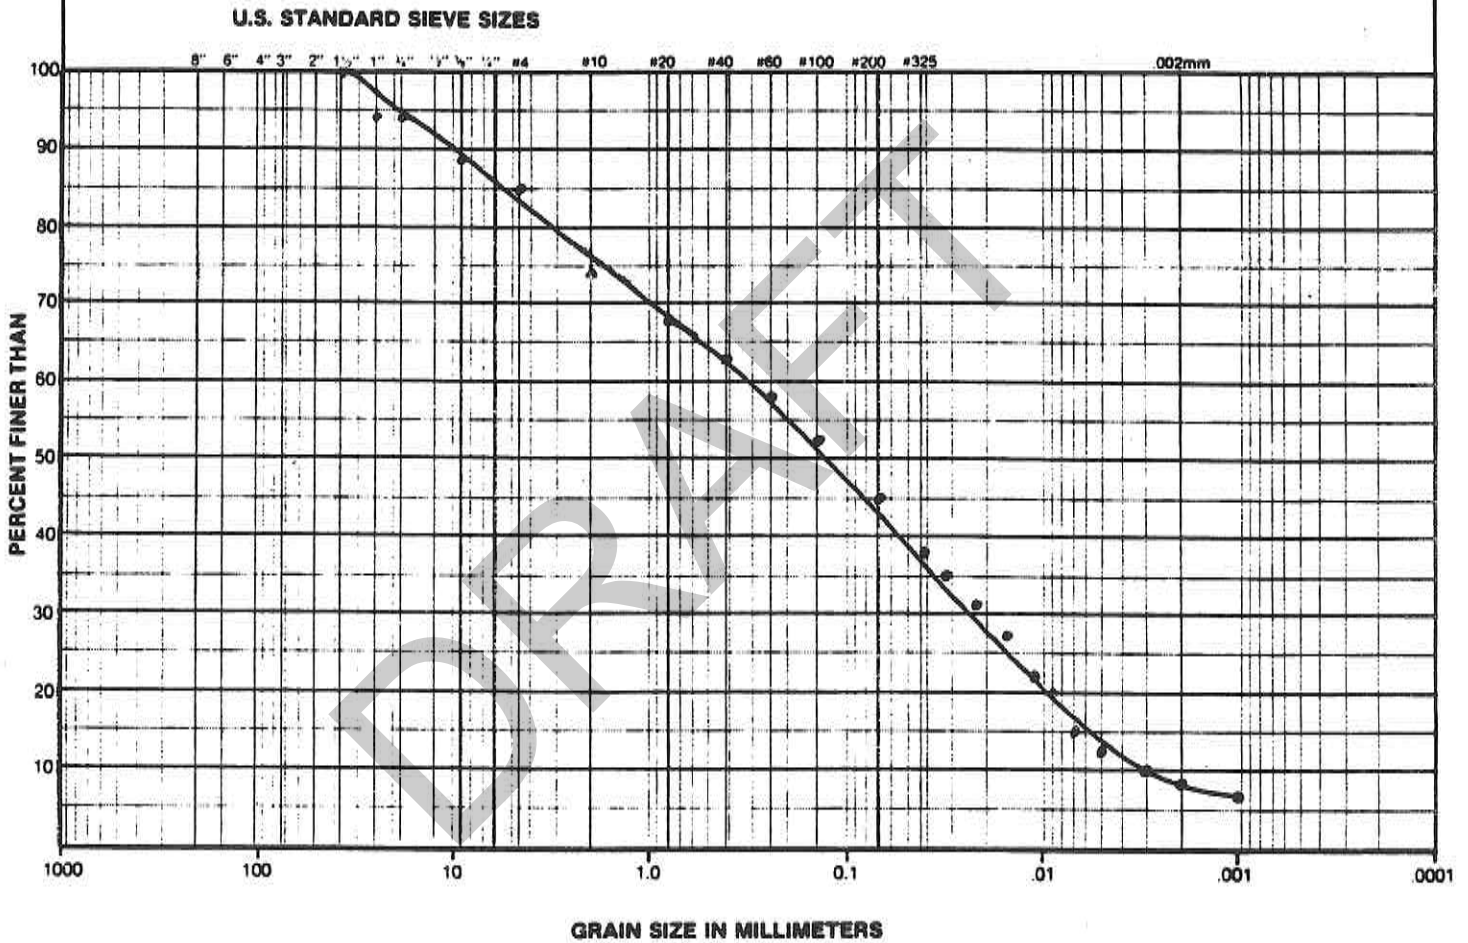

HAZEN PERMEABILITY ESTIMATE $(D_{10})^2 = 1.0E-05$ cm/sec

NOTE: D_{10} = GRAINSIZE IN mm AT 10% FINER THAN

REMARKS: SAND AND SILT, LITTLE GRAVEL,
TRACE CLAY.

NOTE: UNIFIED SOIL CLASSIFICATION SYSTEM

SOIL CLASSIFICATION
 DESCRIPTIVE MODIFIERS


AND 36-50 %
 SOME 21-35 %
 LITTLE 11-20 %
 TRACE 1-10 %

SUMMARY

GRAVEL 15.20 %
 SAND 40.05 %
 SILT 36.62 %
 CLAY 8.13 %

GRAIN SIZE CURVE

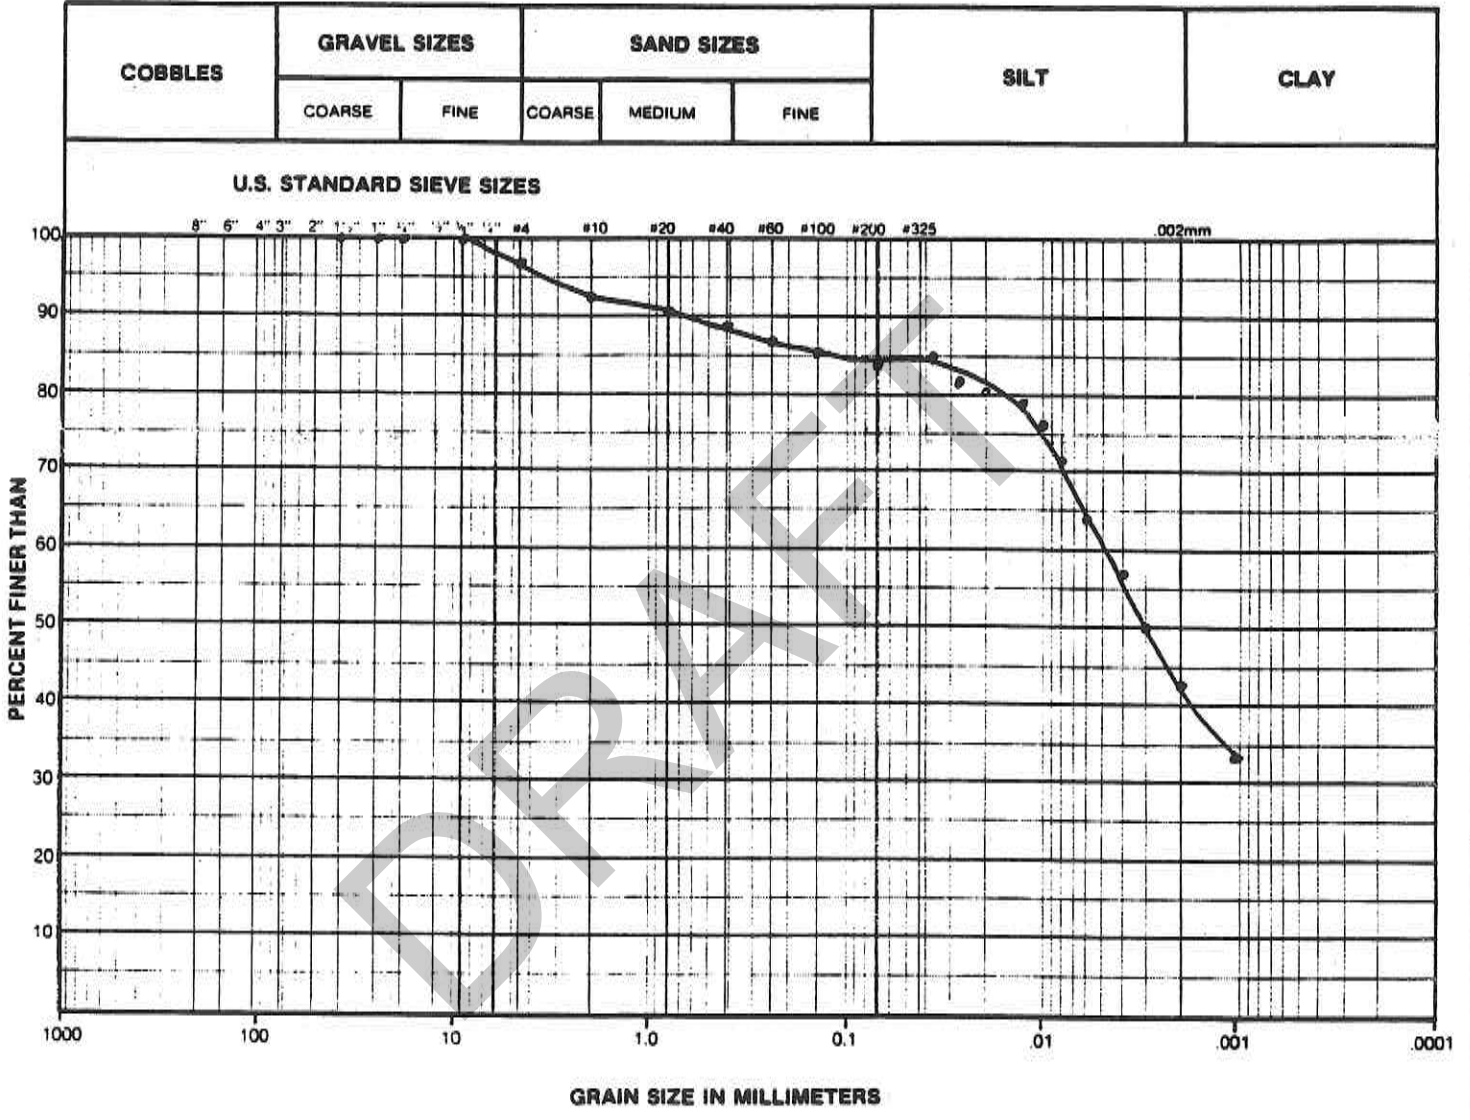CLIENT: *JT. MARY'S LF*
 PROJECT NUMBER: *0645*
 LAB. NUMBER: *CR 3584*
 LOCATION: *DW15-91*
 HOLE: *—* SAMPLE: *105*
 DEPTH: *11.5 - 15 FT*
 TECHNICIAN: *T. GERARDI* DATE: *NOVEMBER 4/91*



HAZEN PERMEABILITY ESTIMATE $(D_{10})^2 = 1.2E-07$ cm/sec
 NOTE: D_{10} = GRAIN SIZE IN mm AT 10% FINER THAN


REMARKS: SILT AND CLAY, LITTLE SAND,
TRACE GRAVEL

NOTE: UNIFIED SOIL CLASSIFICATION SYSTEM

SOIL CLASSIFICATION DESCRIPTIVE MODIFIERS		SUMMARY
AND	36-50%	GRAVEL <u>2.58</u> %
SOME	21-35%	SAND <u>13.64</u> %
LITTLE	11-20%	SILT <u>42.07</u> %
TRACE	1-10%	CLAY <u>41.72</u> %

GRAIN SIZE CURVE

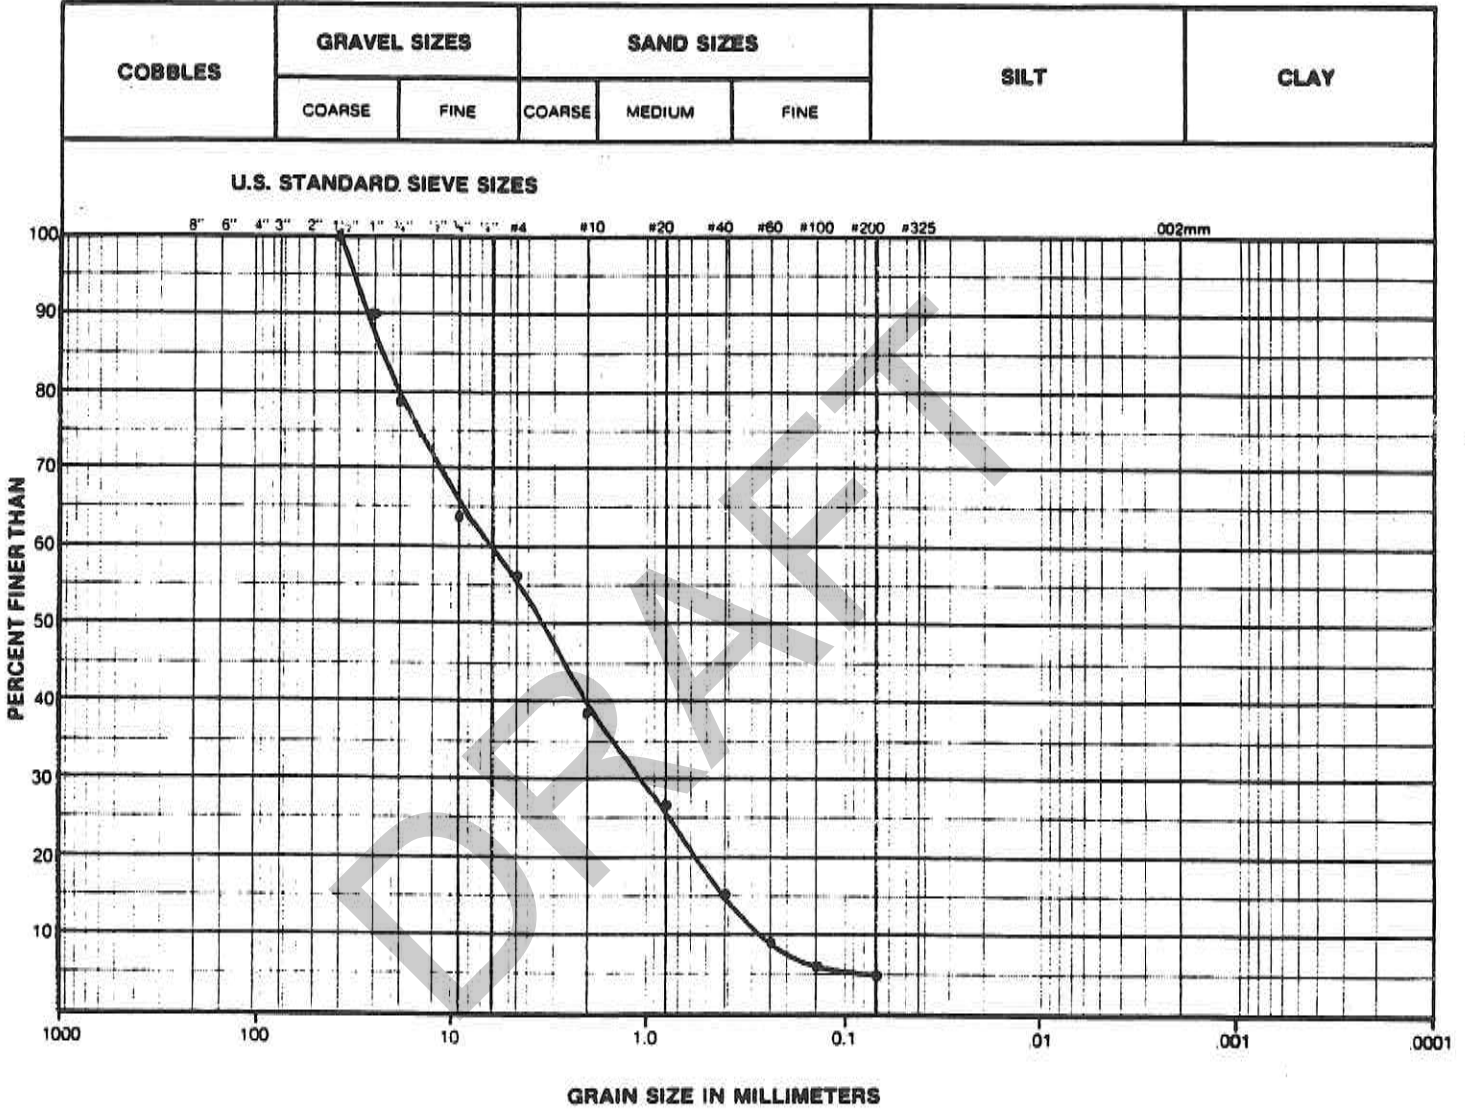
CLIENT: ST. MARY'S LF
 PROJECT NUMBER: 0645
 LAB. NUMBER: CR 3585
 LOCATION: DW15-91
 HOLE: — SAMPLE: 2CS
 DEPTH: 15-19 FT.
 TECHNICIAN: T. GERARDI DATE: NOVEMBER 4/91



HAZEN PERMEABILITY ESTIMATE $(D_{10})^2 =$ _____ cm/sec NOTE: D_{10} = GRAIN SIZE IN mm AT 10% FINER THAN	SOIL CLASSIFICATION	SUMMARY
	DESCRIPTIVE MODIFIERS	
REMARKS: <u>SAND AND GRAVEL,</u> <u>TRACE SILT & CLAY</u>	AND 36-50%	GRAVEL <u>43.79</u> %
	SOME 21-35%	SAND <u>50.85</u> %
	LITTLE 11-20%	SILT <u>—</u> %
	TRACE 1-10%	CLAY <u>5.36</u> %
NOTE: UNIFIED SOIL CLASSIFICATION SYSTEM		

GRAIN SIZE CURVE

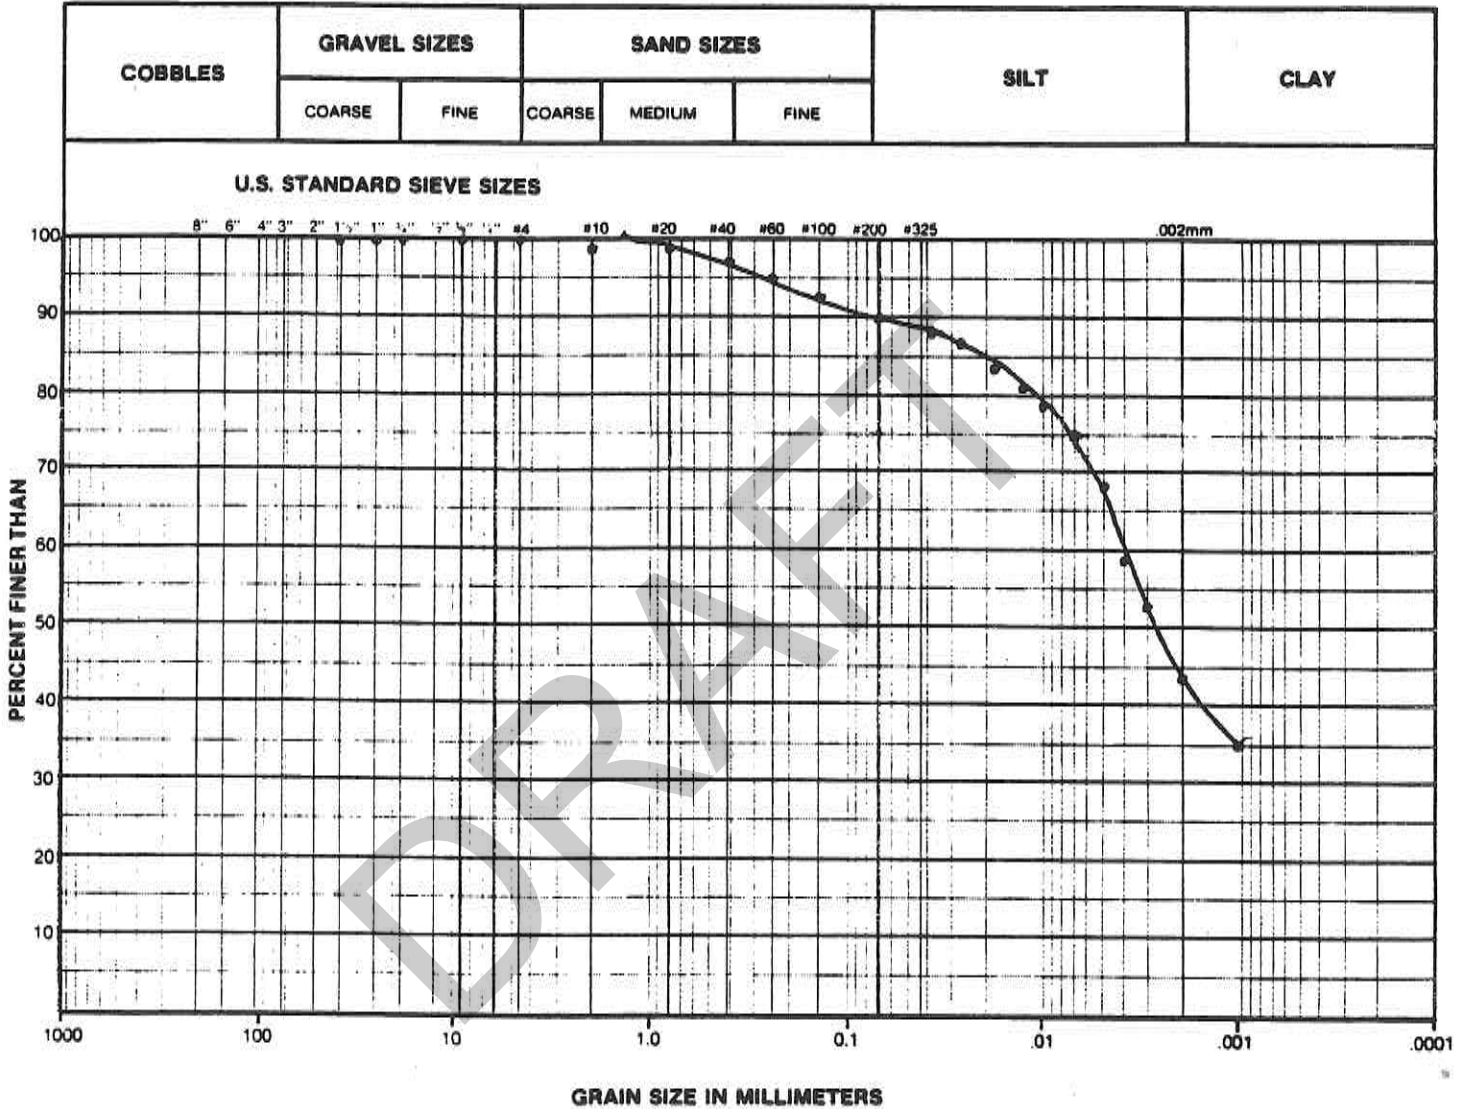
CLIENT: *ST. MARY'S LF*
 PROJECT NUMBER: *D645*
 LAB. NUMBER: *CR 3586*
 LOCATION: *BN16-91*
 HOLE: *—* SAMPLE: *1CS*
 DEPTH: *9-11 FT*
 TECHNICIAN: *T. GERARDI* DATE: *NOVEMBER 6/91*



HAZEN PERMEABILITY ESTIMATE $(D_{10})^2 = 9.4E-08$ cm/sec NOTE: D_{10} = GRAINSIZE IN mm AT 10% FINER THAN	SOIL CLASSIFICATION DESCRIPTIVE MODIFIERS	SUMMARY
REMARKS: <i>SILT AND CLAY, TRACE SAND</i>	AND 36-50 % SOME 21-35 % LITTLE 11-20 % TRACE 1-10 %	GRAVEL <i>0</i> % SAND <i>10.32</i> % SILT <i>46.18</i> % CLAY <i>43.50</i> %
NOTE: UNIFIED SOIL CLASSIFICATION SYSTEM		

GRAIN SIZE DISTRIBUTION

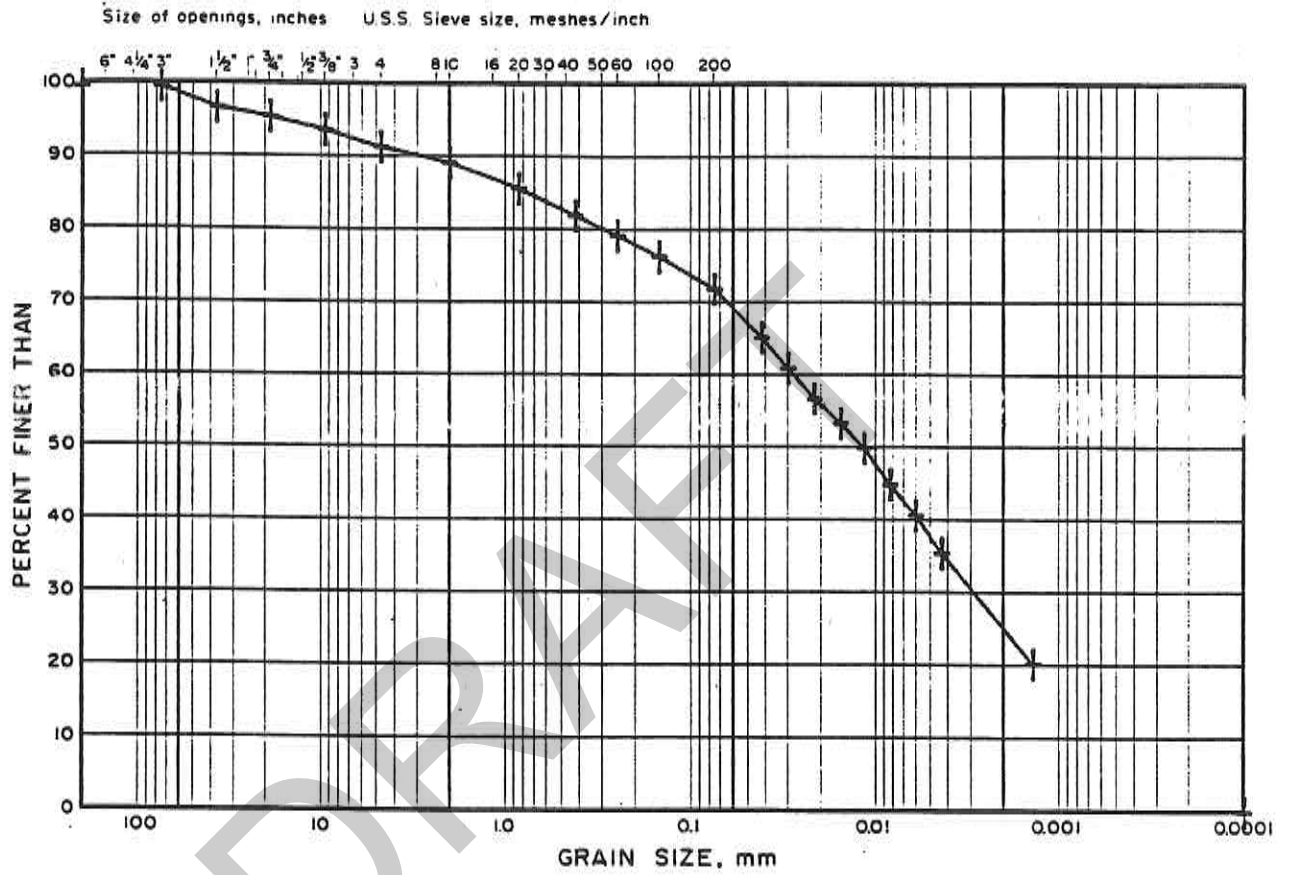
FIGURE 2



COBBLE SIZE	COARSE	MEDIUM	FINE	COARSE	MEDIUM	FINE	SILT SIZE		CLAY SIZE
	GRAVEL SIZE			SAND SIZE			FINE GRAINED		

LEGEND

SYMBOL	BOREHOLE SAMPLE	DEPTH (m)
+	17-91 1	1.22

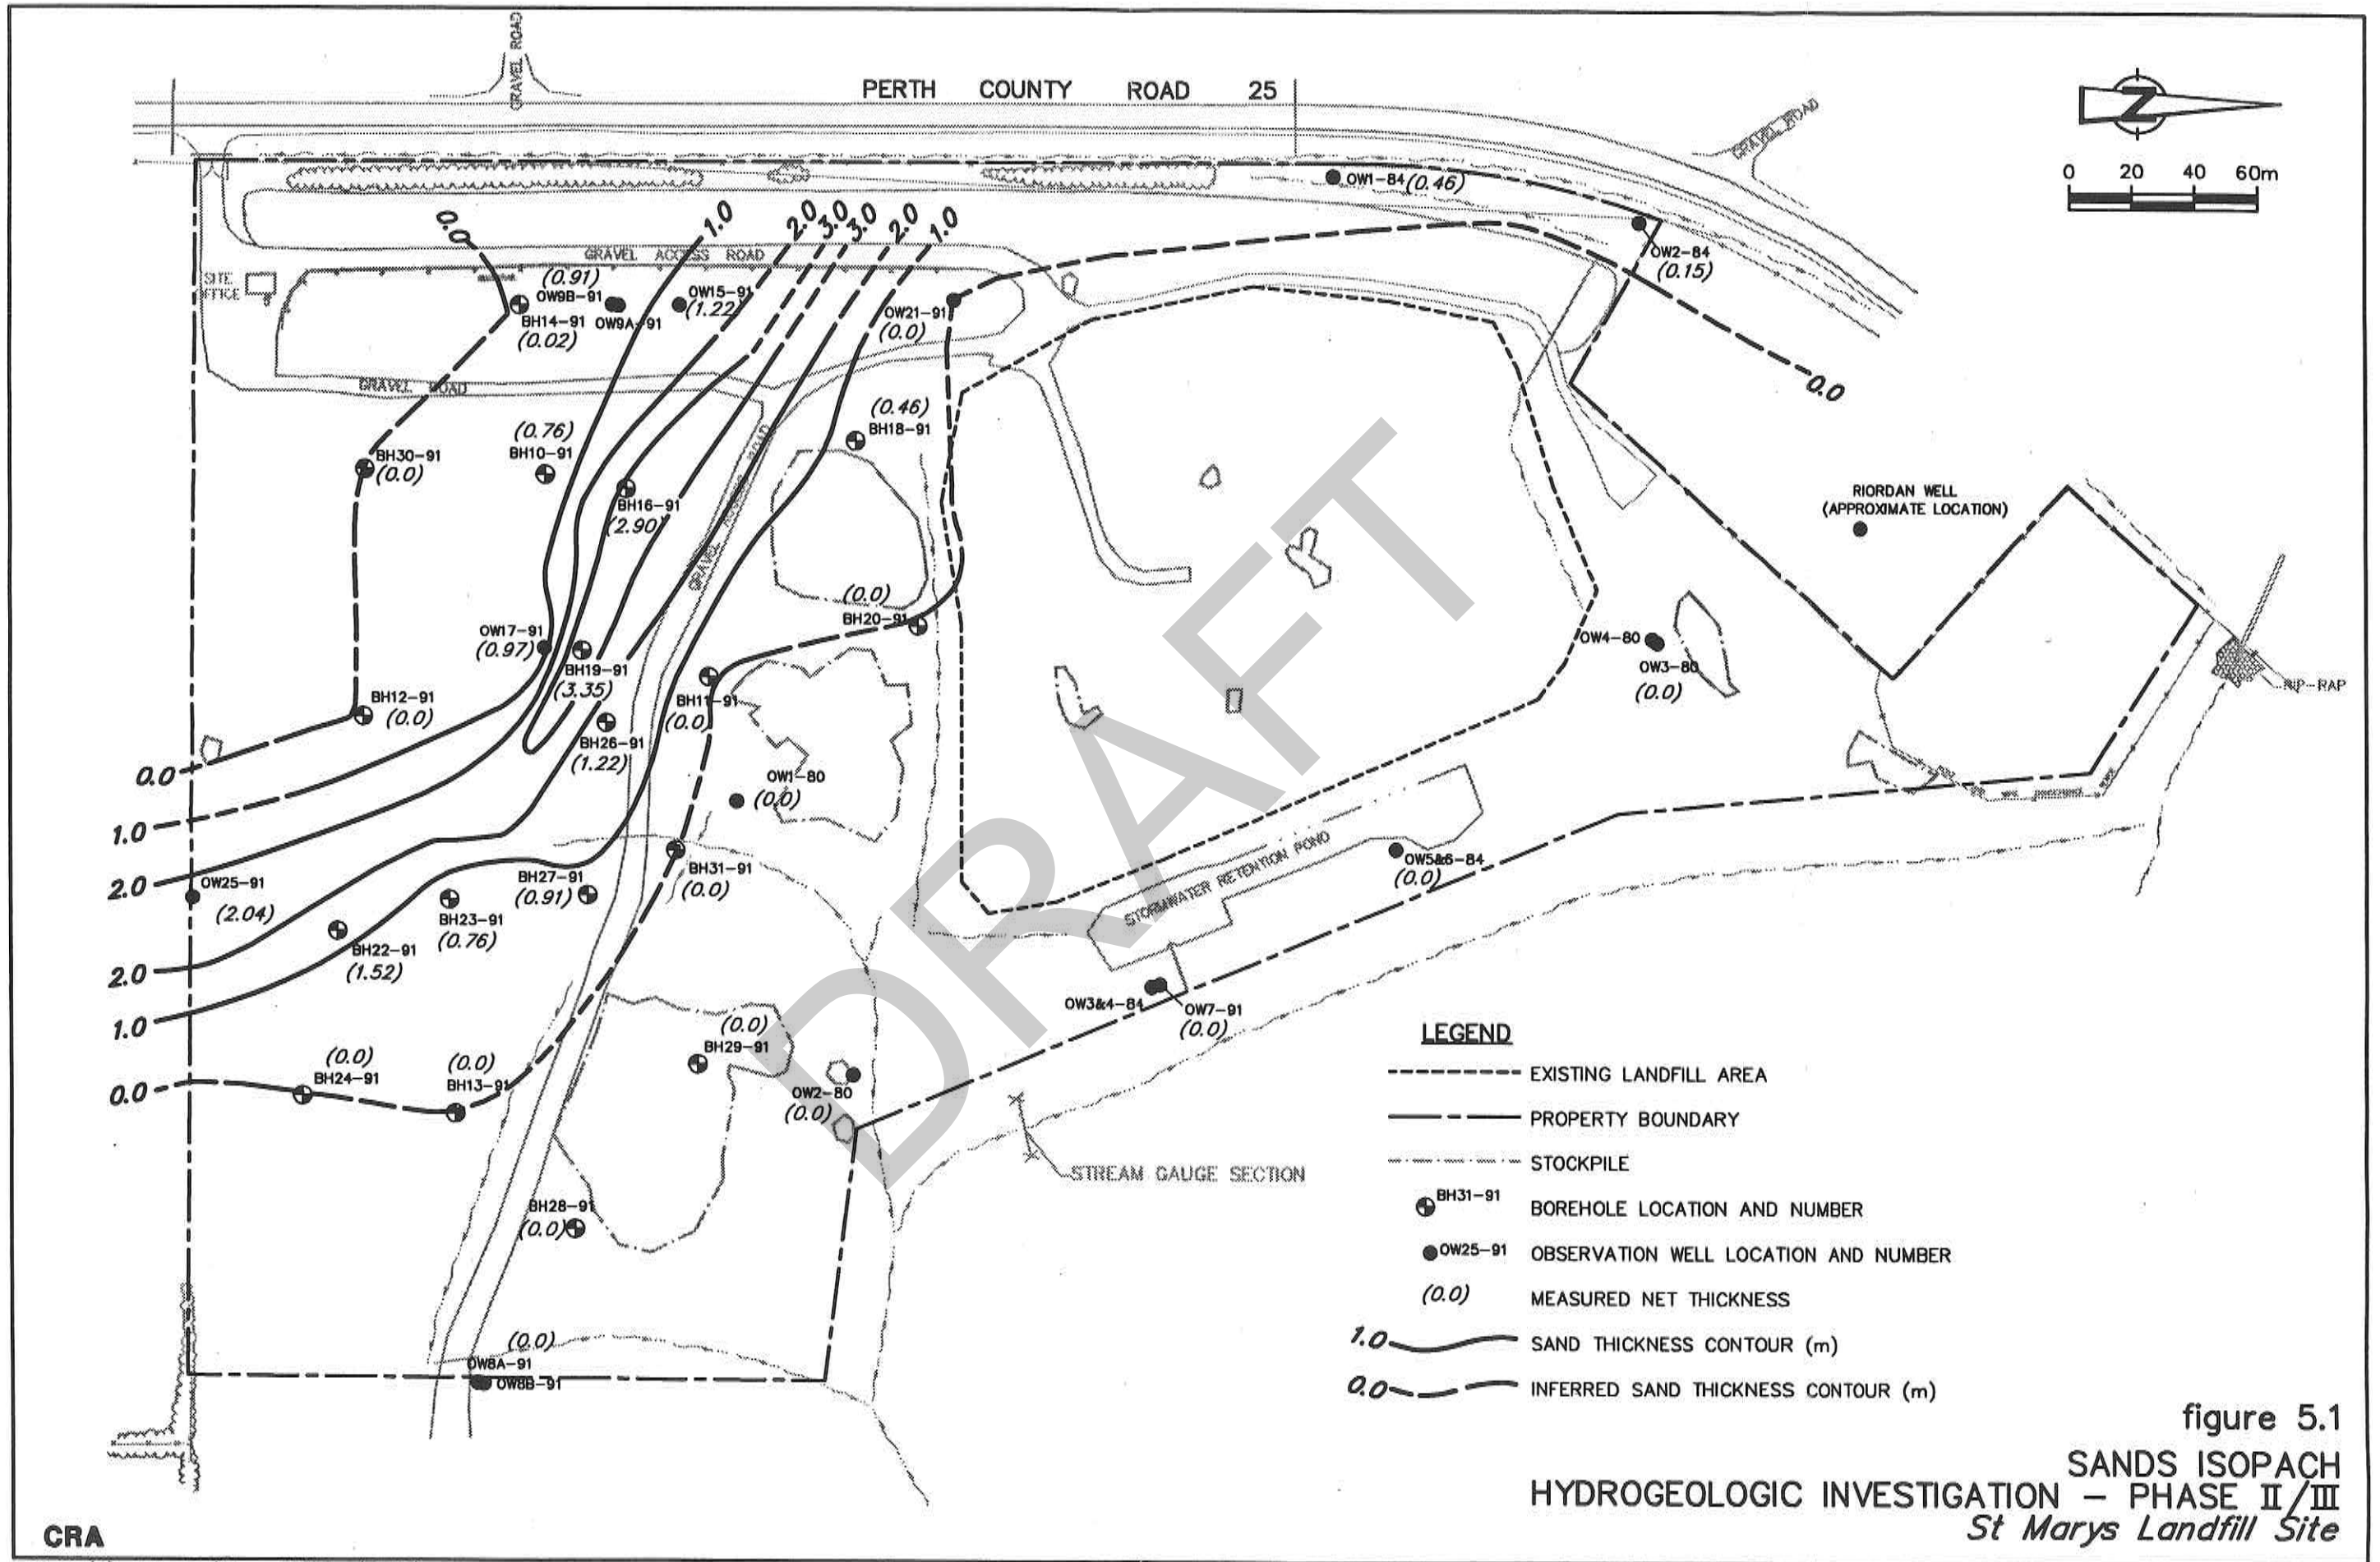

CRA



BURNSIDE

[THE DIFFERENCE IS OUR PEOPLE]








Appendix D

Perth County Groundwater Study 2003 Mapping

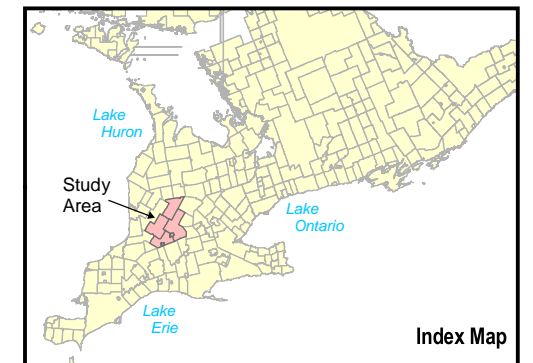
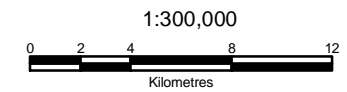
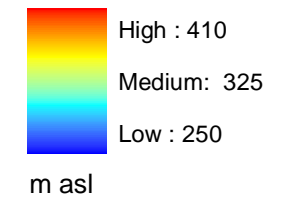
DRAFT

Perth County Groundwater Management Study

Legend

-  County Boundaries
-  Township Boundaries
-  Study Area Boundary
-  Rivers
-  Roads
-  Population Centres
-  Bedrock Wells

Value




Disclaimer: This map is intended for illustrative purposes only. Figure is to be read in conjunction with the Perth County Groundwater Management Study.
Digital Mapping Sources: Base mapping features - Ministry of the Environment.
Water well information - Ministry of the Environment.

Date: April 2003





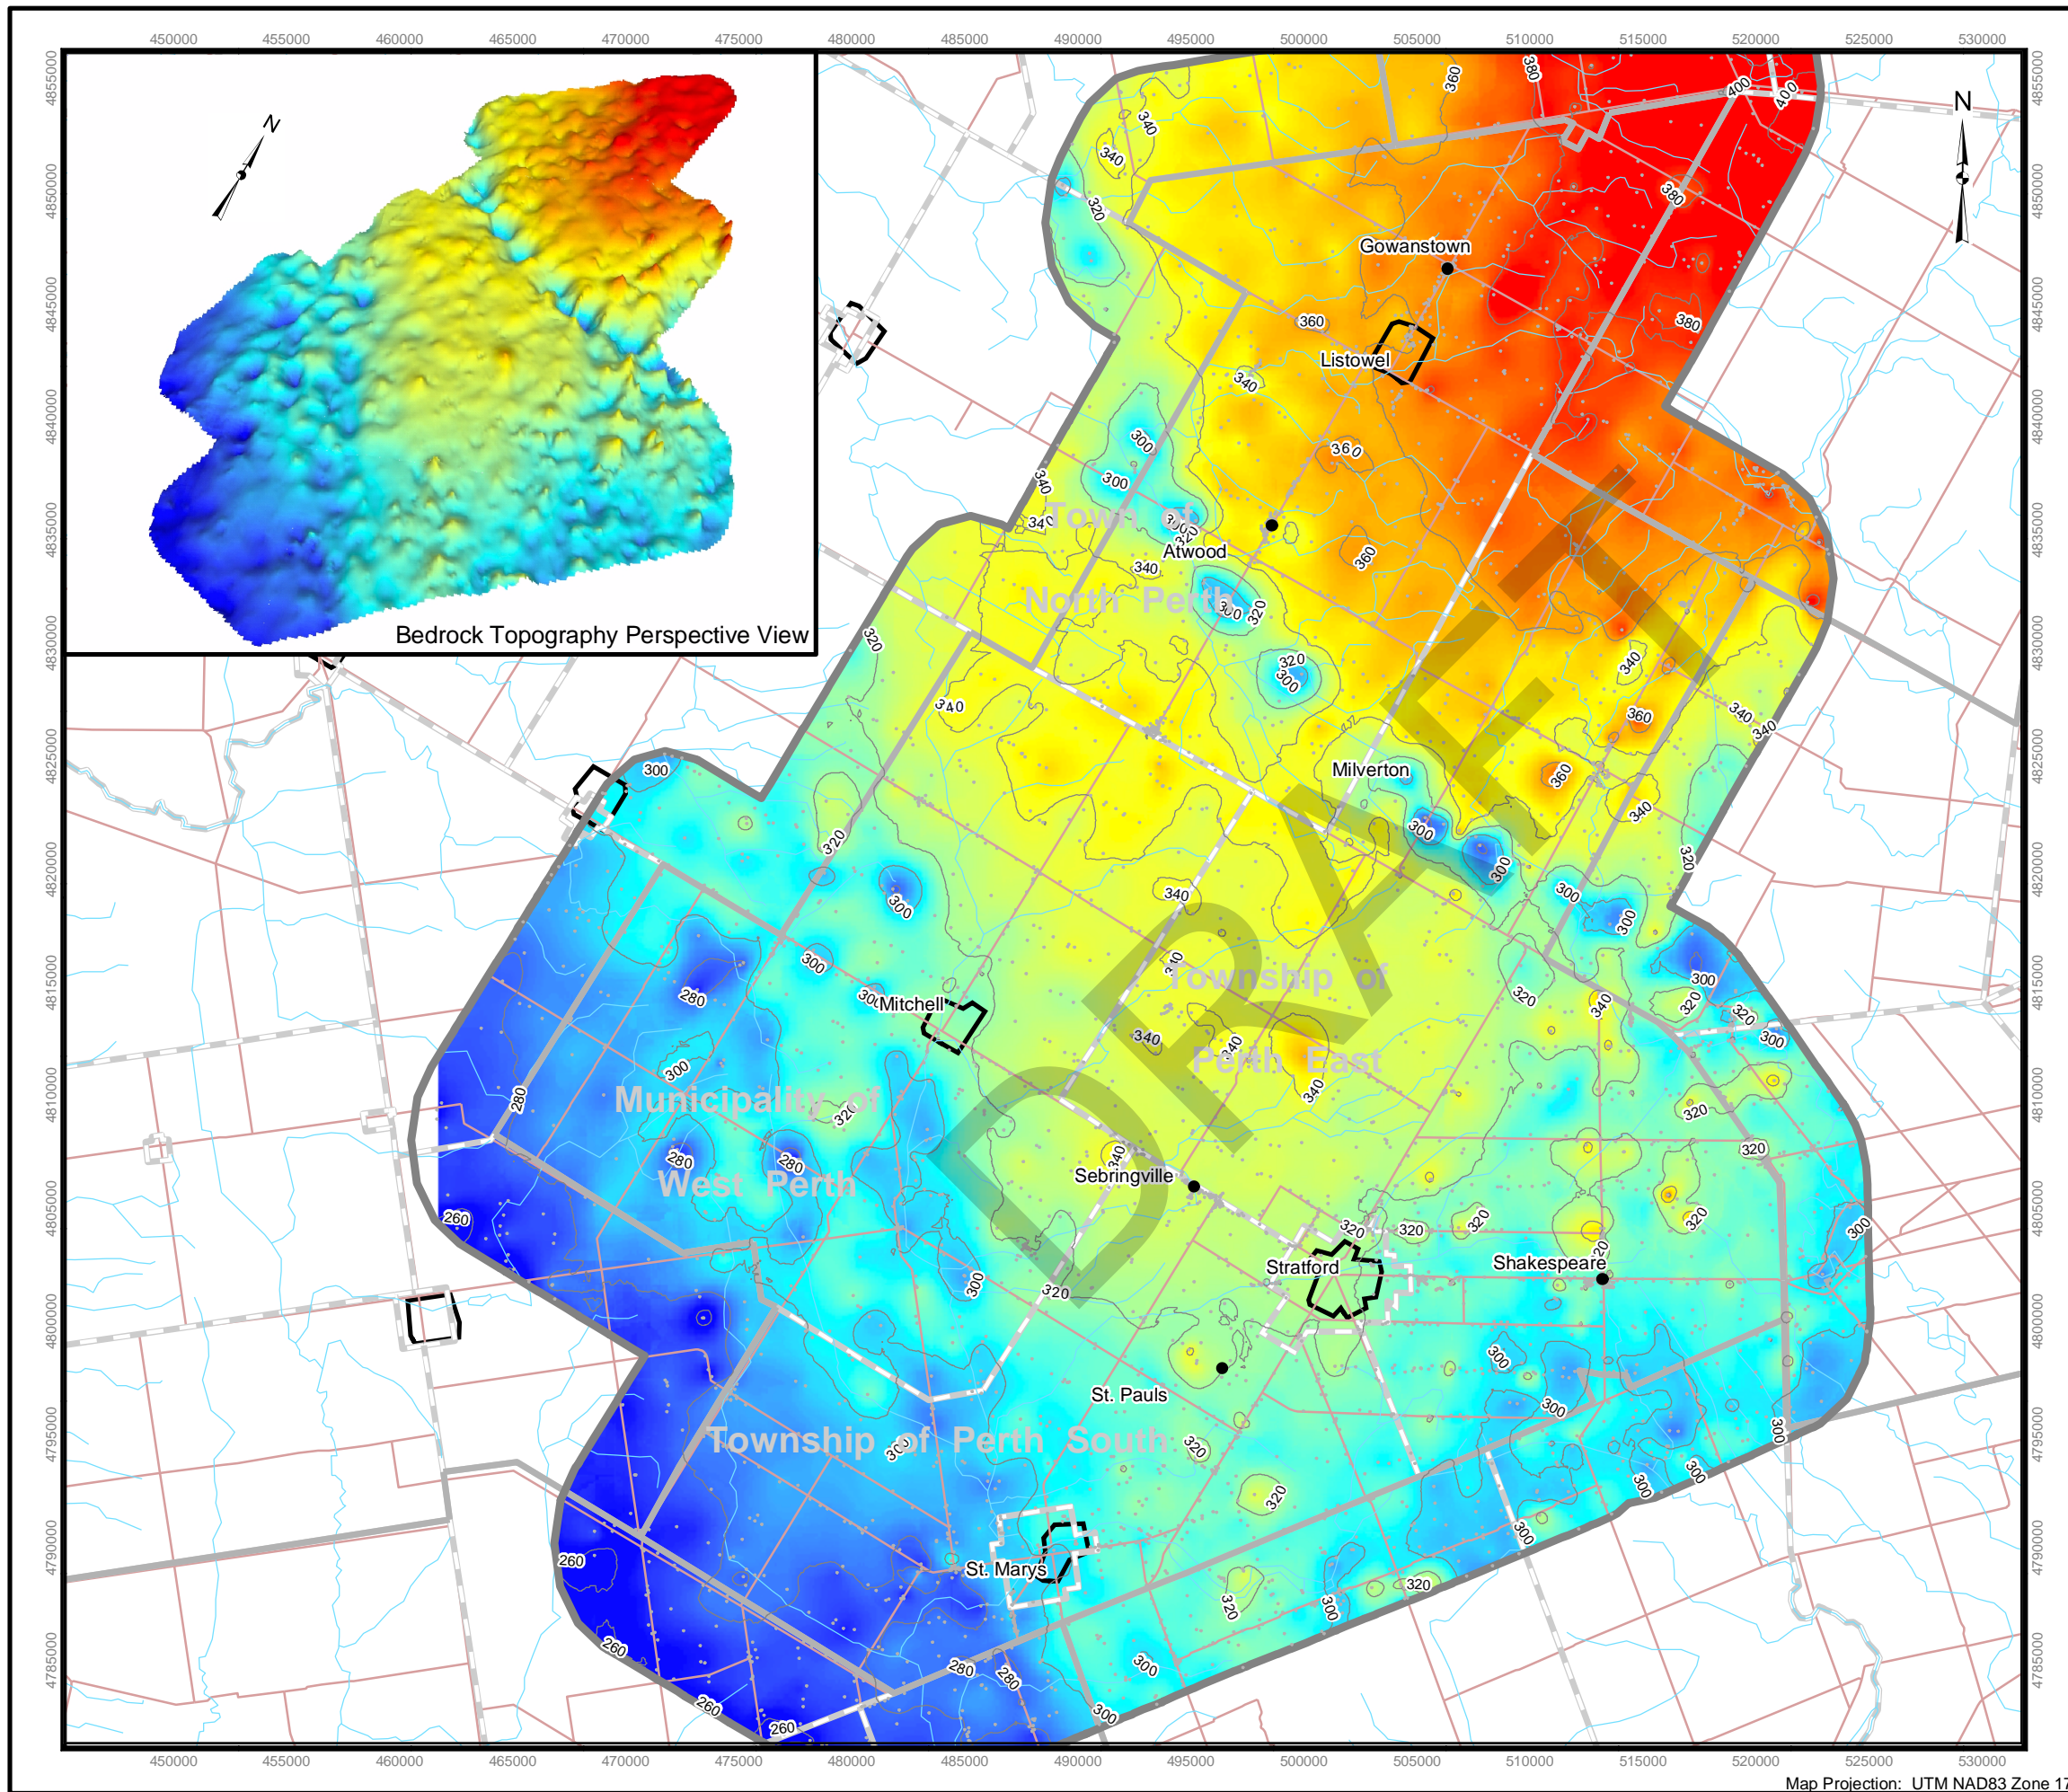



Figure 2.17 : Bedrock Topography

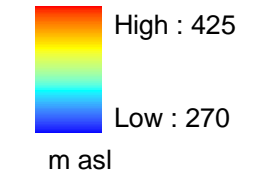


Perth County Groundwater Management Study


Legend

-  County Boundaries
-  Township Boundaries
-  Study Area Boundary
-  Rivers
-  Roads
-  Population Centres

Value



1:300,000

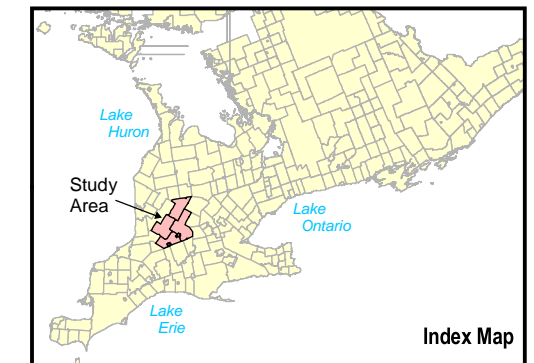


Disclaimer: This map is intended for illustrative purposes only. Figure is to be read in conjunction with the Perth County Groundwater Management Study.
Digital Mapping Sources: Base mapping features - Ministry of the Environment.
Water well information - Ministry of the Environment.

Date: April 2003





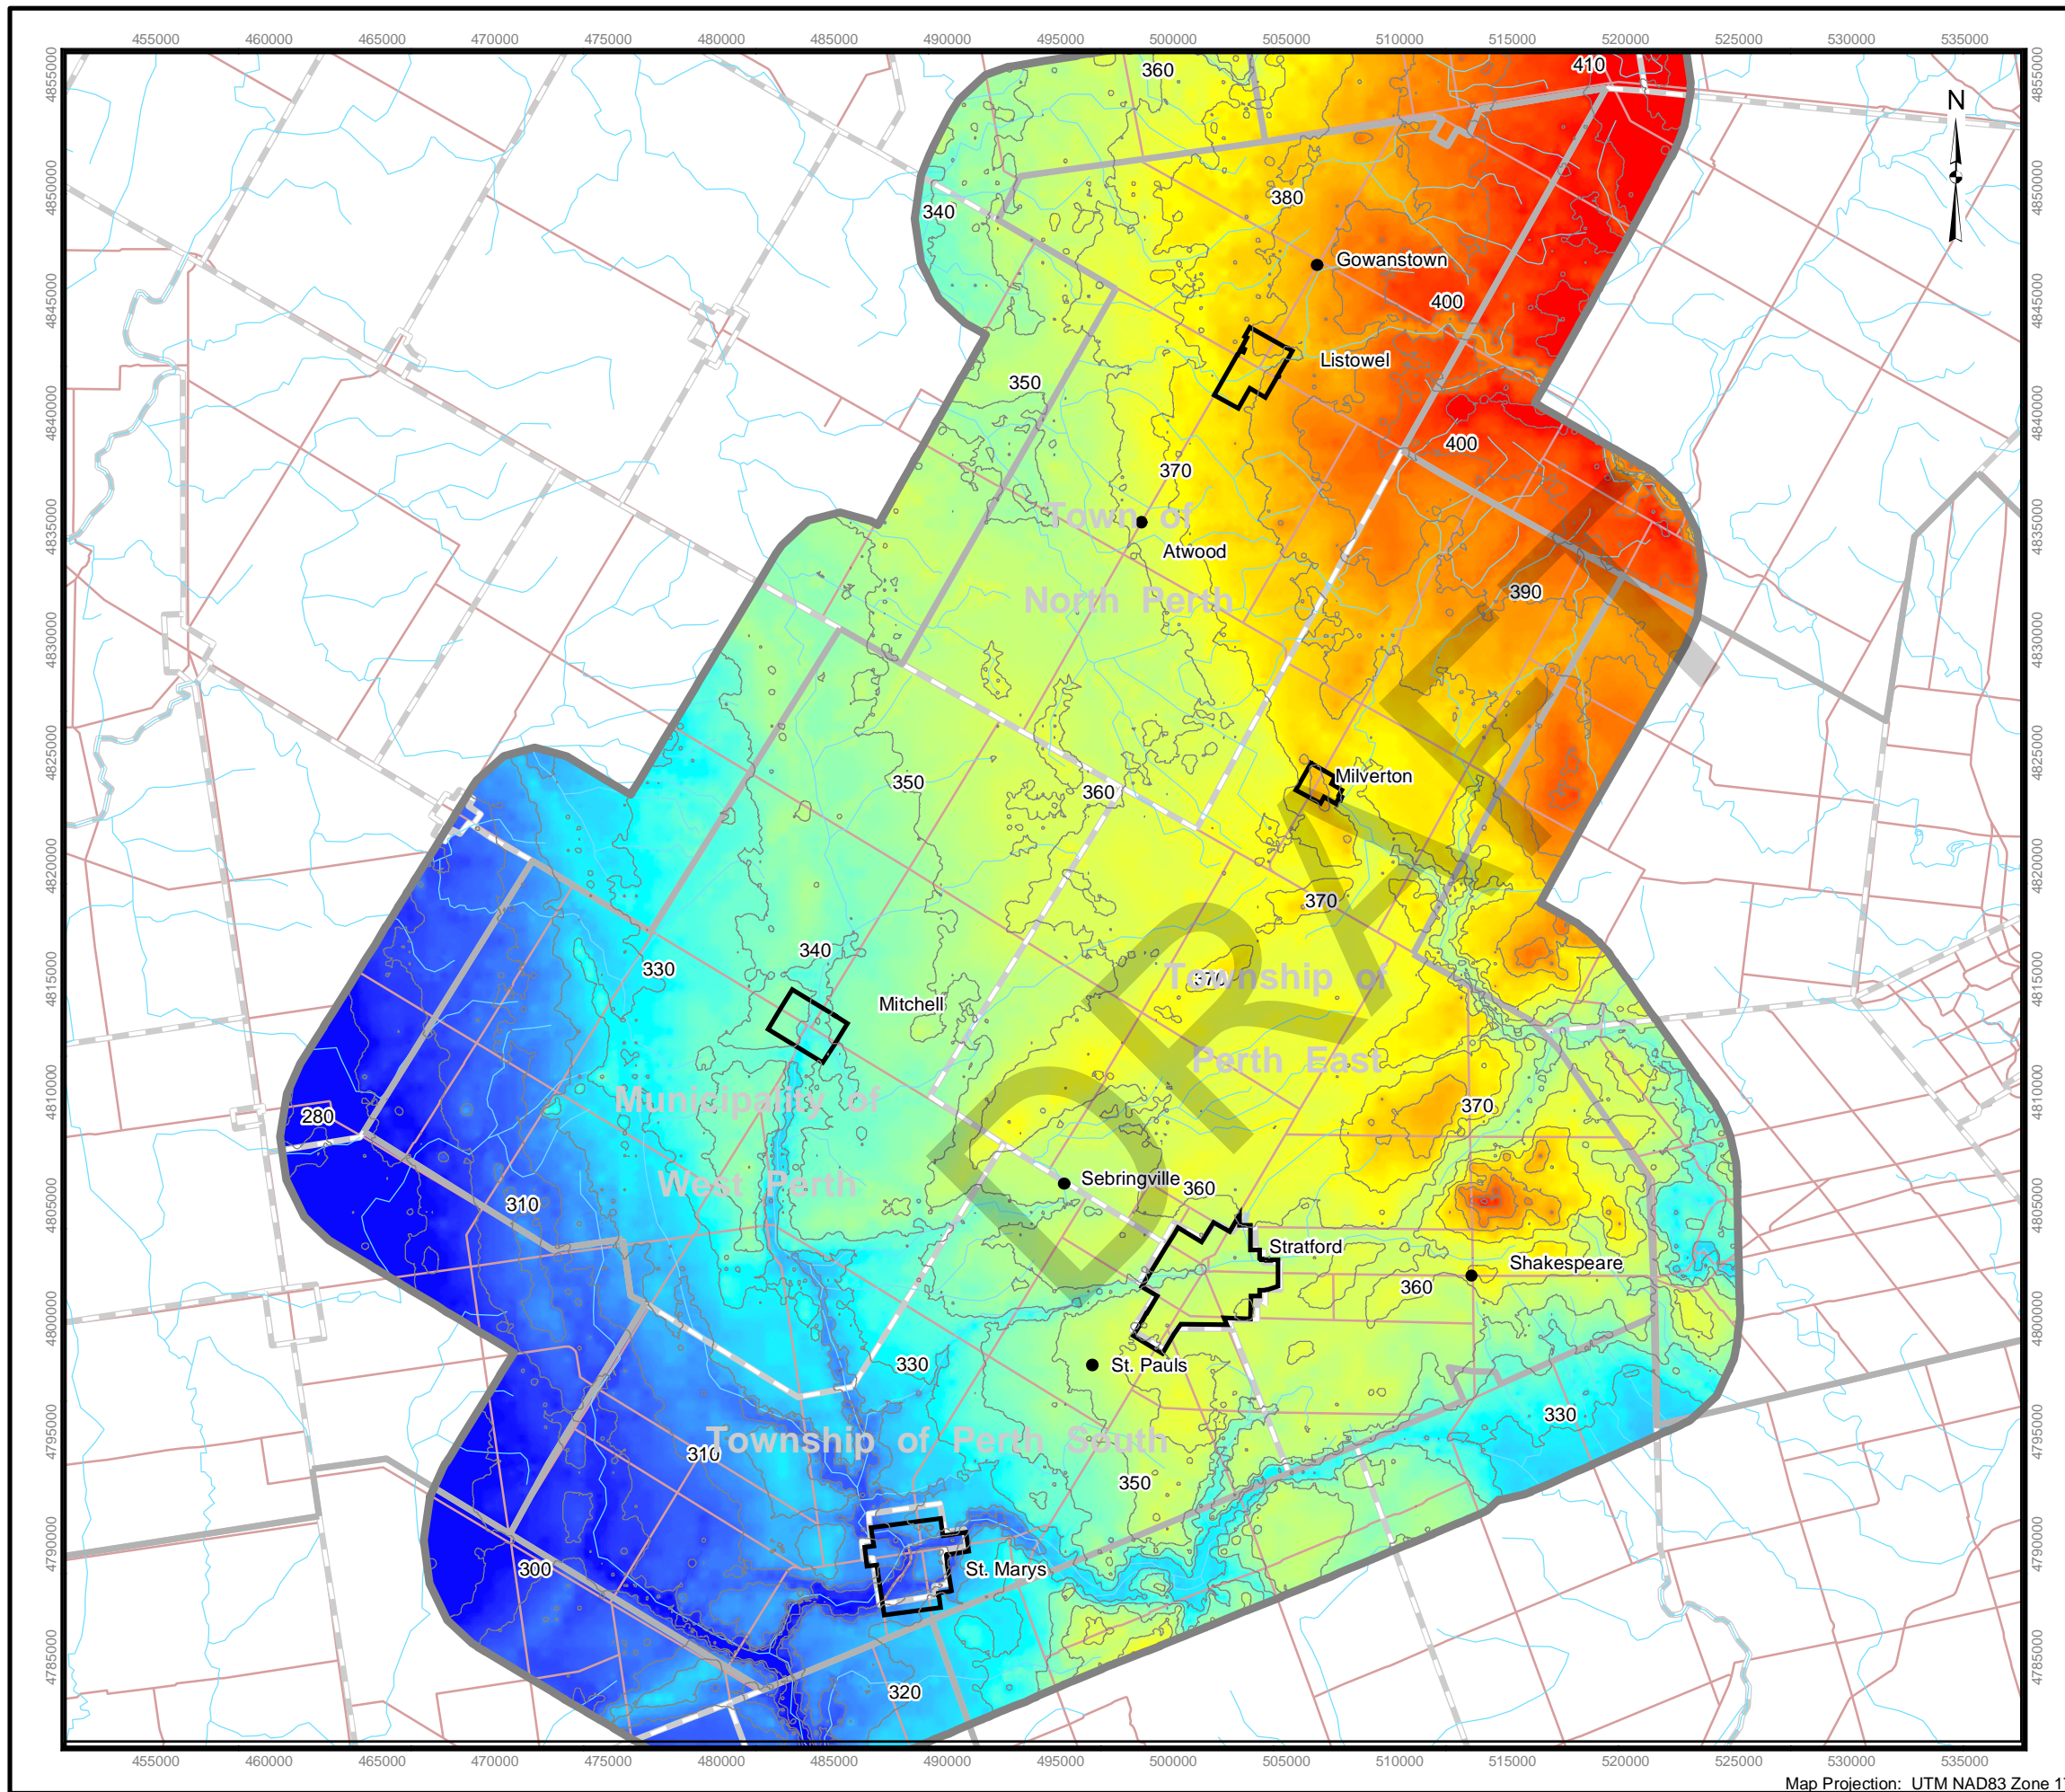




Figure 2.21 : Water Table Elevation

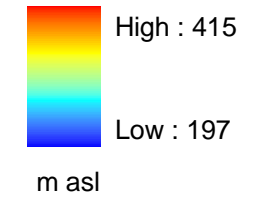


Perth County Groundwater Management Study



Legend

-  County Boundaries
-  Township Boundaries
-  Study Area Boundary
-  Rivers
-  Roads
-  Population Centres
-  Bedrock Well Locations

Value



1:300,000

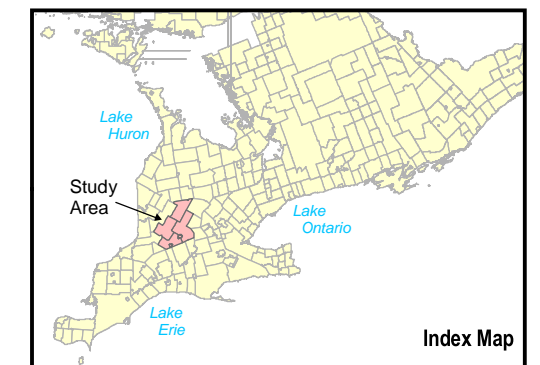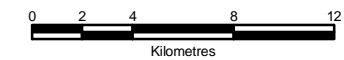



Disclaimer: This map is intended for illustrative purposes only. Figure is to be read in conjunction with the Perth County Groundwater Management Study.
Digital Mapping Sources: Base mapping features - Ministry of the Environment.
Water well information - Ministry of the Environment.

Date: April 2003



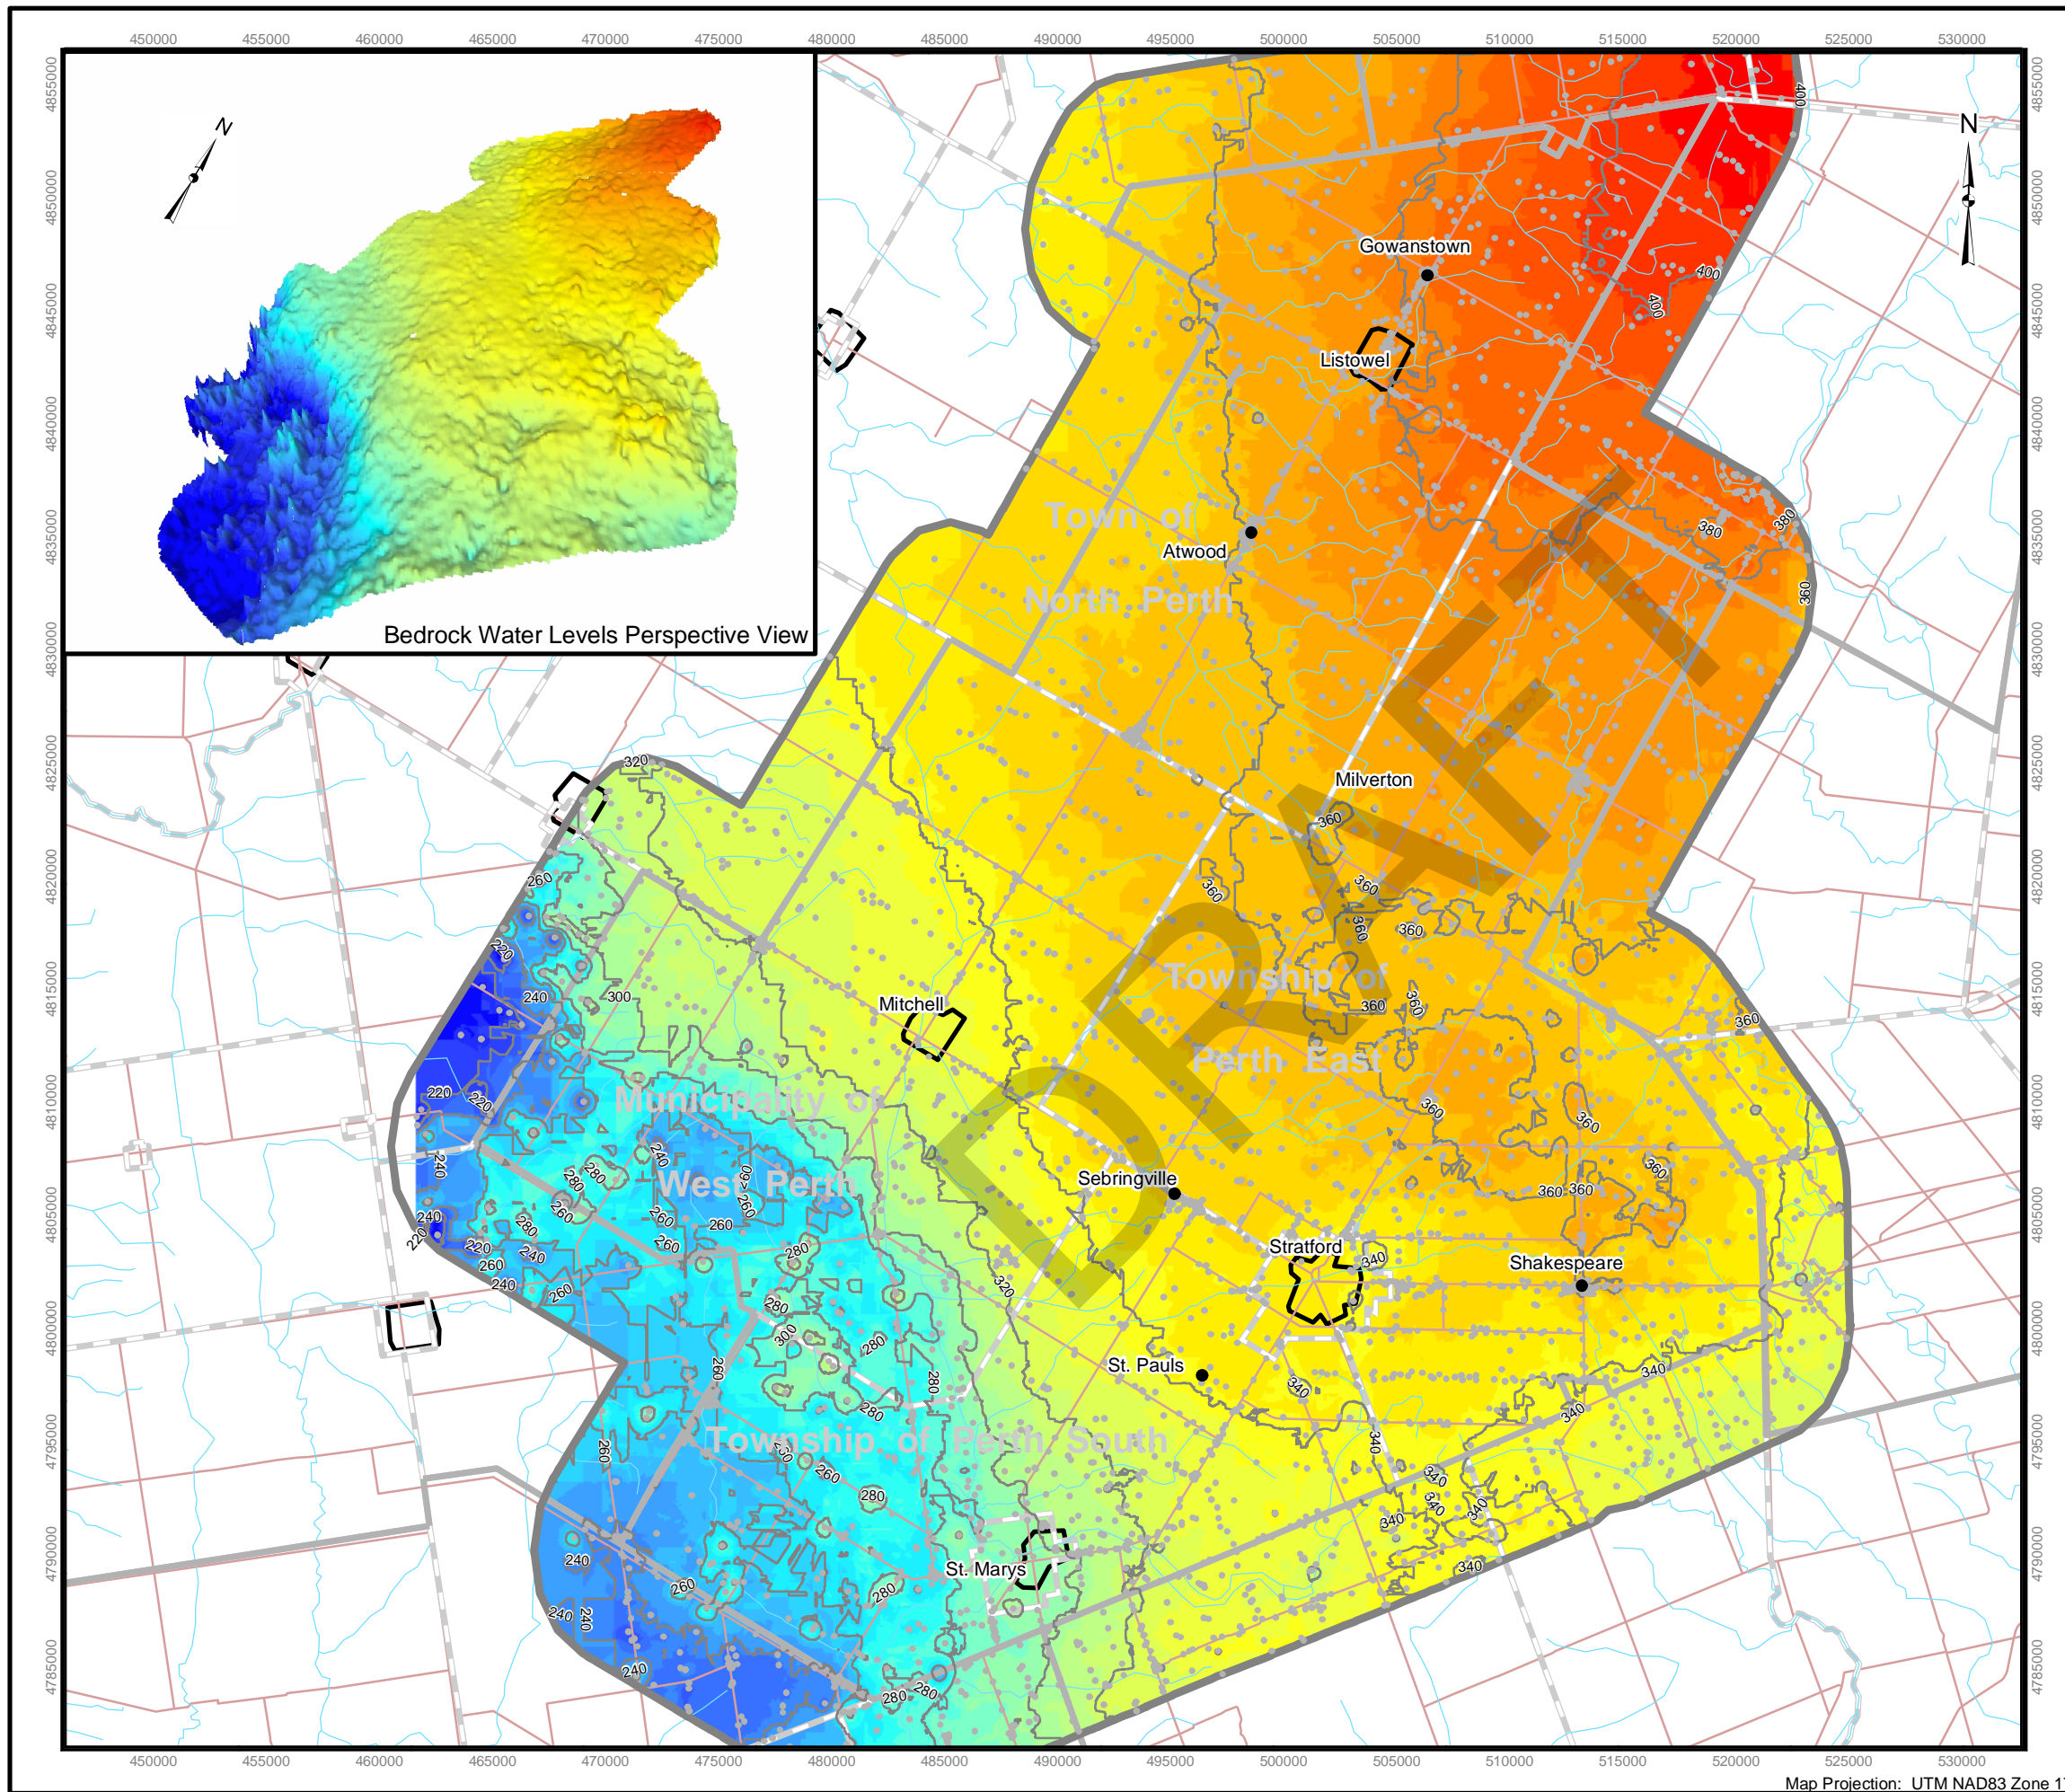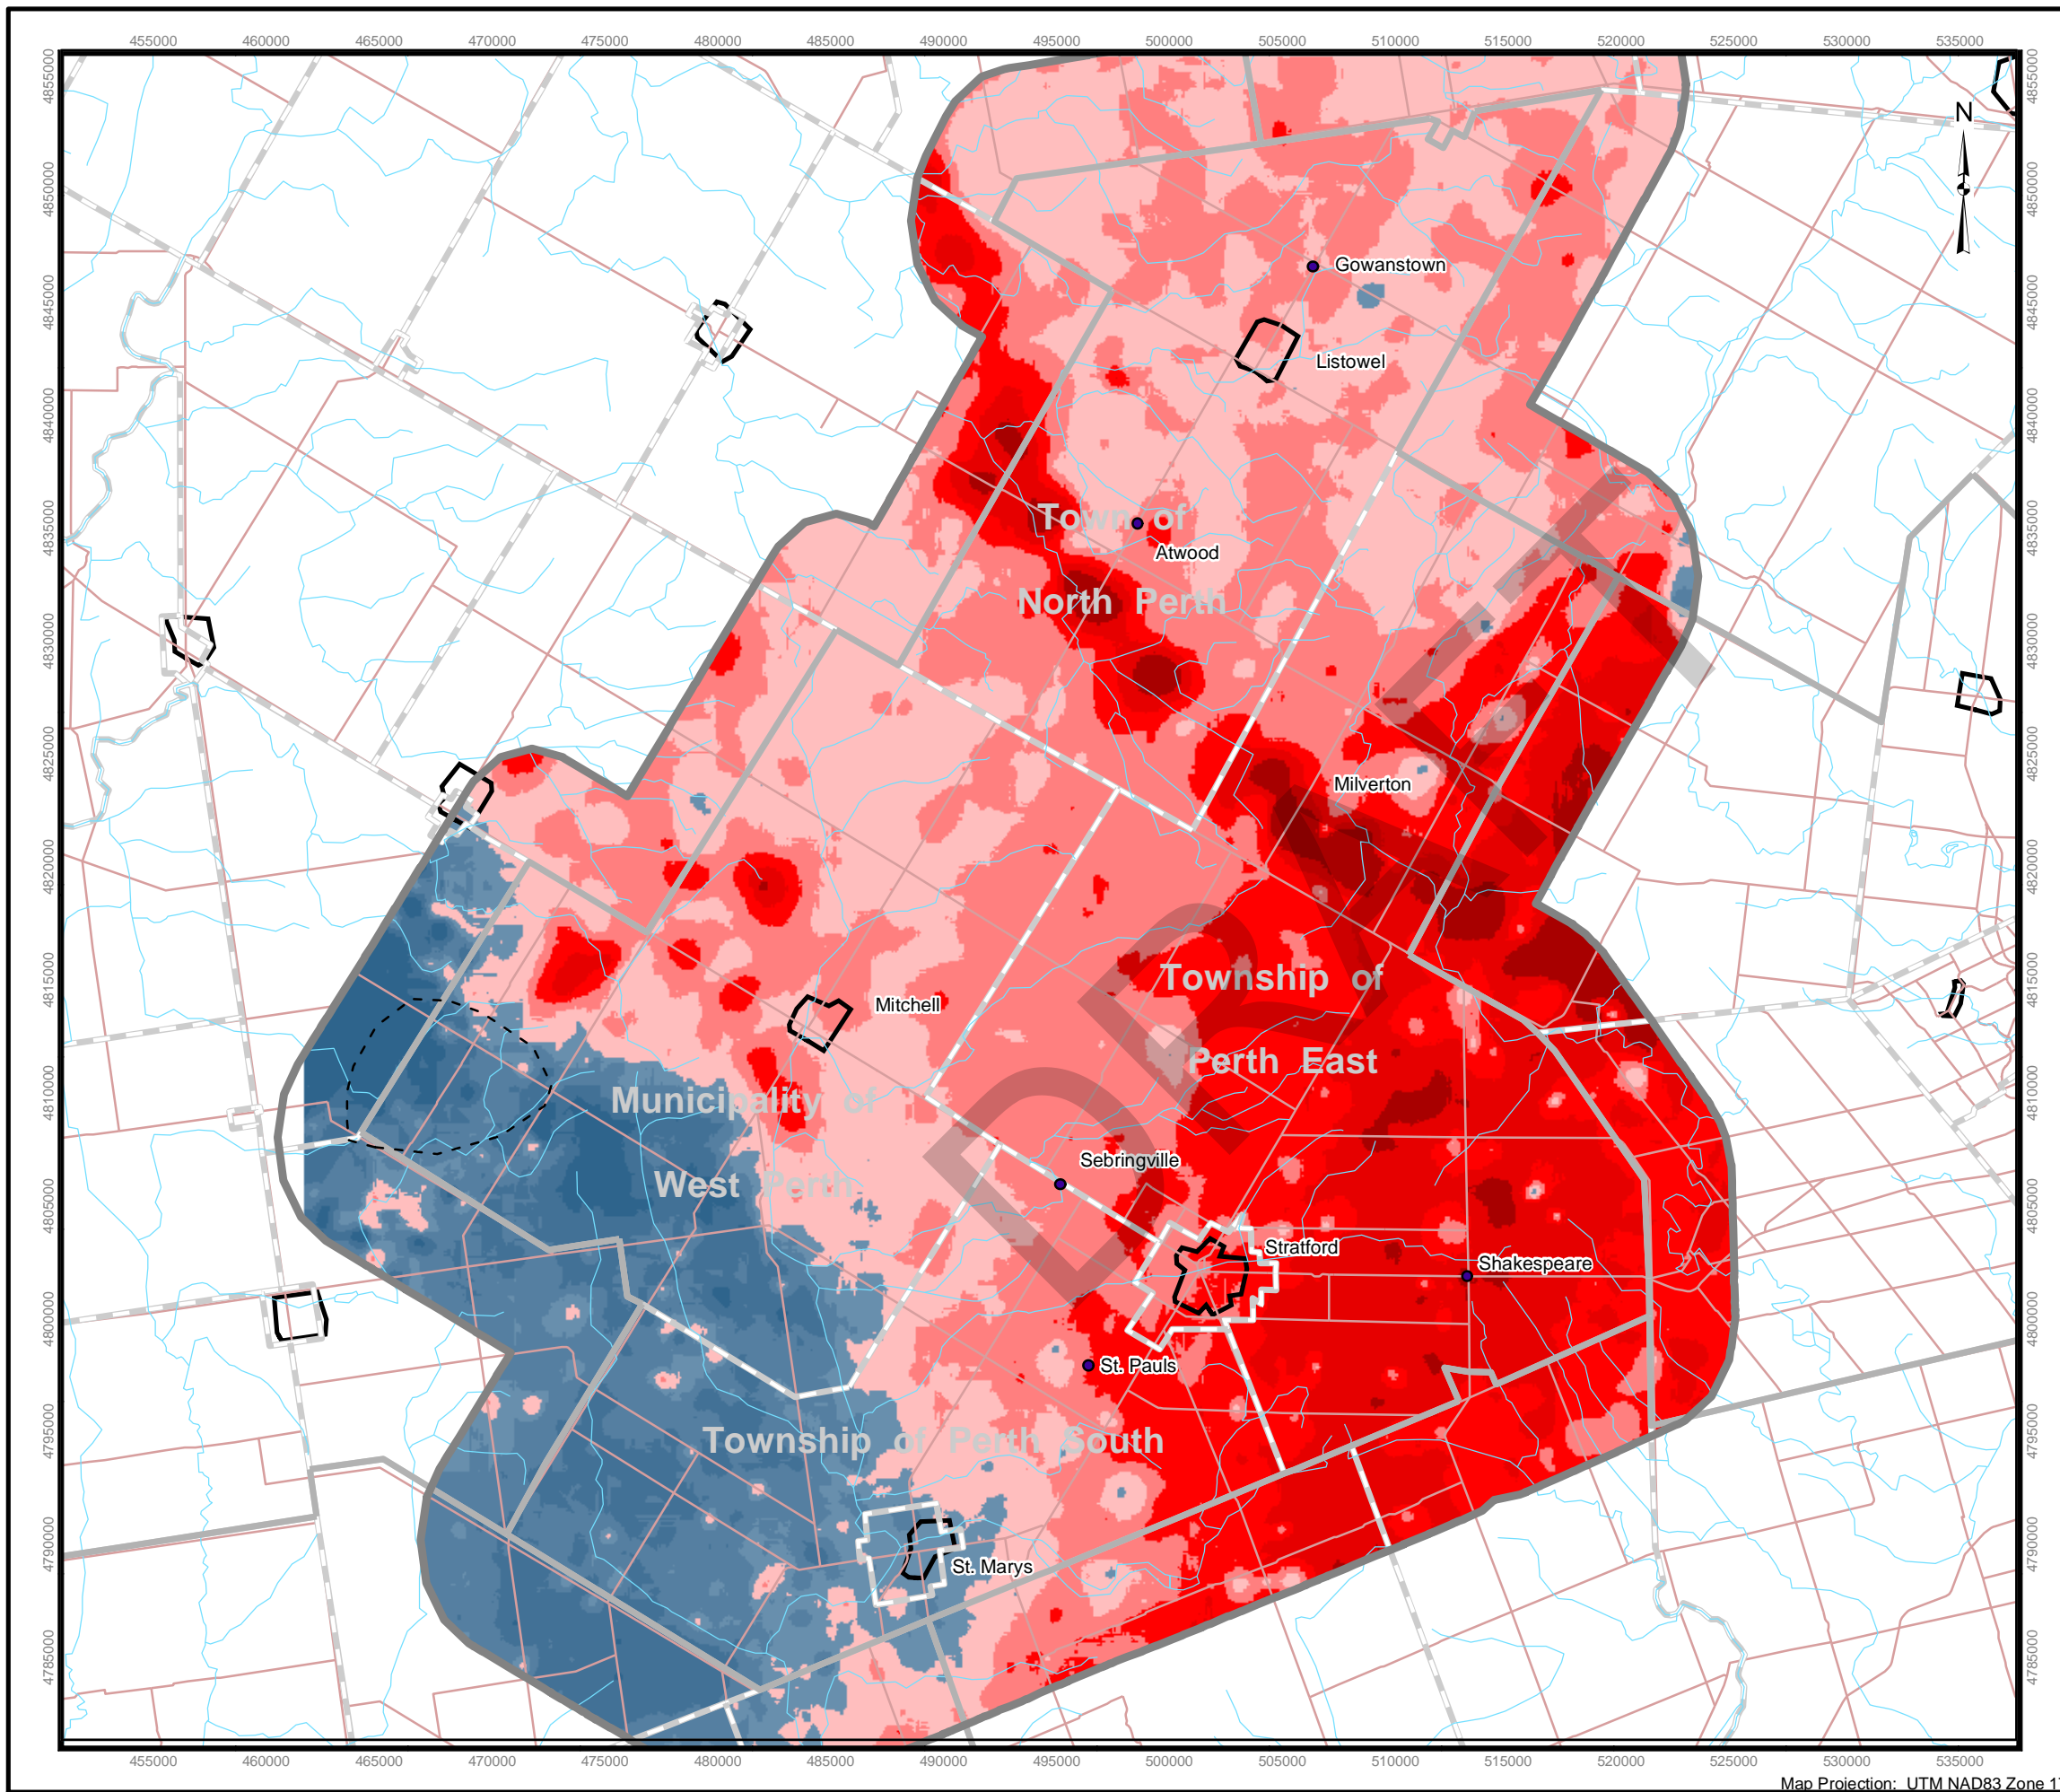Figure 2.22 : Bedrock Water Levels







Perth County Groundwater Management Study

Legend

- Bedrock Well Locations
- County Boundaries
- - - Township Boundaries
- ▬ Study Area Boundary
- Rivers
- Roads
- ▭ Population Centres
- - - Karst Area

Water Level > Bedrock Surface	 49.41 - 90.56
	 35.05 - 49.41
	 23.29 - 35.05
	 14.15 - 23.29
	 0 - 14.15
Water Level < Bedrock Surface	 0 - -11.32
	 -11.32 - -26.34
	 -26.34 - -44.63
	 -44.63 - -76.63

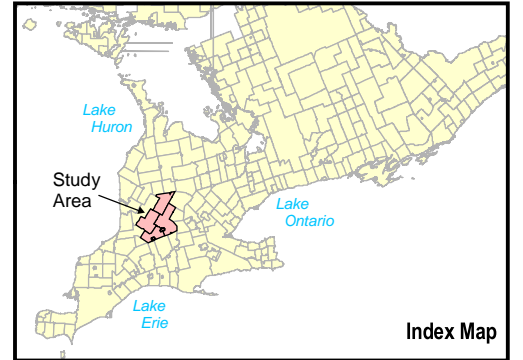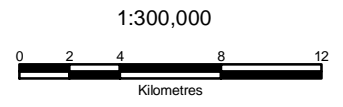

Disclaimer: This map is intended for illustrative purposes only. Figure is to be read in conjunction with the Perth County Groundwater Management Study.
 Digital Mapping Sources: Base mapping features - Ministry of the Environment.
 Water well information - Ministry of the Environment.
 Sinkhole Area - Ministry of the Environment and R.Hopper.

Date: April 2003



Figure 2.23 : Bedrock Water Levels Relative to Bedrock Topography



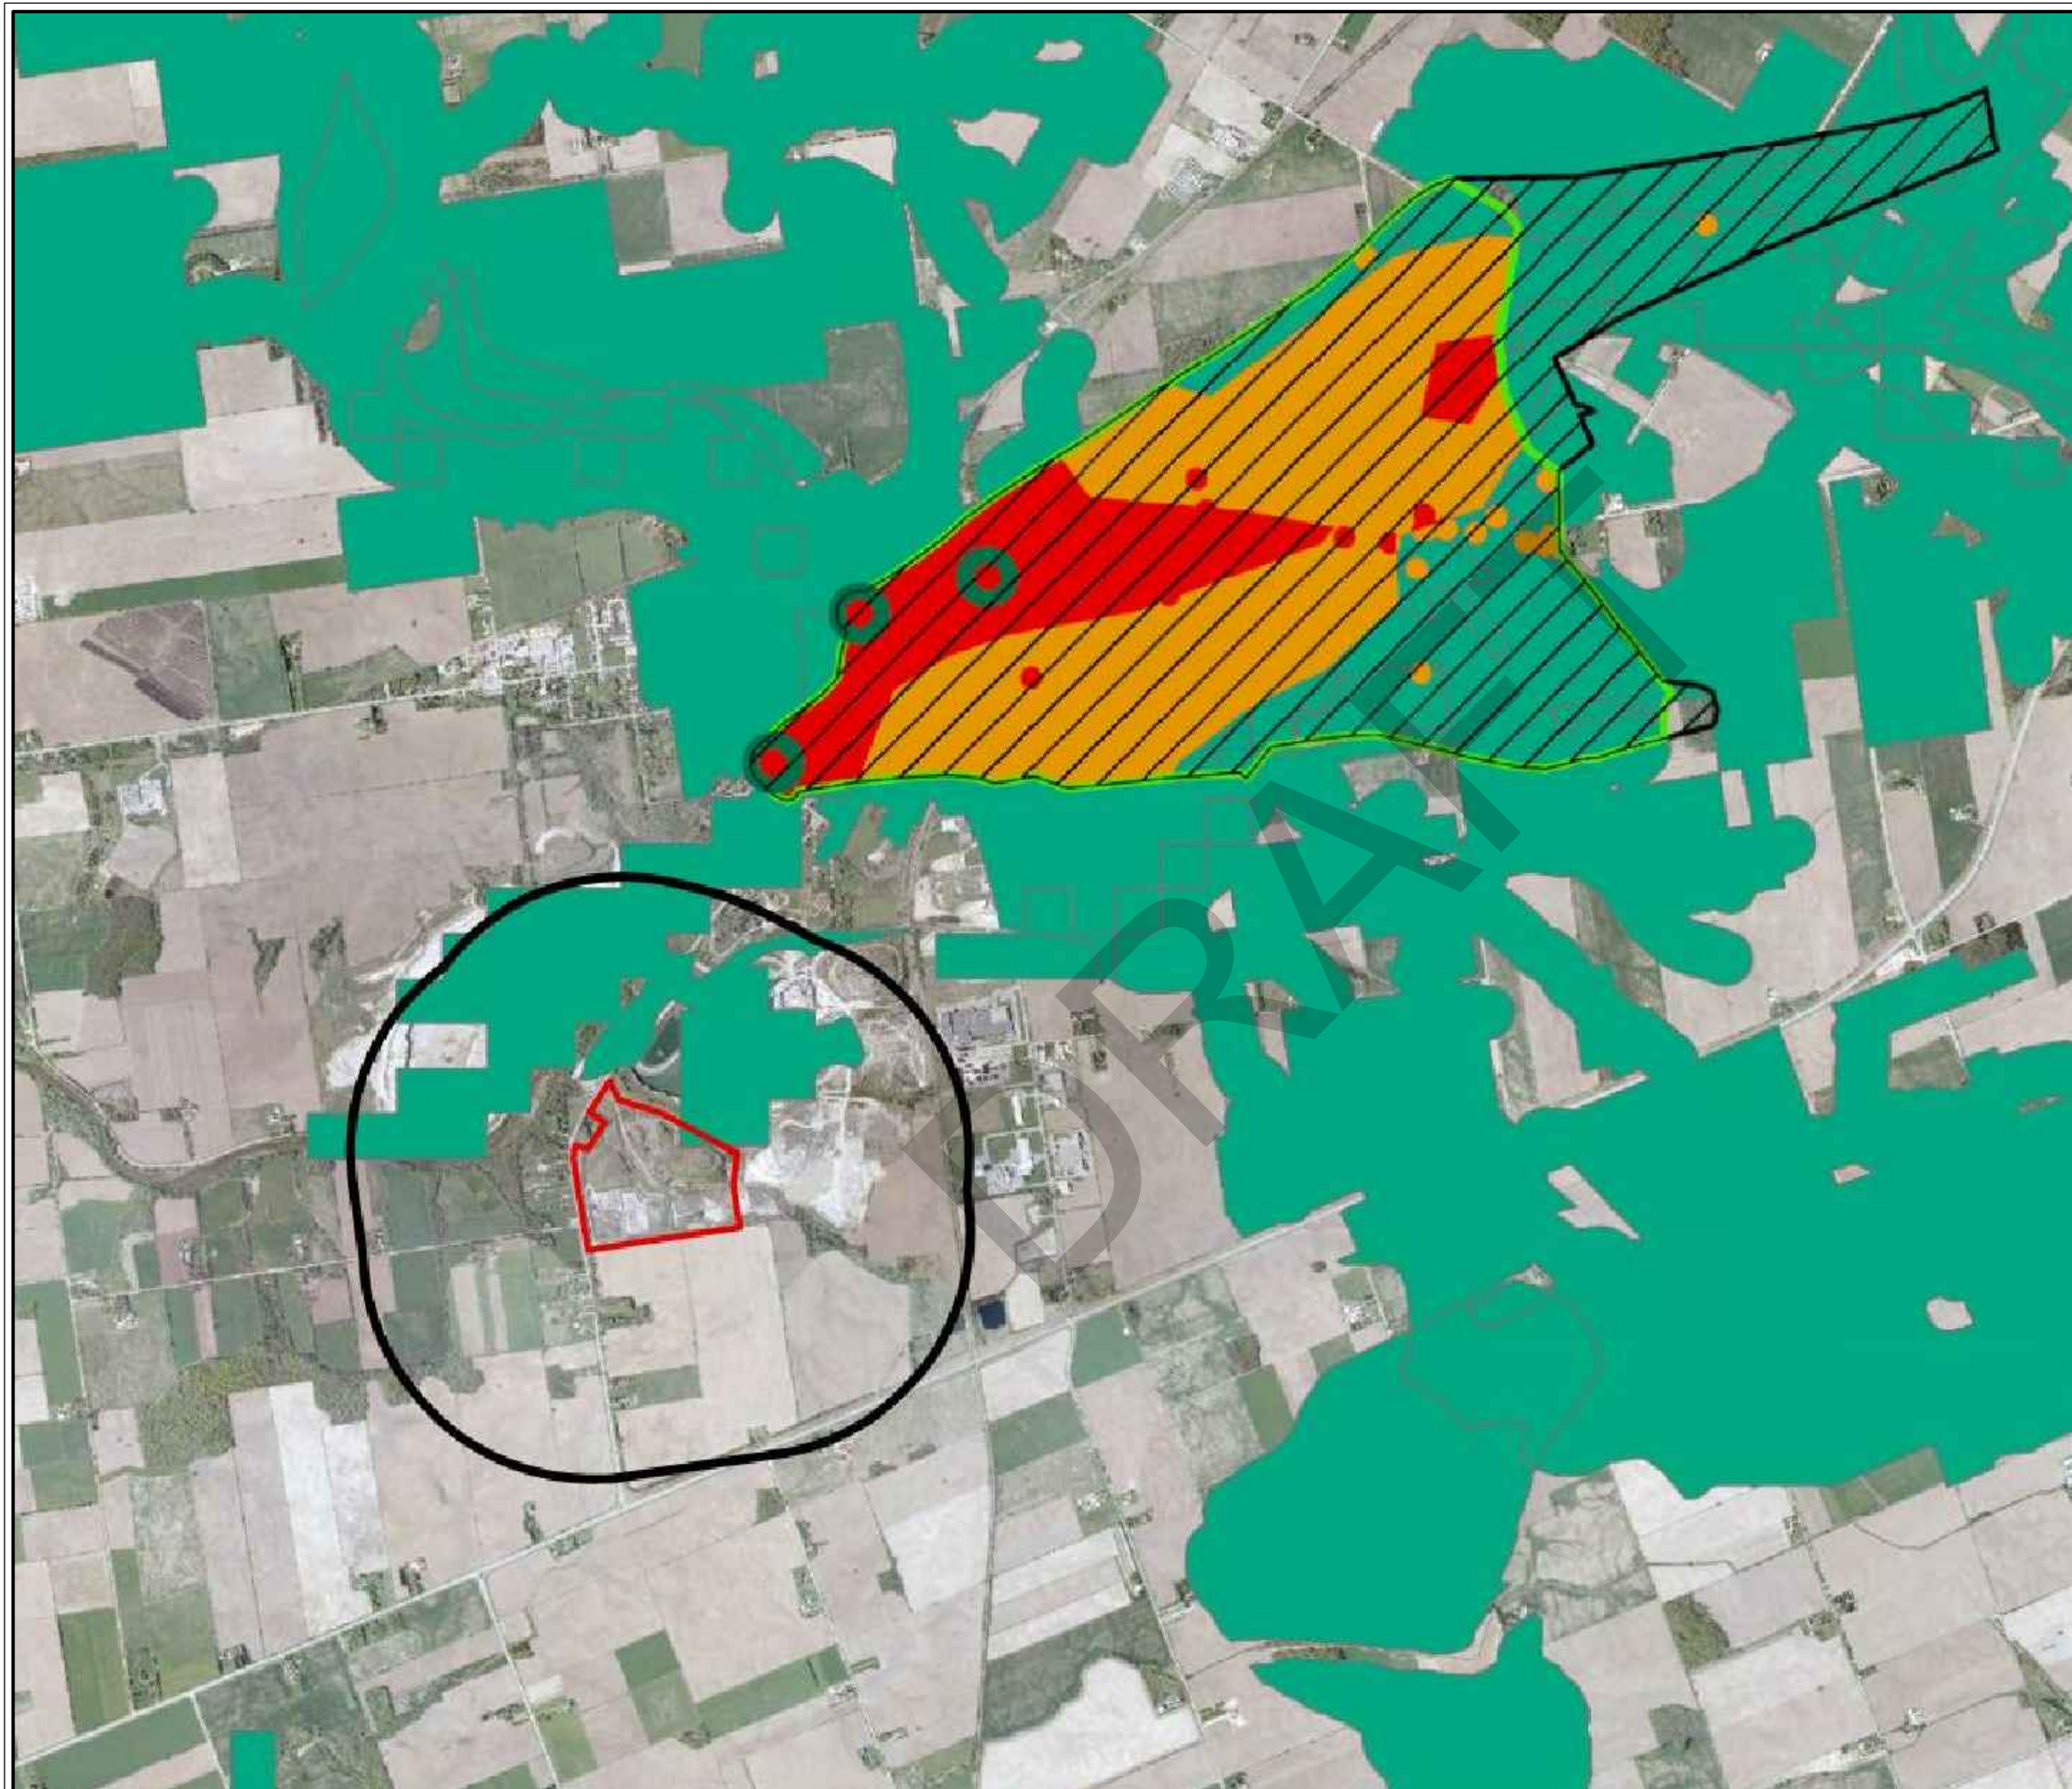
BURNSIDE

[THE DIFFERENCE IS OUR PEOPLE]

Appendix E

Source Protection Mapping

DRAFT





LEGEND

Significant Threat Policy Area Details - Approved
Significant Threat Policy Applicability

- WHPA-A
- WHPA-B
- WHPA-C
- Vulnerability Score of 10
- Vulnerability Score of 9
- Vulnerability Score of 8
- Issue Contributing Area
- DNAPL Policy Area WHPA-A,B,C
- Event Based Area
- See Essex SPA for Details
- Moderate and Low Threat Policy Area - Approved

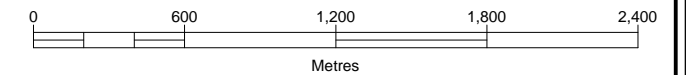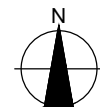Source: Mapping obtained from Upper Thames River Valley Conservation Authority. Upper Thames River Source Protection Area Assessment Report, September 16, 2015.




Client / Report

TOWN OF ST MARYS
ENVIRONMENTAL ASSESSMENT
HYDROGEOLOGICAL ASSESSMENT

Figure Title

SIGNIFICANT THREAT POLICY AREAS



Drawn SK	Checked CM	Date MARCH 2016	Figure No. E1
Scale 1:30,000	Project No. 300032339		

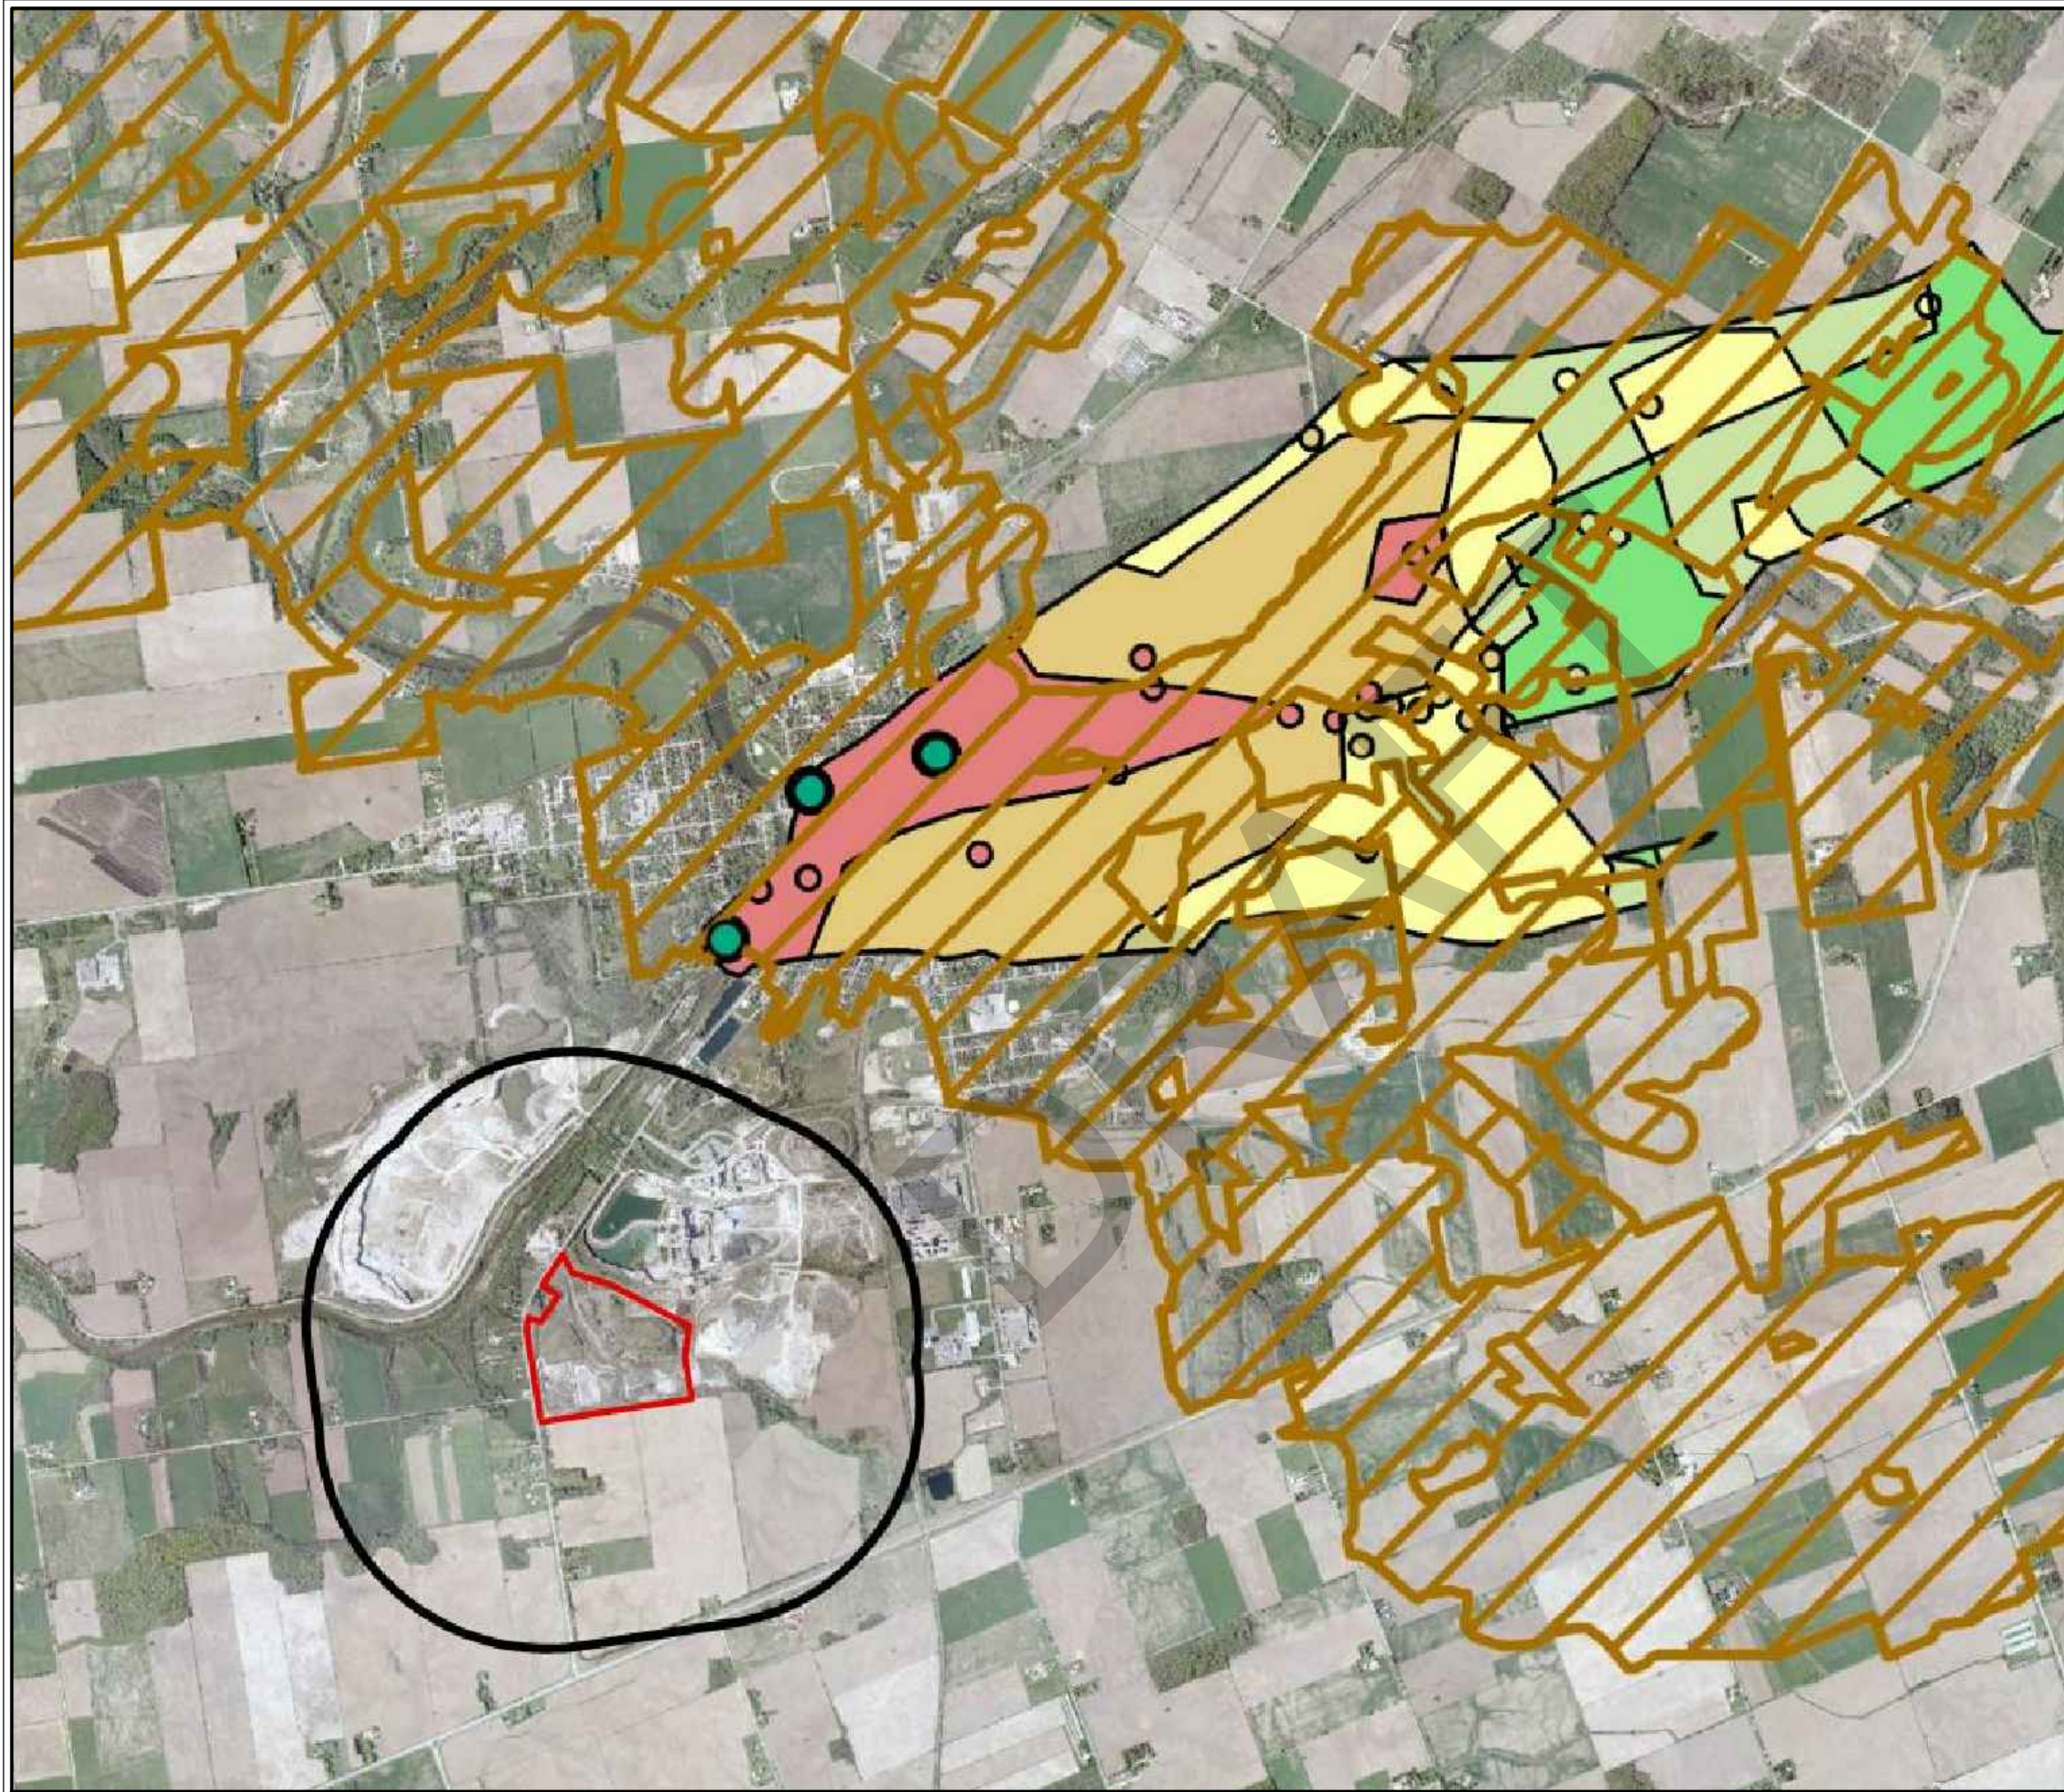

LEGEND

- Municipal Wells
- Wellhead Protection Area Vulnerability - Approved
- Vulnerability Score
 - Vulnerability = 2
 - Vulnerability = 4
 - Vulnerability = 6
 - Vulnerability = 8
 - Vulnerability = 10
 - Vulnerability = 6.3 (WHPA-E)
 - Vulnerability = 7.0 (WHPA-E)
 - Vulnerability = 7.2 (WHPA-E)
 - Issue Contributing Area
- Intake Protection Zone/Vulnerability - Approved
- IPZ_Zone
 - IPZ-1
 - IPZ-2
 - IPZ-3
 - EBA
 - See Essex SPA

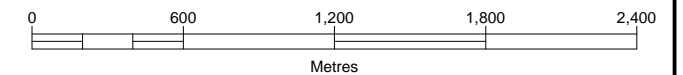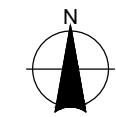Source: Mapping obtained from Upper Thames River Valley Conservation Authority. Upper Thames River Source Protection Area Assessment Report, September 16, 2015.




Client / Report

TOWN OF ST MARYS
 ENVIRONMENTAL ASSESSMENT
 HYDROGEOLOGICAL ASSESSMENT

Figure Title

WELLHEAD PROTECTION AREAS

Drawn SK	Checked CM	Date MARCH 2016	Figure No. E2
Scale 1:30,000	Project No. 300032339		

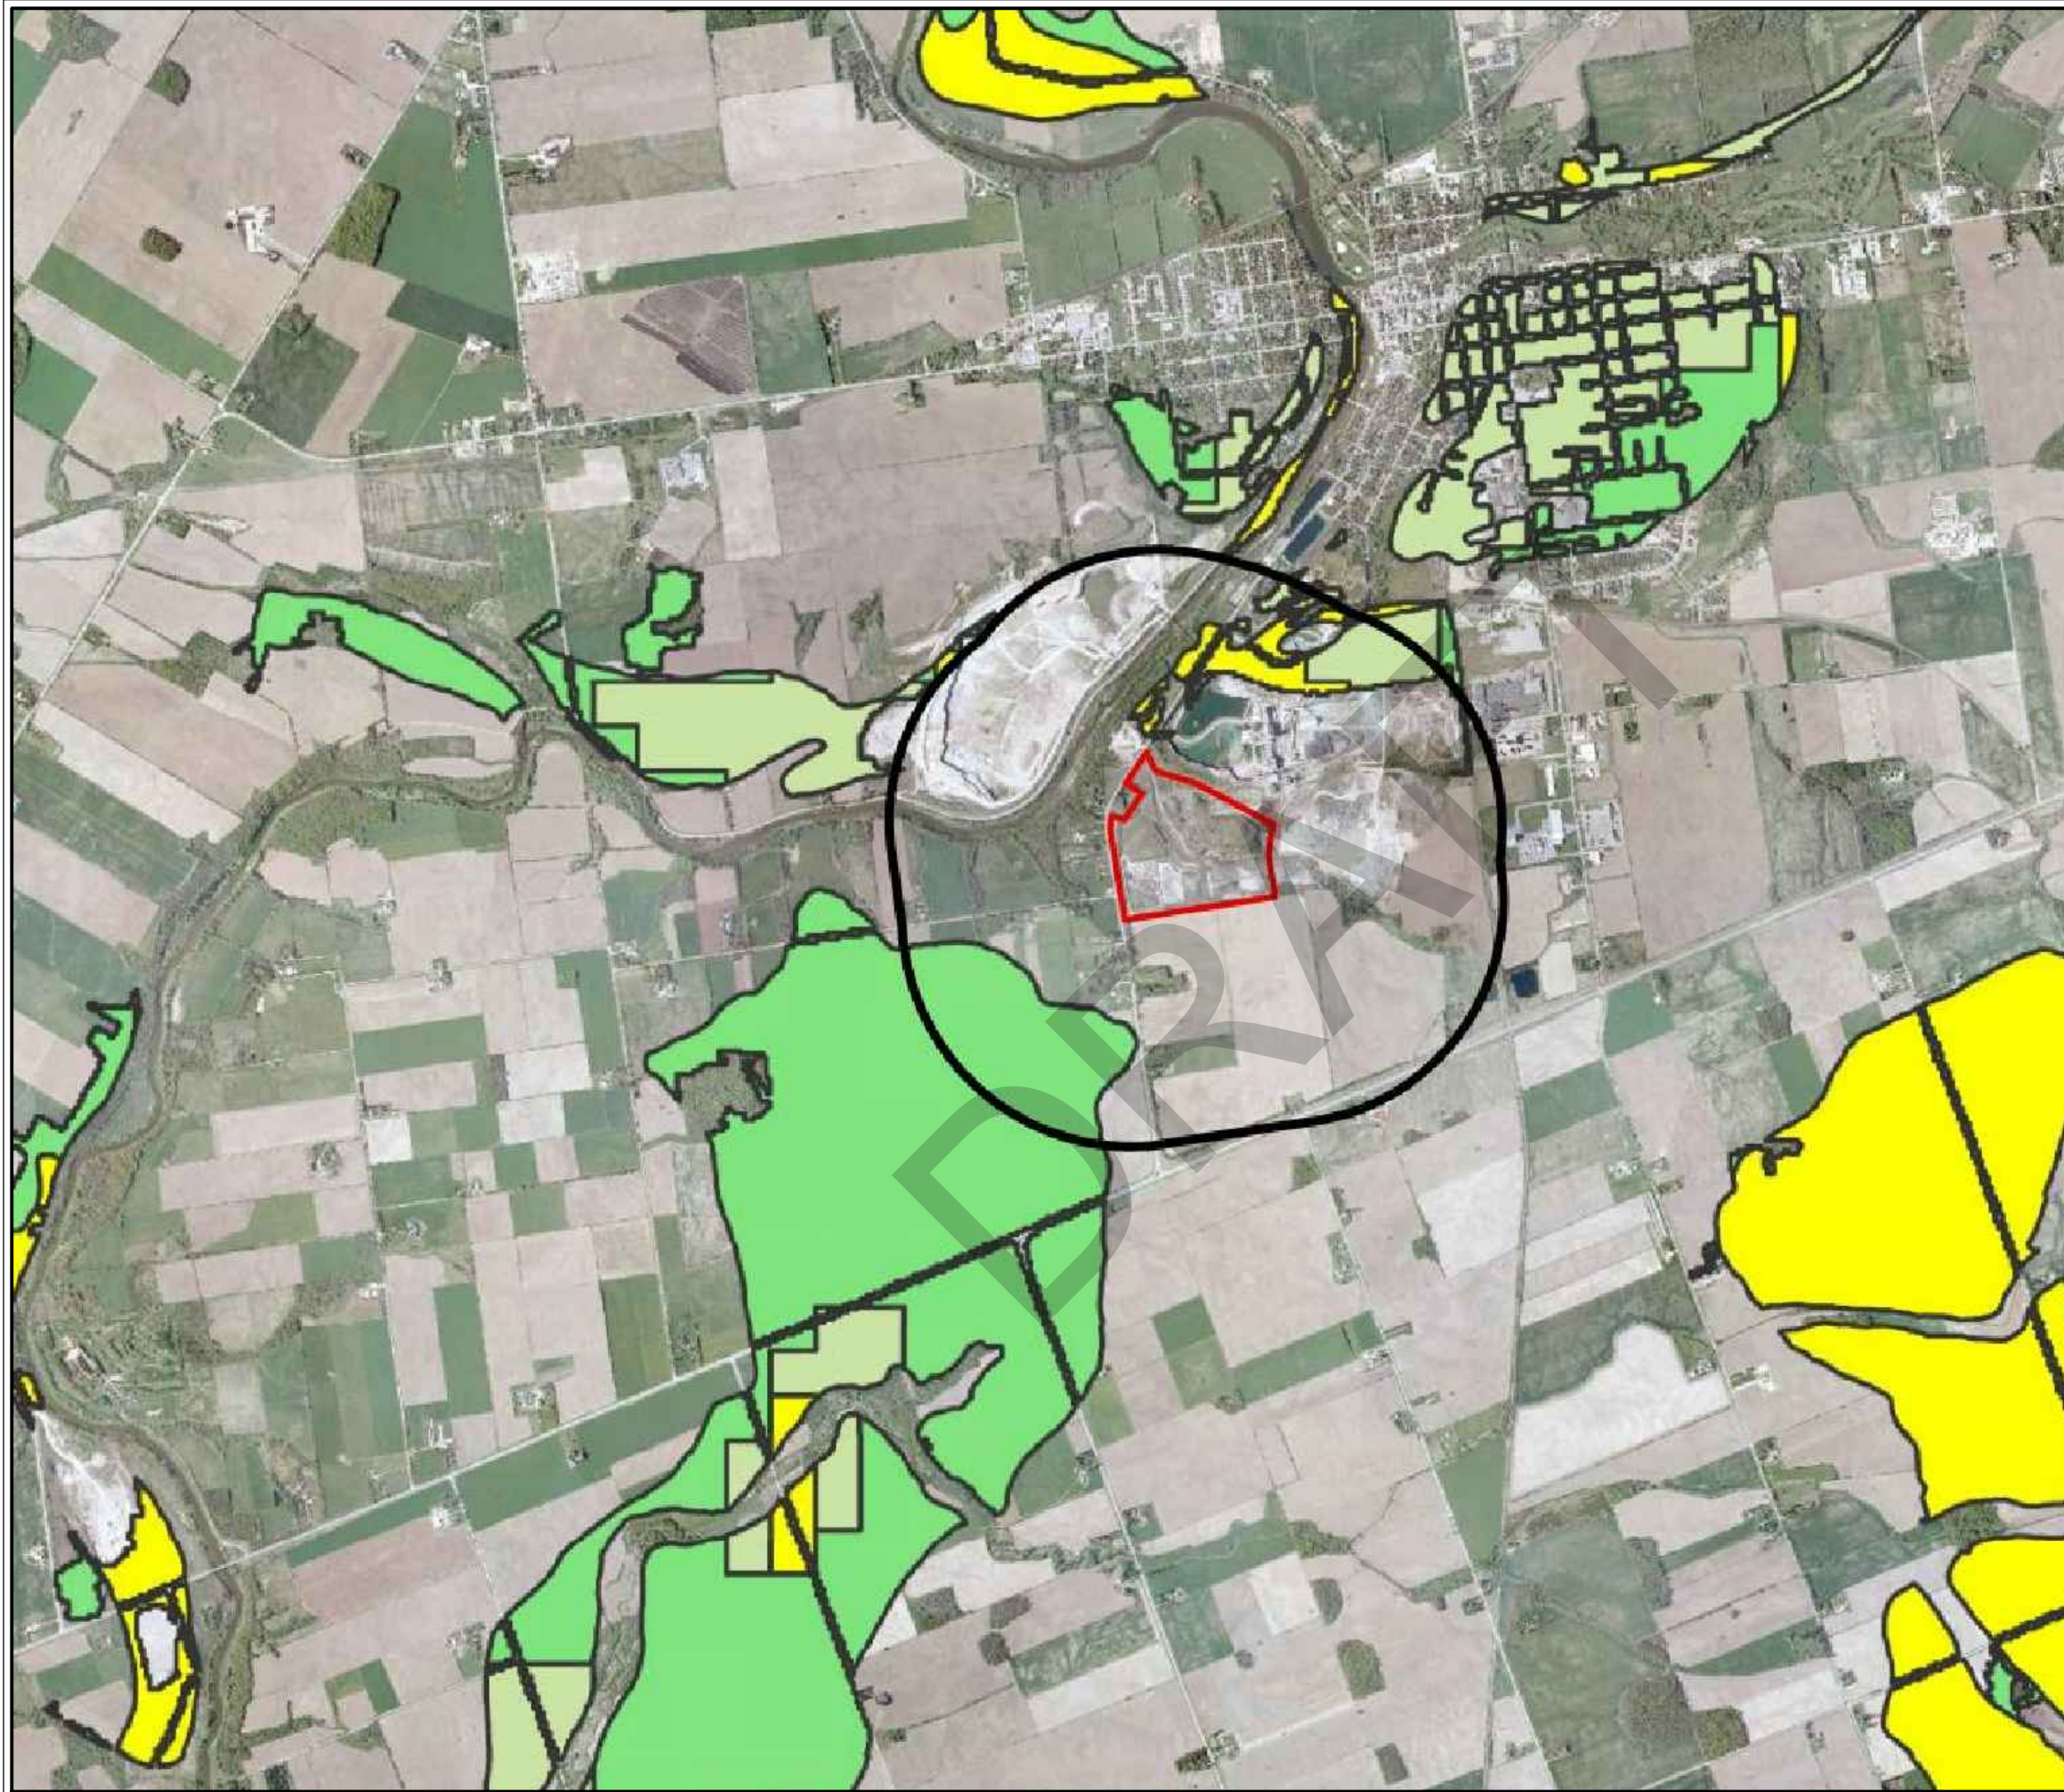


LEGEND

Significant Groundwater Recharge Area - Approved

- Vulnerability Score
- Vulnerability = 2
 - Vulnerability = 4
 - Vulnerability = 6

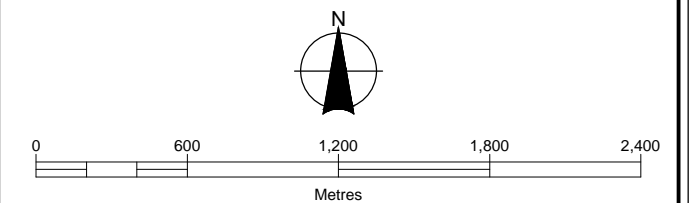Source: Mapping obtained from Upper Thames River Valley Conservation Authority. Upper Thames River Source Protection Area Assessment Report, September 16, 2015.




Client / Report

TOWN OF ST MARYS
 ENVIRONMENTAL ASSESSMENT
 HYDROGEOLOGICAL ASSESSMENT

Figure Title

**SIGNIFICANT GROUNDWATER
 RECHARGE AREAS**


Drawn SK	Checked CM	Date MARCH 2016	Figure No. E3
Scale 1:30,000	Project No. 300032339		

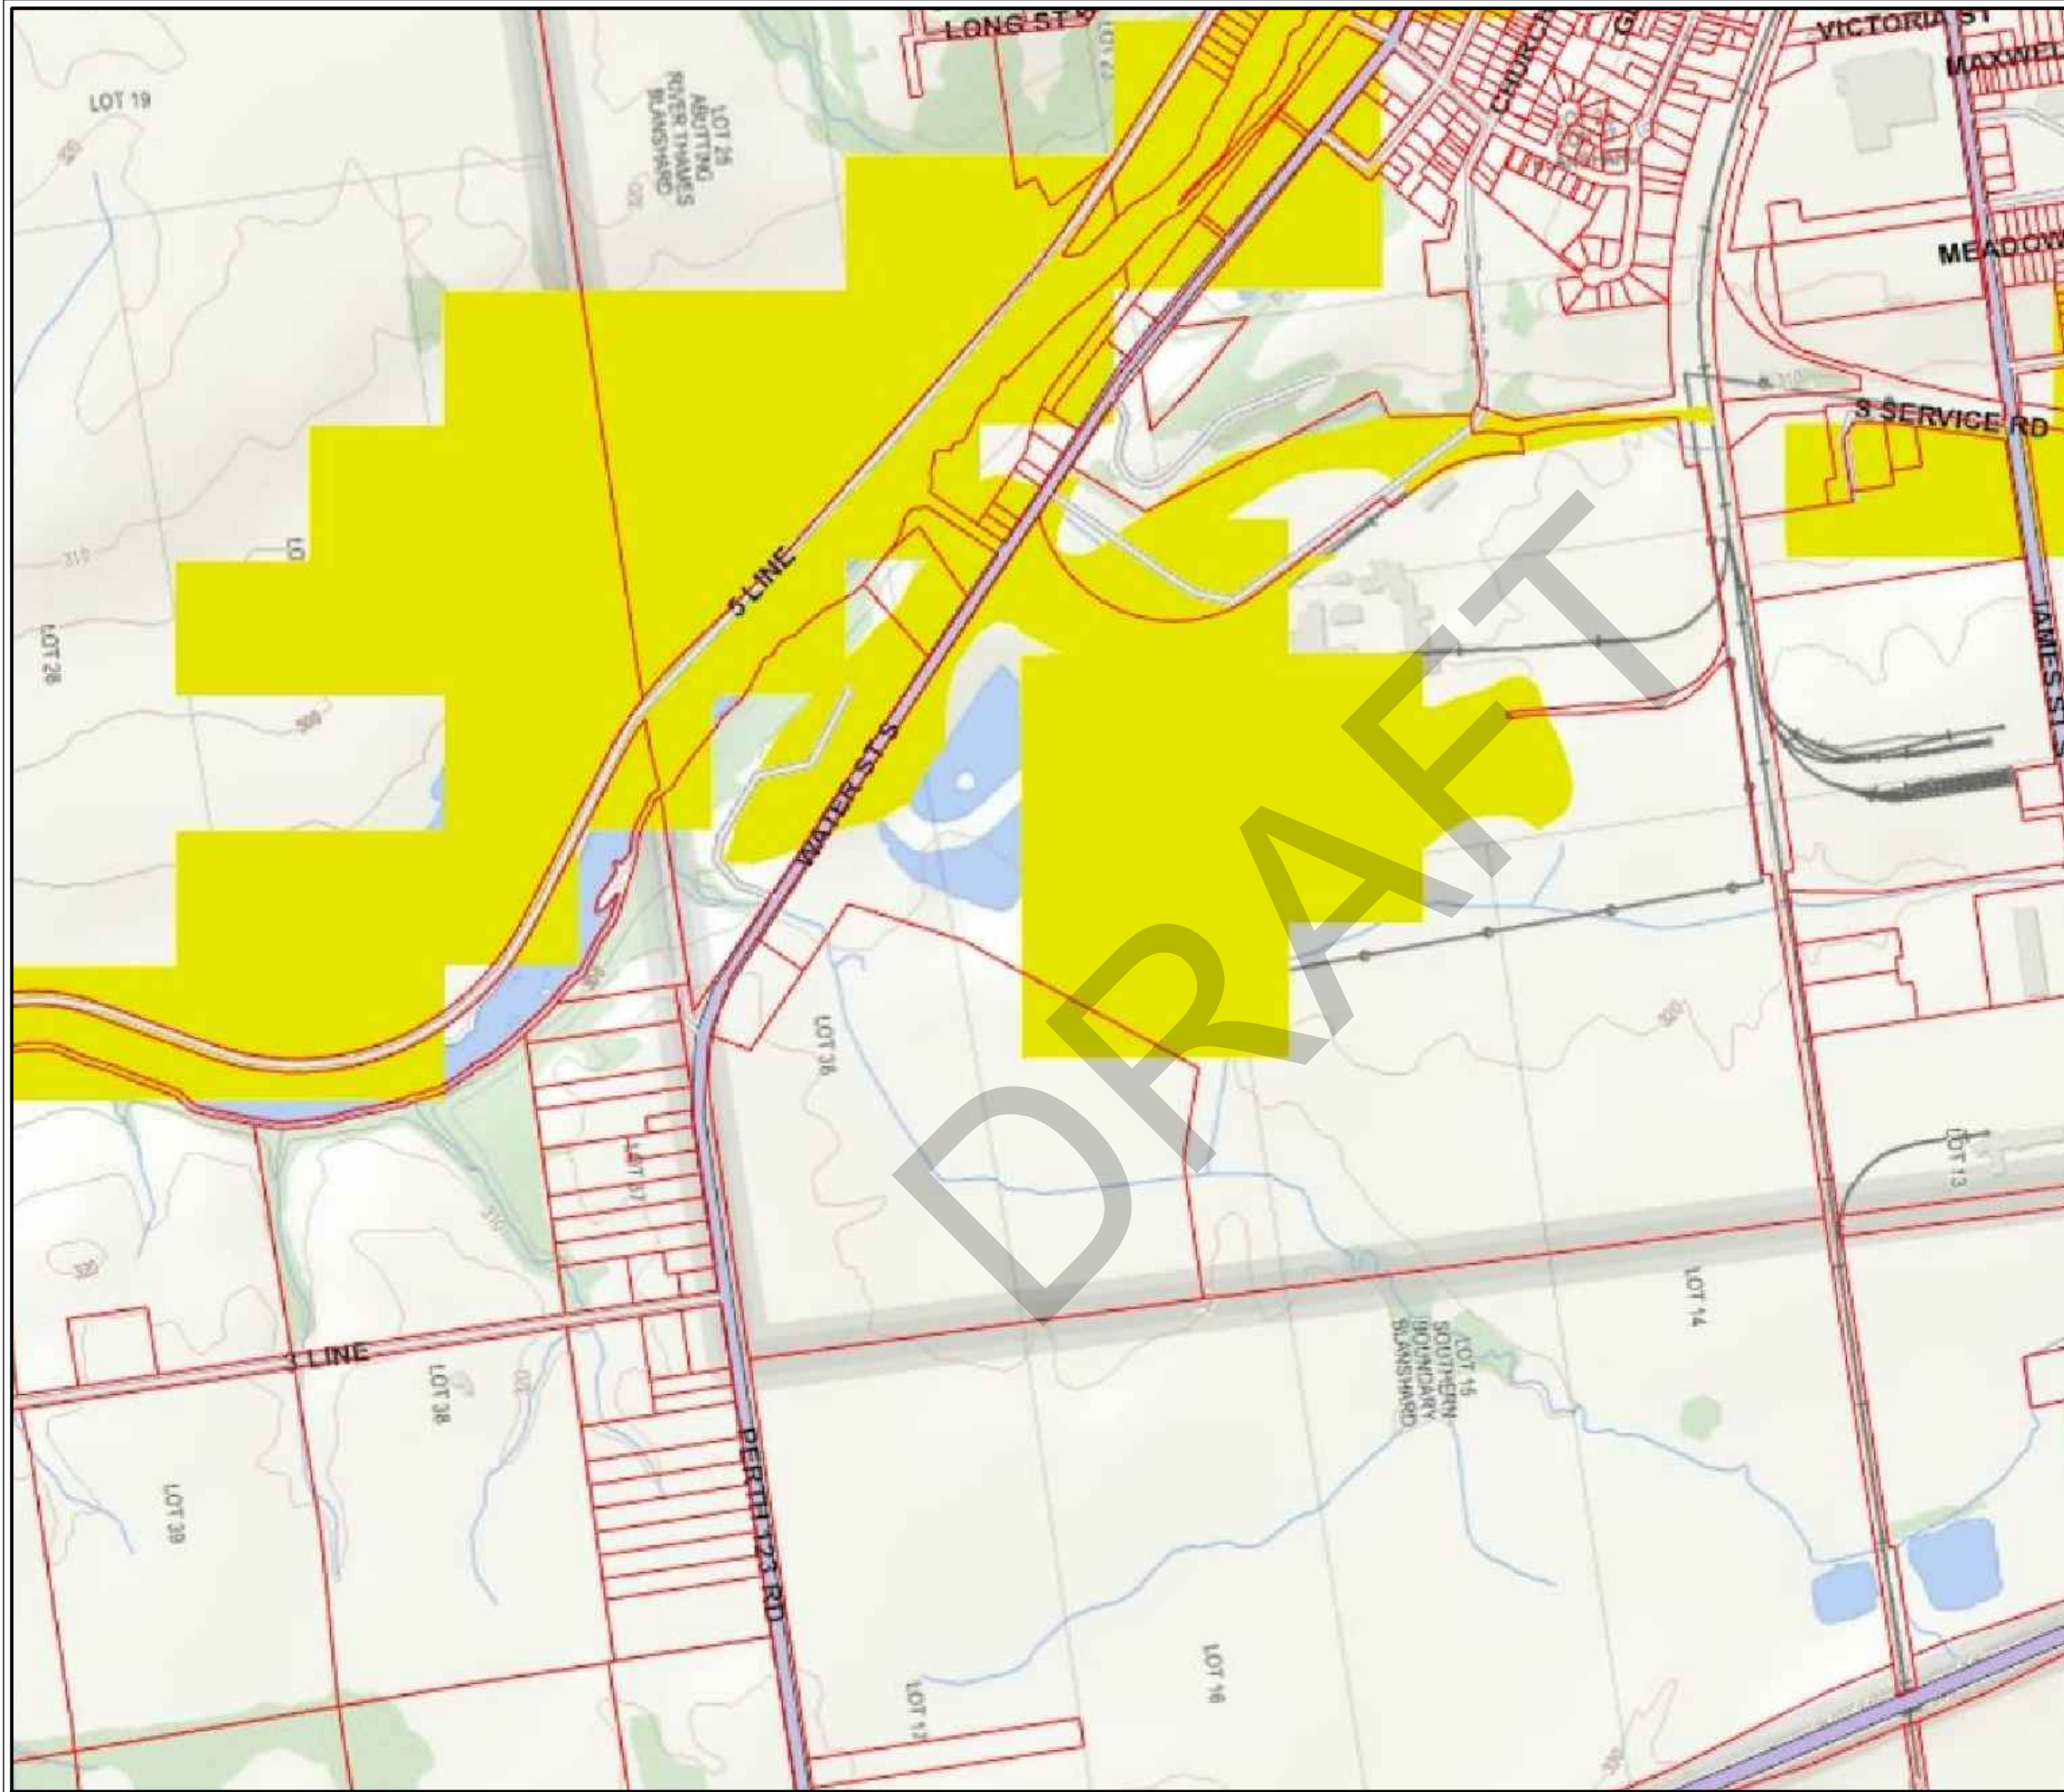

LEGEND

- Source Protection Region
- Assessment Parcel (MPAC)
- Highly Vulnerable Aquifer - Approved

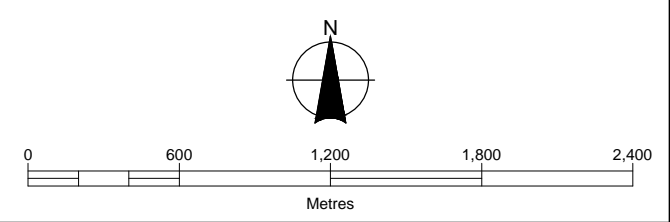Source: Mapping obtained from Upper Thames River Valley Conservation Authority. Upper Thames River Source Protection Area Assessment Report, September 16, 2015.



Client / Report

**TOWN OF ST MARYS
ENVIRONMENTAL ASSESSMENT
HYDROGEOLOGICAL ASSESSMENT**

Figure Title

HIGHLY VULNERABLE AQUIFERS

Drawn SK	Checked CM	Date MARCH 2016	Figure No. E4
Scale 1:30,000		Project No. 300032339	



BURNSIDE

[THE DIFFERENCE IS OUR PEOPLE]

Appendix F

Water Level Monitoring

Water Level Monitoring	F1
Groundwater Flow Maps	F2

DRAFT

Table F1.2
Vertical Gradients
St. Marys Landfill

Vertical Gradients					
Shallow well	OW4-84	OW8B-10	OW9B-91	OW32-96	OW34-96
Top of screen	312.77	308.89	313.64	316.61	316.48
Bottom of screen	311.47	307.99	311.64	311.11	311.78
Mid-point	312.12	308.44	312.64	313.86	314.13
Deep well	OW7-91	OW8A-91	OW9A-91	OW32A-02	OW33-96
Top of screen	280.89	287.59	280.56	281.86	310.95
Bottom of screen	275.49	281.89	277.36	278.81	307.25
Mid-point	278.19	284.74	278.96	280.34	309.10
Sep-91	-0.79		-0.85		
Sep-91	-0.79		-0.85		
Nov-91	-0.79		-0.86		
Nov-91			-0.86		
Dec-91	-0.78		-0.85		
Dec-91	-0.77		-0.85		
Dec-91			-0.84		
Dec-91			-0.84		
Dec-91	-0.75		-0.83		
Jan-92	-0.73		-0.82		
Feb-92	-0.72		-0.85		
Feb-92	-0.72		-0.82		
Mar-92	-0.69		-0.80		
May-92	-0.72		-0.82		
Aug-92	-0.76		-0.83		
Nov-92	-0.71		-0.81		
Feb-93	-0.68		-0.77		
May-93			-0.80		
Aug-93			-0.82		
Apr-94	-0.71		-0.80		
Sep-94			-0.86		
Apr-95	-0.74		-0.84		
Sep-95			-0.87		
Apr-96	-0.70		-0.83		
Sep-96			-0.86		-1.41
Apr-97	-0.71		-0.81		-1.64
Sep-97			-0.84		-1.39
Apr-98	-0.78		-0.84		-1.64
Sep-98			-0.89		-1.24
Apr-99			-0.88		-1.64
Sep-99			-0.90		-1.23
Apr-00			-0.90		-1.65
Sep-00			-0.88		-1.57
Apr-01	-0.71		-0.85		-1.63
Sep-01			-0.88		-1.23
Apr-02	-0.74		-0.87		-1.64
Sep-02			-0.88		-1.27
Apr-03	-0.74		-0.87	-0.94	-1.67
Sep-03			-0.89	-0.94	-1.26
May-04	-0.73		-0.85	-0.93	-1.65
Sep-04			-0.89	-0.95	-1.35
Apr-05	-0.76		-0.88	-0.96	-1.67
Nov-05			-0.93	-0.99	-1.27
Apr-06	-0.73		-0.86	-0.94	-1.65
Nov-06	-0.75		-0.88	-0.96	-1.67
Apr-07	-0.73		-0.86	-0.94	-1.63
Nov-07	-0.80		-0.92	-0.95	-1.16
Apr-08	-0.70		-0.84	-0.92	-1.67
Nov-08	-0.79		-0.89	-0.96	-1.58
Apr-09	-0.73		-0.84	-0.92	-1.63
Nov-09			-0.88	-0.96	-1.43
Mar-10	-0.74		-0.87	-0.95	-1.63
Nov-10	-0.80		-0.89	-0.97	-1.44
Mar-11			-0.85	-0.94	-1.65
Dec-11	-0.77	-0.88	-0.87	-0.96	-1.68
Apr-12		-0.90	-0.87	-0.95	-1.54
Nov-12		-0.95	-0.87	-0.95	-1.33
May-13	-0.72	-0.84	-0.85		-1.66
Oct-13	-0.78	-0.92	-0.88	-0.96	-1.68
Jun-14		-0.92	-0.88	-0.95	-1.52
Nov-14		-0.96	-0.89	-0.98	-1.54
May-15		-0.94	-0.88	-0.96	-1.55
Sep-15		-0.97	-0.90	-0.97	-1.31
Dec-15		-0.96	-0.90	-0.98	-1.44
Mar-16	-0.79	-0.91	-0.88	-0.96	-1.65
Mar-16	-0.79	-0.92	-0.87	-0.96	-1.67

Notes:

- downward gradient + upward gradient

R.J. Burnside & Associates Limited

File: 032339 St. Marys 2016 EA HG Study Tables.xls

Date: 5/3/2016

Table F1.3
Surface Water Measurements
St. Marys Landfill

Location	Upstream	Flow (4)	Basin B		Midstream	Basin A			Downstream	
	SP1-10*		SP1B-94 (Inlet)	SP2B-94 (Outlet)	SP2-93	SP3A-94 (South Inlet)	SP5A-94 (North Inlet)	SP4A-94 (Outlet)	SP3-93	Flow Measurement (4)
Reference Elevation	311.240		314.63	(2)	310.190	314.42	314.62	(2)	310.32 (Shallow) 309.38 (Deep)	
Feb-93	310.01				309.2				308.44	
Aug-93	Dry				Dry				Dry	
Apr-94	310.3		313.1		309.7	313.19	313.19		309.22	167 L/s
Sep-94	310.06		312.45	Dry	309.39	Dry	Dry	Dry	308.9	12.7 L/s
Apr-95	310.25		313.56	Flowing	309.64	313.81	313.48	Flowing	309.23	170 L/s
Sep-95	310.06		312.49	Dry	309.33	Dry	Dry	Dry	309.25	28 L/s
Oct-95	3 310.17		NA	Flowing	309.48	--	313.08	Flowing	309.13	130 L/s
Apr-96	310.19		NA	Flowing	309.49	Dry	Dry	Flowing	309.04	160 L/s
Sep-96	310.08		312.57	Dry	309.32	Dry	Dry	Dry	308.87	9 L/s
Oct-96	3 310.23		NA	Flowing	309.52	313.54	313.03	Flowing	309.11	230 L/s
Apr-97	310.11		313.37	Flowing	309.35	313.63	313.02	Flowing	308.96	58.6 L/s
Sep-97	309.95		NA	Flowing	309.19	Dry	Dry	Flowing	NA	4.7 L/s
Apr-98	3 310.11		NA	Flowing	309.42	313.51	313.06	Flowing	309.06	118 L/s
Apr-98	310.01		312.64	Flowing	309.29	Dry	313.01	Flowing	309.03	220 L/s
Sep-98	309.91		312.1	Flowing	309.22	Dry	Dry	Dry	NA	10 L/s
Apr-99	310.05		312.60	Flowing	309.37	Dry	Flowing	Flowing	309.07	60 L/s
Jun-99	3 310.12		313.33	Flowing	309.41	Dry	Flowing	Flowing	309.06	35 L/s
Sep-99	310.00		313.01	Flowing	309.28	Dry	Dry	Dry	309.01	41 L/s
Apr-00	310.05		313.54	Flowing	309.44	Dry	313.23	Flowing	309.04	146 L/s
Jun-00	3 310.46		313.74	Flowing	310.05	313.69	313.54	Flowing	>309.38	4012 L/s
Sep-00	310.03		313.59	Flowing	309.44	313.77	313.62	Flowing	309.01	98 L/s
Apr-01	310.02		313.39	Flowing	309.70	314.03	313.81	Flowing	309.05	89 L/s
Jun-01	3 310.01		313.49	Dry	309.73	Dry	312.54	Dry	309.08	784 L/s
Sep-01	309.92		Dry	Dry	309.54	Dry	Dry	Dry	308.99	17 L/s
Apr-02	309.96		313.58	Dry	309.61	314.14	313.92	Flowing	Dry	143.62 L/s
Sep-02	309.88		Dry	Dry	309.45	Dry	Dry	Dry	Dry	31.16 L/s
Apr-03	309.93		313.43	Flowing	309.69	Dry	Dry	Dry	309.06	118.52 L/s
Jun-03	3 309.93		313.6	Flowing	309.65	Flowing	Flowing	Flowing	309.06	42.08 L/s
Sep-03	309.82		Dry	Dry	309.50	Dry	Dry	Dry	Dry	28.15 L/s
May-04	309.86		NA		309.81	314.21	NA	Dry	NA	504 L/s
Sep-04	309.78		No Flow	No Flow	309.51	Dry	Dry	Dry	Dry	3.54 L/s
Apr-05	309.89		Bent	No Flow	309.73	Too Deep/No Flow	Too Deep/Low flow	Flowing	309.07	168 L/s
Jul-05	3 309.83		313.41	Flowing	309.66	Dry	Dry	Flowing	NA	NA
Nov-05	309.83		313.51	Flowing	309.67	Dry	Dry	Flowing	NA	20 L/s
Apr-06	310.05		313.18	Flowing	309.70	Too Deep	Flowing	Flowing	309.03	66 L/s
Jul-06	3 310.62		313.48	Flowing	Too Deep	Too Deep	313.73	Flowing	NA	NA
Nov-06	309.98		313.19	Flowing	309.77	Too Deep/No Flow	Flowing	Flowing	309.05	51 L/s
Apr-07	310.00		Dry	Flowing	309.78	313.97	Too Deep/Flowing	Flowing	Dry	69.23 L/s
Nov-07	309.77		313.64	Flowing	Dry	Dry	Dry	Dry	Dry	9.01 L/s
Apr-08	309.98		313.70	Flowing	309.77	T-Bar Removed	Dry	NA	Dry	97.01 L/s
Aug-08	309.94		313.76	Flowing	309.74	Dry	Dry	Flowing	Dry	105.0 L/s
Nov-08	310.23		313.74	Flowing	309.97	Flowing	Flowing	Flowing	309.25	398.82 L/s
Apr-09	310.42		313.49	Flowing	309.85	Dry	Flowing	Flowing	309.15	324.72 L/s
Nov-09	NA		313.20	Flowing	309.36	Dry	Dry	Flowing	Dry	15.41 L/s
Mar-10	309.88		313.79	Flowing	309.69	Dry	Flowing	Flowing	Dry	49.34 L/s
Nov-10	NA		313.84	Flowing	309.78	Dry	Flowing	Flowing	309.255	310.50 L/s
Mar-11	310.39		313.73	Flowing	309.56	Dry	Dry	Flowing	308.88	528.48 L/s
Oct-11	310.08		313.83	Flowing	T-Bar Missing	Dry	Dry	Flowing	309.01	217.41 L/s
Dec-11	310.47		313.84	Flowing	T-Bar Missing	Dry	Dry	Flowing	Dry	639.20 L/s
Apr-12	310.35		313.73	Flowing	Dry	Dry	Dry	Flowing	Dry	48.0 L/s
Aug-12	310.08		313.83	Flowing	T-Bar Missing	Dry	Dry	Flowing	309.01	40.0 L/s
Nov-12	310.47		313.84	Flowing	T-Bar Missing	Dry	Dry	Flowing	Dry	11.12 L/s
May-13	310.83		313.82	Flowing	309.52	Ponded	Dry	Flowing	308.95	(6)
Oct-13	310.94		313.86	Flowing	NA	Ponded	Dry	Flowing	308.98	170.57 L/s
Jun-14	310.79		Trickle	Dry	309.43	Dry	Dry	Dry	308.95	3.13 L/s
Nov-14	310.83		313.87	Flowing	309.55	Ins	Dry	Flowing	309.07	13.61 L/s
May-15	310.80		Trickle	Dry	309.52	Ponded	Dry	Dry	308.91	1.49 L/s
Sep-15	310.75		Dry	Dry	Dry	Dry	Dry	Dry	Dry	Dry
Mar-16	310.93	167.27 L/s			309.76				309.05	170.55 L/s

Notes:

Reference elevation refers to top of staff gauge (T-bar) elevation based on most recent survey information of top of staff gauge.

- * SP1-10 replaced SP1-93 after the Town took ownership of the Site property in 2009
- ** Reference elevation - top of culvert - Surveyed October 12, 2006 used for SP1B as of July 2005.
- (1) T-bar removed during reconstruction of Retention Pond. (4) Rectangular channel cross section assumed
- (2) Water levels are not recorded. Dry or flowing conditions are noted. (5) T-Bar elevation not consistent with historical information; Resurveyed in 2009
- (3) Water levels recorded after rainfall event. (6) Flow meter did not work properly
- Ins Insufficient water to obtain a sample Dry Dry at T-bar
- NA T-bar not accessible (area flooded, bent or missing T-bar, overgrowth of weeds)

Table F1.4
Phase I Leachate Elevations
St. Marys Landfill

Manhole ID	MH-1	MH-2	MH-3	MH-4	MH-5	MH-6	MH-7	MH-8	MH-16A	MH-15A
Invert Elev.	314.199	314.928	316.04	316.767	316.366	315.966	315.532	315.147	313.91	313.536
Reference Elev.	320.47	319.88	319.08	319.91	319.49	319.31	319.36	319.55	319.02	316.65
May-89	318.57	317.53	317.57	319.50	319.21	318.91	319.25	319.21		
Aug-89	318.69	319.60	317.68	317.78	317.80	Buried	317.50	317.67		
Nov-89	318.70	317.91	317.75	318.00	317.81	317.87	317.64	317.87		
Feb-90	--	--	--	--	--	--	--	--		
Apr-90	317.50	--	317.85	318.15	--	--	--	--		
May-90	317.07	317.02	317.07	317.17	317.16	317.97	317.94	Buried		
May-90	316.86	318.14	316.20	318.73	318.26	319.25	318.07	317.85		
Aug-90	317.11	318.06	316.44	A	317.63	Buried	319.11	317.74		
Nov-90	315.06	Dry	Dry	Flooded	316.06	Buried	Flooded	Dry		
Feb-91	316.70	316.70	316.68	316.72	316.70	Buried	Buried	316.64		
May-91	316.08	316.21	316.18	316.71	316.56	Buried	317.87	316.22		
Aug-91	314.65	Dry	Dry	Dry	Dry	Dry	Dry	Dry		
Nov-91	314.62	Dry	Dry	Dry	Dry	Dry	Dry	Dry		
Feb-92	--	--	--	--	--	--	--	--		
May-92	314.88	315.37	Dry	Dry	Dry	Dry	*	*		
Aug-92	316.36	*	*	Dry	Dry	Dry	Dry	315.53		
Nov-92	316.44	316.45	316.43	Dry	316.44	316.44	316.43	316.44		
Feb-93	315.68	315.68	Dry	Dry	Dry	Dry	315.65	315.66		
May-93	316.79	316.78	316.81	316.8	316.8	316.81	316.79	316.8		
Aug-93	316.42	316.42	316.41	Dry	316.41	316.43	316.4	316.42		
Apr-94	316.52	316.54	316.51	Dry	316.52	316.53	316.52	316.53		
Sep-94	314.90	315.13	Dry	Dry	Dry	315.73	315.49	315.05		
Apr-95	316.35	316.36	316.35	Dry	316.35	316.36	316.34	316.35		
Nov-95	316.20	316.21	316.2	Dry	Dry	316.21	316.19	316.19		
Apr-96	316.61	316.67	316.67	Dry	316.67	316.68	316.66	316.66		
Sep-96	315.99	316.00	Dry	Dry	Dry	316	315.98	315.98		
Apr-97	316.93	316.93	316.93	316.91	317.12	316.94	316.92	316.93		
Sep-97	315.14	Dry	Dry	Dry	Dry	Dry	Dry	Dry		
Apr-98	314.27	315.14	Dry	Dry	Dry	315.83	315.5	315.08		
Sep-98	314.26	315.14	Dry	Dry	Dry	315.83	315.5	315.08		
Apr-99	314.26	315.12	Dry	Dry	316.12	315.83	315.5	315.08		
Sep-99	Wet	Wet	Dry	Dry	Wet	Wet	Wet	Wet		
Apr-00	Flowing	Flowing	Dry	Dry	Wet	Flowing	315.53	Flowing		
Sep-00	Flowing	Wet	Dry	Dry	Dry	Wet	315.53	Wet		
Apr-01	Flowing	Flowing	Dry	Dry	Wet	Flowing	315.55	Flowing		
Sep-01	Wet	Dry	Dry	Dry	Dry	Dry	Dry	Dry		
Apr-02	Flowing	Flowing	Dry	Dry	Flowing	Flowing	Flowing	Flowing		
Sep-02	--	Wet	Dry	Dry	Dry	Wet	315.55	Wet		
Apr-03	314.63	Flowing	Wet	Dry	Flowing	Flowing	Flowing	Flowing		
Sep-03	Dry	Dry	Dry	Dry	Dry	Dry	Wet	Flowing		
May-04	315.89	315.96	Wet/No Flow	Dry	Wet/Flowing	315.98	315.93	315.96	Flowing	Flowing
Sep-04	Wet/Flowing	Dry	Dry	Dry	Dry	Dry	Wet/No Flow	Wet/No Flow	--	Wet/Flowing
Apr-05	315.89	315.93	Wet/No Flow	Dry	Wet/Flowing	316.11	315.90	315.90	Wet/Flowing	Wet/Flowing
Nov-05	314.58	Wet/Flowing	Dry	Dry	Dry	Wet/Flowing	Wet/Flowing	Wet/Flowing	Flowing	Flowing
Apr-06	315.62	315.65	Wet	Dry	Wet	Flowing	315.63	315.63	Flowing	Flowing
Nov-06	315.76	315.78	Wet/No Flow	Dry	Wet/No Flow	Wet/Flowing	315.77	315.77	Flowing	Flowing
Apr-07	Wet/Flowing	Wet/Flowing	Dry	Dry	Wet/No Flow	Wet/No Flow	Wet/No Flow	Wet/Flowing	--	--
Nov-07	Wet/Flowing	Wet/Flowing	Dry	Dry	Dry	Wet/Flowing	Wet/No Flow	Wet/No Flow	Wet/Flowing	Wet/Flowing
Apr-08	Wet/Flowing	Wet/Flowing	Wet/Flowing	Dry	Wet/No Flow	Wet/No Flow	Wet/No Flow	Wet/Flowing	Wet/Flowing	Wet/Flowing
Nov-08	Wet/Flowing	Wet/Flowing	Wet/Flowing	Dry	Flowing	Flowing	Flowing	Wet/Flowing	Wet/Flowing	Wet/Flowing
Apr-09	Dry	Dry	Flowing	Dry	Flowing	Flowing	Flowing	Flowing	Flowing	Flowing
Nov-09	Wet/Flowing	Wet	Dry	Dry	Wet	Wet	Wet	Wet	Flowing	Flowing
Mar-10	Flowing	Flowing	Wet	Dry	Wet	Flowing	Wet	Wet	Flowing	Flowing
Nov-10	Flowing	Flowing	Dry	Dry	Flowing	Flowing	Flowing	Flowing	Flowing	Flowing
Mar-11	Flowing	Flowing	Wet	Dry	Flowing	Flowing	Flowing	Flowing	Flowing	Flowing
Dec-11	Flowing	Flowing	Wet	Dry	Flowing	Flowing	Flowing	Flowing	Flowing	Flowing
Apr-12	Flowing	Wet	Dry	Dry	Wet	Wet	Wet	Wet	Flowing	Flowing
Nov-12	Flowing	Flowing	Dry	Dry	Wet	Wet	Wet	Flowing	Flowing	Flowing
May-13	Flowing	Flowing	316.09	Dry	Flowing	Flowing	Flowing	Flowing	Flowing	Flowing
Oct-13	Flowing	Flowing	317.43	Dry	316.45	Flowing	Flowing	Flowing	Flowing	Flowing
Jun-14	Flowing	Wet	317.42	Dry	Wet	Wet	Wet	Wet	Flowing	Flowing
Nov-14	Very Slow Flow	Very Slow Flow	317.42	Dry	Wet/No Flow	Wet/No Flow	Wet/No Flow	Very Slow Flow	Flowing	Very Slow Flow
May-15	Very Slow Flow	Very Slow Flow	317.52	Dry	Pond/No Flow	Pond/No Flow	Pond/No Flow	Pond/No Flow	Flowing	Very Slow Flow
Sep-15	Very Slow Flow	Pond/No Flow	317.42	Dry	Dry	Pond/No Flow	Pond/No Flow	Pond/No Flow	Slow Flow	Flowing

Notes:

All elevations in metres above mean sea level (m AMSL).
Reference elevation is elevation of top of steel frame and grate.
* Data obtained during monitoring is not consistent with other data.
Buried - MH covered by waste or interim cover material


-- No Data
A - Leachate running into manhole.
(1) - Leachate pumped from holding tank prior to measuring levels.
Wet - bottom of MH wet, but no leachate accumulation
Flowing - indicates leachate moving through the bottom of the MH

Table F1.5
Phase II/III Leachate Elevations
St. Marys Landfill


Manhole ID	MH1	MH2	MH3	MH4	MH5	MH6 ²	MH7	MH8	MH9	MH10	MH11	MH12	MH13	MH14	MH15	MH16	MH17	MH18	MH19	MH20	MHA	MHB			
Invert Elev.	313.25	312.81	312.12			314.79	315.07	315.42	315.81	316.13	317.60	317.45	317.13	316.79	316.28			313.93	314.397	314.871	311.76	310.79			
Reference Elev. ¹	317.24	318.27	318.26	319.31		318.13								321.82	321.75	319.77	319.13	319.11	318.57	318.13	318.33	315.72			
May-93	NA	NA	NA																						
Aug-93	NA	NA	NA																						
Apr-94	NA	NA	NA																						
Sep-94	Dry	Dry	312.73																						
Apr-95	Dry	312.84	312.84																Dry	Dry					
Sep-95	Dry	Dry	312.55																Dry	Dry					
Apr-96	Dry	313.24	313.26																Dry	Dry					
Sep-96	Dry	313.3	313.3																Dry	Dry					
Apr-97	Dry	Dry	312.64																Dry	Dry					
Sep-97	Dry	313.06	313.06																Dry	314.28					
Apr-98	Dry	Dry	312.14																Dry	314.36					
Sep-98	Dry	Dry	312.15																Dry	Dry					
Apr-99	312.27	312.83	312.14																Dry	Dry					
Sep-99	Dry	Flowing	Flowing																Dry	No Flow					
Apr-00	Wet	Flowing	Flowing																Wet	Dry					
Sep-00	Dry	Wet	312.49																Dry	Wet					
Apr-01	Wet	Flowing	Flowing																Dry	Wet					
Sep-01	Dry	Dry	312.69																Dry	Dry					
Apr-02	Flowing	Flowing	312.29																Flowing	Flowing					
Sep-02	Dry	313.2	310.88																Wet	Dry	Dry				
Apr-03	Flowing	Flowing	Flowing																Flowing	Flowing	Wet				
Sep-03	Dry	Dry	Dry																Dry	Dry	Dry				
May-04	Wet/Flowing	Wet/Slight Flow	Wet/Slight Flow	Wet/Flowing															Dry	Wet/Flowing	Wet/Flowing	Wet/Flowing	Overflowing		
Sep-04	Dry	Dry	308.25	Wet/Slight Flow															Dry	Dry	314.85	Dry	Top Flowing		
Apr-05	Wet/No Flow	Wet/No Flow	Wet/Flowing	Flowing	Flowing														Wet/No Flow	Wet/No Flow	Wet/No Flow	Dry	315.34	Overflowing	
Nov-05	Dry	Wet/No flow	Flowing	Wet/Flowing	Wet/Flowing	Wet/Flowing													Wet/Flowing	Wet	Flowing	314.74	Dry	315.33	Top Flowing
Apr-06	Wet	Wet	Flowing	Flowing	Flowing	Wet													Wet	Wet	Flowing	315.00	Dry	315.32	Top Flowing
Nov-06	Wet/No Flow	Wet/No Flow	Flowing	Flowing	Wet/Flowing	Wet/Flowing													Wet/Flowing	Wet/No Flow	Wet/Flowing	315.23	Dry	315.32	Top Flowing
Apr-07	Wet/No Flow	Wet/No Flow	Flowing	Wet/Flowing	Wet/Flowing	Wet/Flowing													Wet/Flowing	Dry	Wet/Flowing	315.19	Dry	315.32	Top Flowing
Nov-07	Dry	Dry	Wet/Flowing	Wet/No Flow	Wet/No Flow	Wet/Flowing	NA							NA					Wet/No Flow	Wet/No Flow	Wet/No Flow	314.91	Dry	315.12	315.12
Apr-08	Wet/No Flow	Wet/No Flow	312.59	Wet/No Flow	Wet/Flowing	Wet/Flowing	NA							NA	NA	NA			Wet/Flowing	Wet/No Flow	Wet/Flowing	Dry	315.35	315.37	
Nov-08	Dry	Dry	Flowing	Flowing	Flowing	Flowing	NA							NA	Wet/Flowing	Wet/Flowing	Wet/Flowing	Wet/Flowing	Wet/Flowing	315.38	Wet	315.14	Top Flowing		
Apr-09	Dry	Dry	Flowing	Flowing	Flowing	Flowing	NA							NA	Flowing	Flowing	Wet	Flowing	Flowing	315.05	Flowing	315.14	Top Flowing		
Nov-09	Wet	Wet	Flowing	Flowing	Wet	Wet	315.11							NA	Wet	Dry	Wet	Wet	Wet	314.85	Wet	315.29	315.34		
Mar-10 ³	NA	NA	NA	NA	NA	NA	NA							NA	NA	NA	NA	NA	NA	NA	NA	NA	NA	Top Flowing	
Nov-10	Wet	Flowing	Flowing	Flowing	Flowing	Flowing	NA	NA					NA	NA	Flowing	Flowing	Flowing	Flowing	Flowing	314.87	Wet	315.11	Top Flowing		
Mar-11	Wet	Flowing	Flowing	Flowing	313.38	Flowing	NA	NA					NA	NA	Flowing	Flowing	Wet	Flowing	Flowing	315.04	Dry	315.13	Top Flowing		
Dec-11	Wet	Flowing	Flowing	Flowing	Flowing	Flowing	Flowing	NA					NA	NA	Flowing	Flowing	Flowing	Flowing	Flowing	315.27	Wet	315.08	Top Flowing		
Apr-12	Dry	Flowing	Flowing	312.84	Flowing	Flowing	Flowing	NA					Dry	Wet	Flowing	Flowing	Wet	Flowing	Flowing	314.95	Dry	315.12	Top Flowing		
Nov-12	Wet	Wet	Flowing	Flowing	Wet	Flowing	Wet	NA					Wet	Wet	Wet	Wet	Wet	Wet	Wet	314.96	Wet	315.12	Top Flowing		
May-13	Dry	Flowing	Flowing	Dry	Flowing	Flowing	315.23	NA						Flowing	316.66	Flowing	Flowing	Flowing	Flowing	Flowing	315.11	Dry	315.11	Top Flowing	
Oct-13	Dry	Dry	Flowing	313.75	Flowing	Flowing	315.24	Flowing						Flowing	316.65	Flowing	Flowing	Flowing	Flowing	Flowing	315.29	Dry	315.09	Top Flowing	
Jun-14	Wet	Wet	Trickle	314.48	314.52	Flowing	315.16	Wet						Trickle	316.65	Trickle	Wet	Wet	Trickle	315.05	314.9	315.12	315.36		
Nov-14	Dry	Dry	Trickle	NA	314.52	Flowing	315.22	Trickle						Trickle	316.66	Wet/No Flow	Wet/No Flow	Dry	Wet/No Flow	315.08	Dry	315.14	315.37		
May-15	Pond/No Flow	Pond/No Flow	Trickle	NA	314.55	Flowing	315.23	Trickle	NA	Trickle	Dry	Trickle	Pond/No Flow	316.65	Pond/No Flow	Trickle	Pond/No Flow	Trickle	Trickle	314.77	Dry	315.11	315.35		
Sep-15	Dry	Dry	Trickle	NA	314.43	Trickle	315.29	NA	NA	NA	Wet	Dry	Dry	316.57	Dry	Dry	Dry	Pond/No Flow	314.82	Pond/No Flow	315.13	315.36			

Notes:

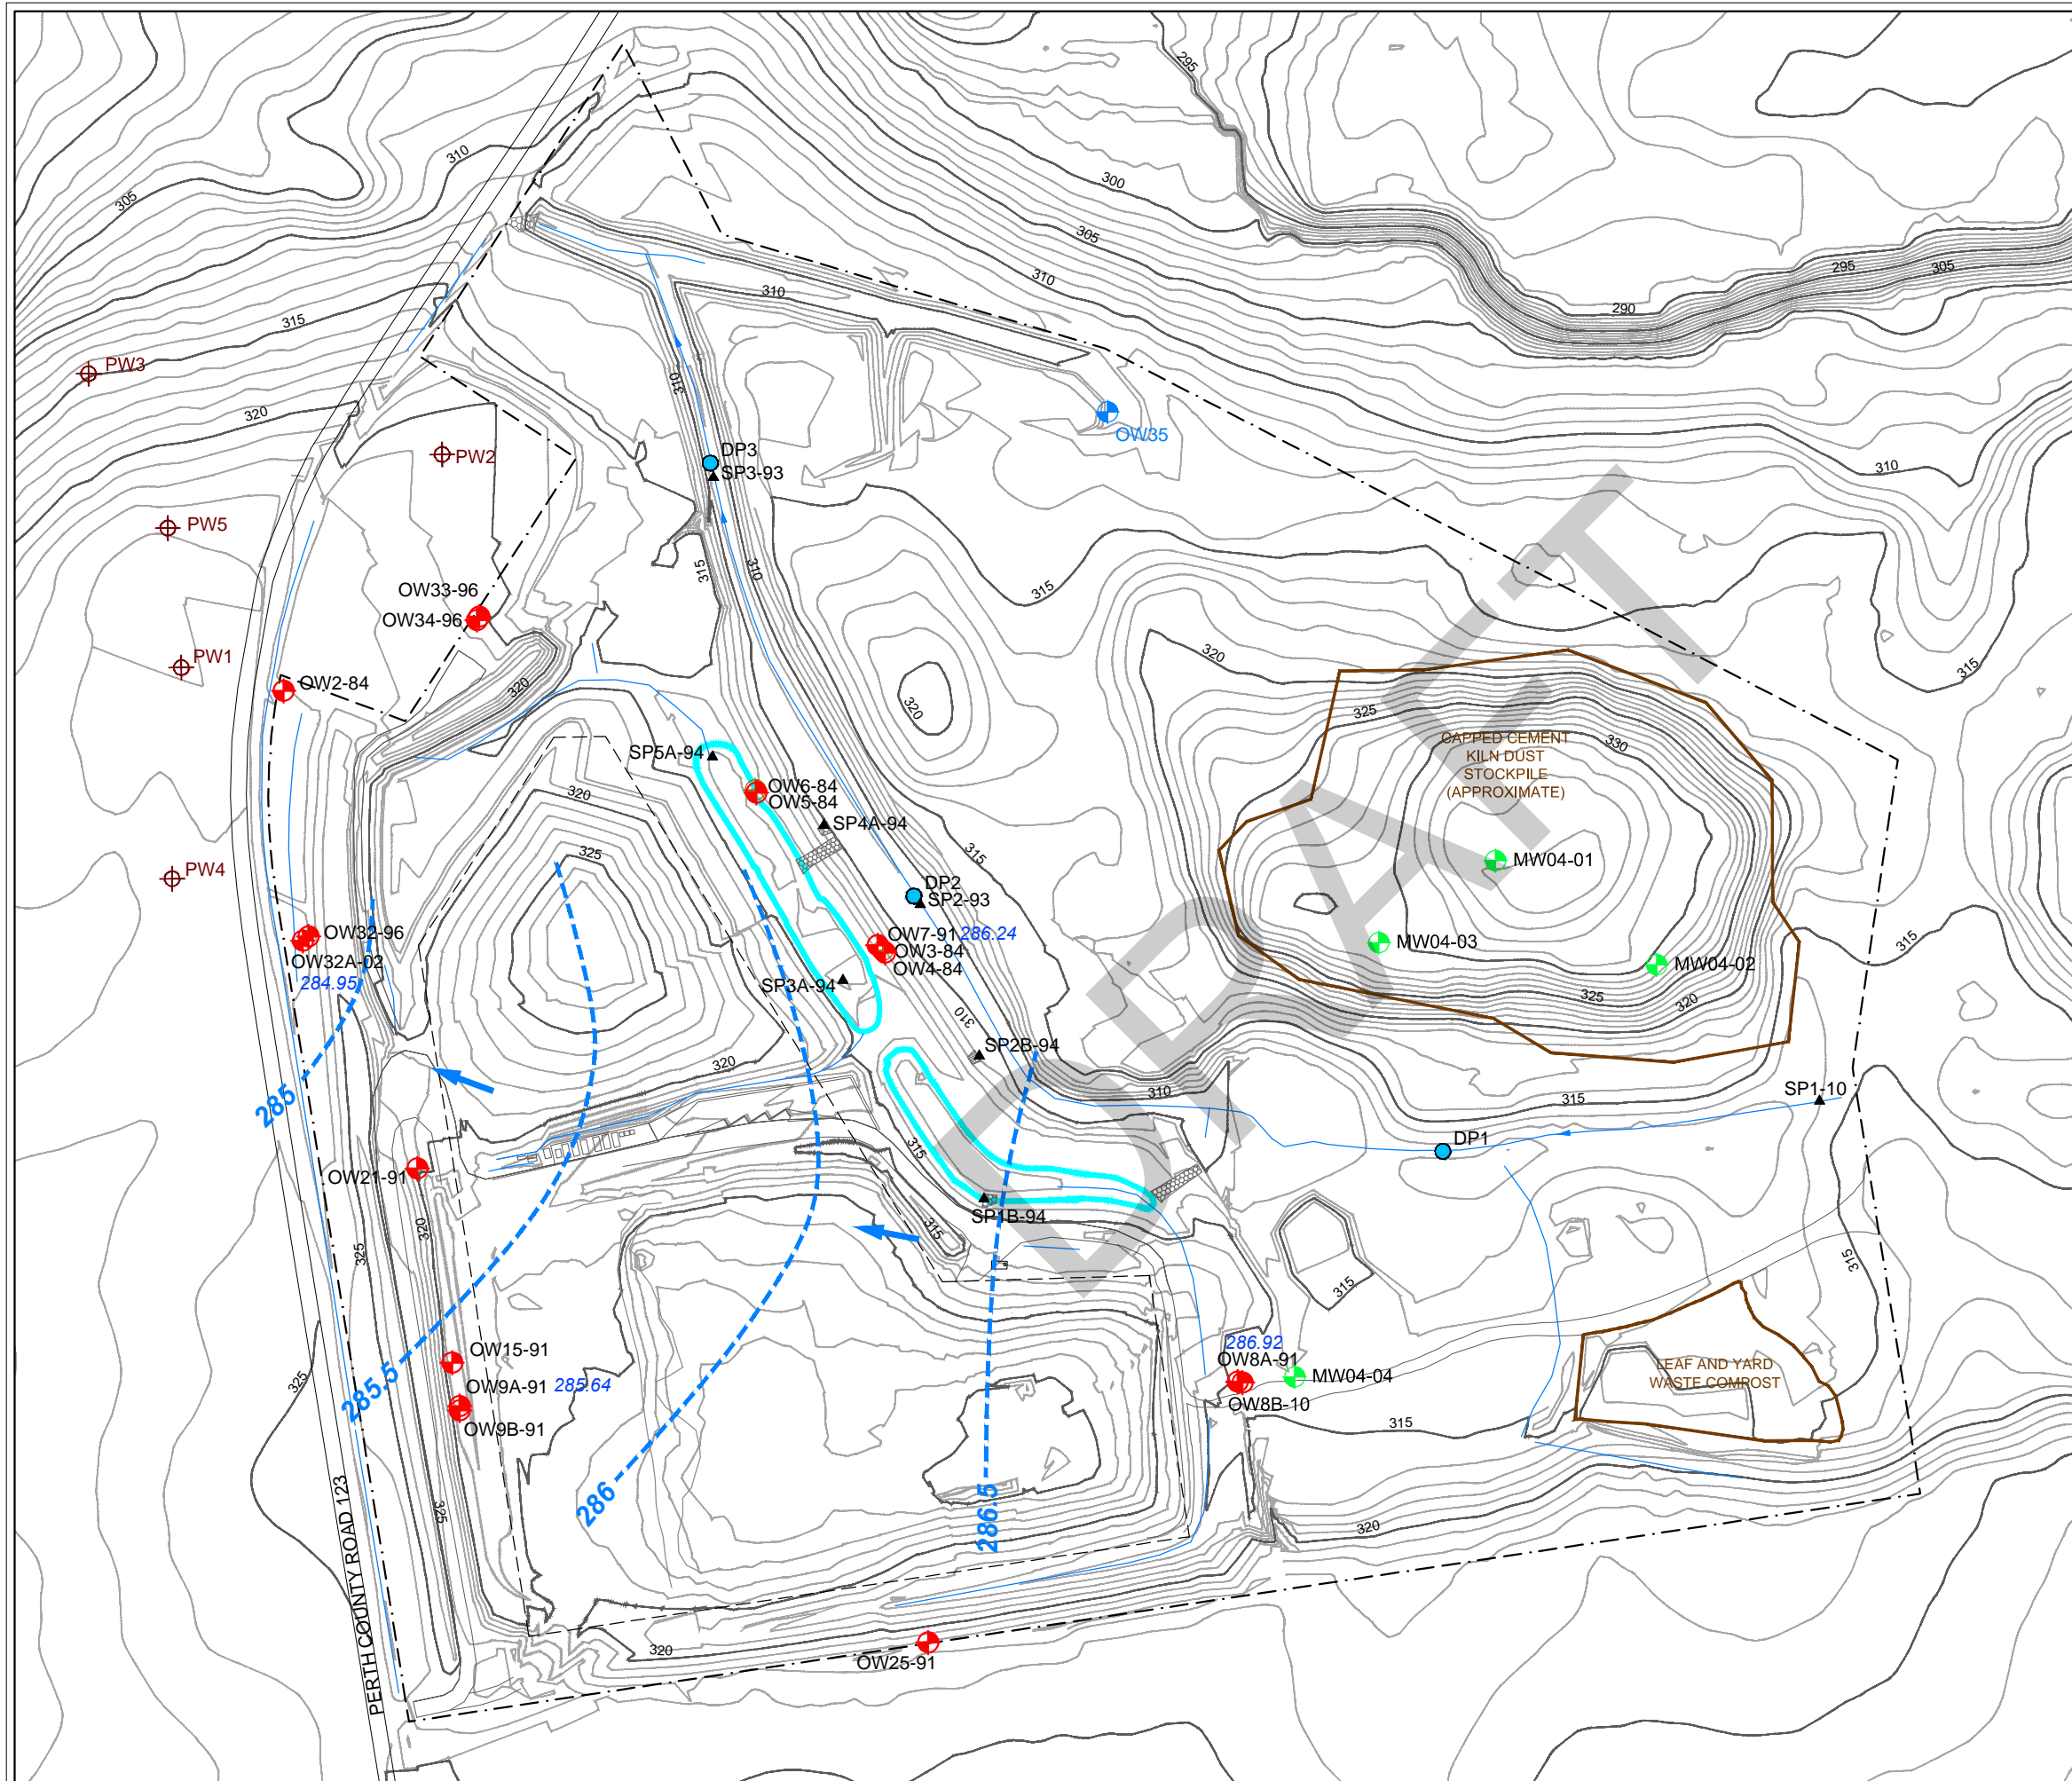- All elevations in metres above mean sea level (m amsl).
- Reference elevation of manholes is elevation of top of steel frame and grate.
- 1. Reference elevations resurveyed November 23, 2009
- 2. 1.46 m spacer added to MH 6 in 2008 to bring MH cover elevation above grade.
- 3. Phase II/III Manholes were not inspected during the March 2010 event due to the disposal of ACM at the site on the day of the inspection.
- NA - not accessible
- Wet - bottom of MH wet, but no leachate accumulation
- Flowing - indicates leachate moving through the bottom of the MH
- Overflowing - indicates that groundwater was flowing out the top of the MH cover.
- Top Flowing - indicates that groundwater was flowing out of the manhole riser.
- Invert elevations MH8 to MH13 from 2013 Cell 8 Construction documents




- LEGEND**
- PROPERTY BOUNDARY
 - - - LIMIT OF REFUSE DISPOSAL
 - WATERCOURSE
 - STORM WATER MANAGEMENT BASIN
 - OBSERVATION WELL
 - ▲ SURFACE WATER MONITORING LOCATION
 - ⊕ PRIVATE DOMESTIC WELL (APPROXIMATE LOCATION)
 - MONITORING WELL (NOT SAMPLED)
 - MONITORING WELL (REMOVED FROM MONITORING PROGRAM)
 - MONITORING WELL (SOURCE UNKNOWN)
 - DRIVE POINT PIEZOMETER
 - INTERPRETED GROUNDWATER CONTOUR (masl)
 - 287.90 MEASURED WATER LEVEL (MAY, 2015)
 - ← INTERPRETED GROUNDWATER FLOW DIRECTION

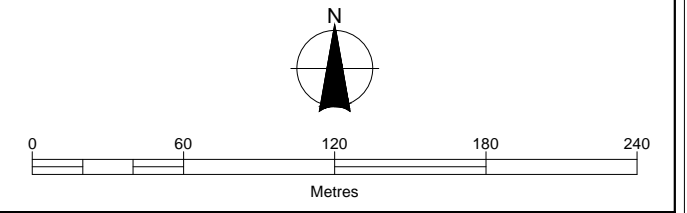


Client / Report **TOWN OF ST. MARYS
ENVIRONMENTAL ASSESSMENT
HYDROGEOLOGICAL STUDY**

Figure Title **GROUNDWATER FLOW IN BEDROCK
(MAY, 2015)**

Drawn SK	Checked CM	Date March 2016	Figure No.
Scale 1:3,000	Project No. 300032339		F2.1

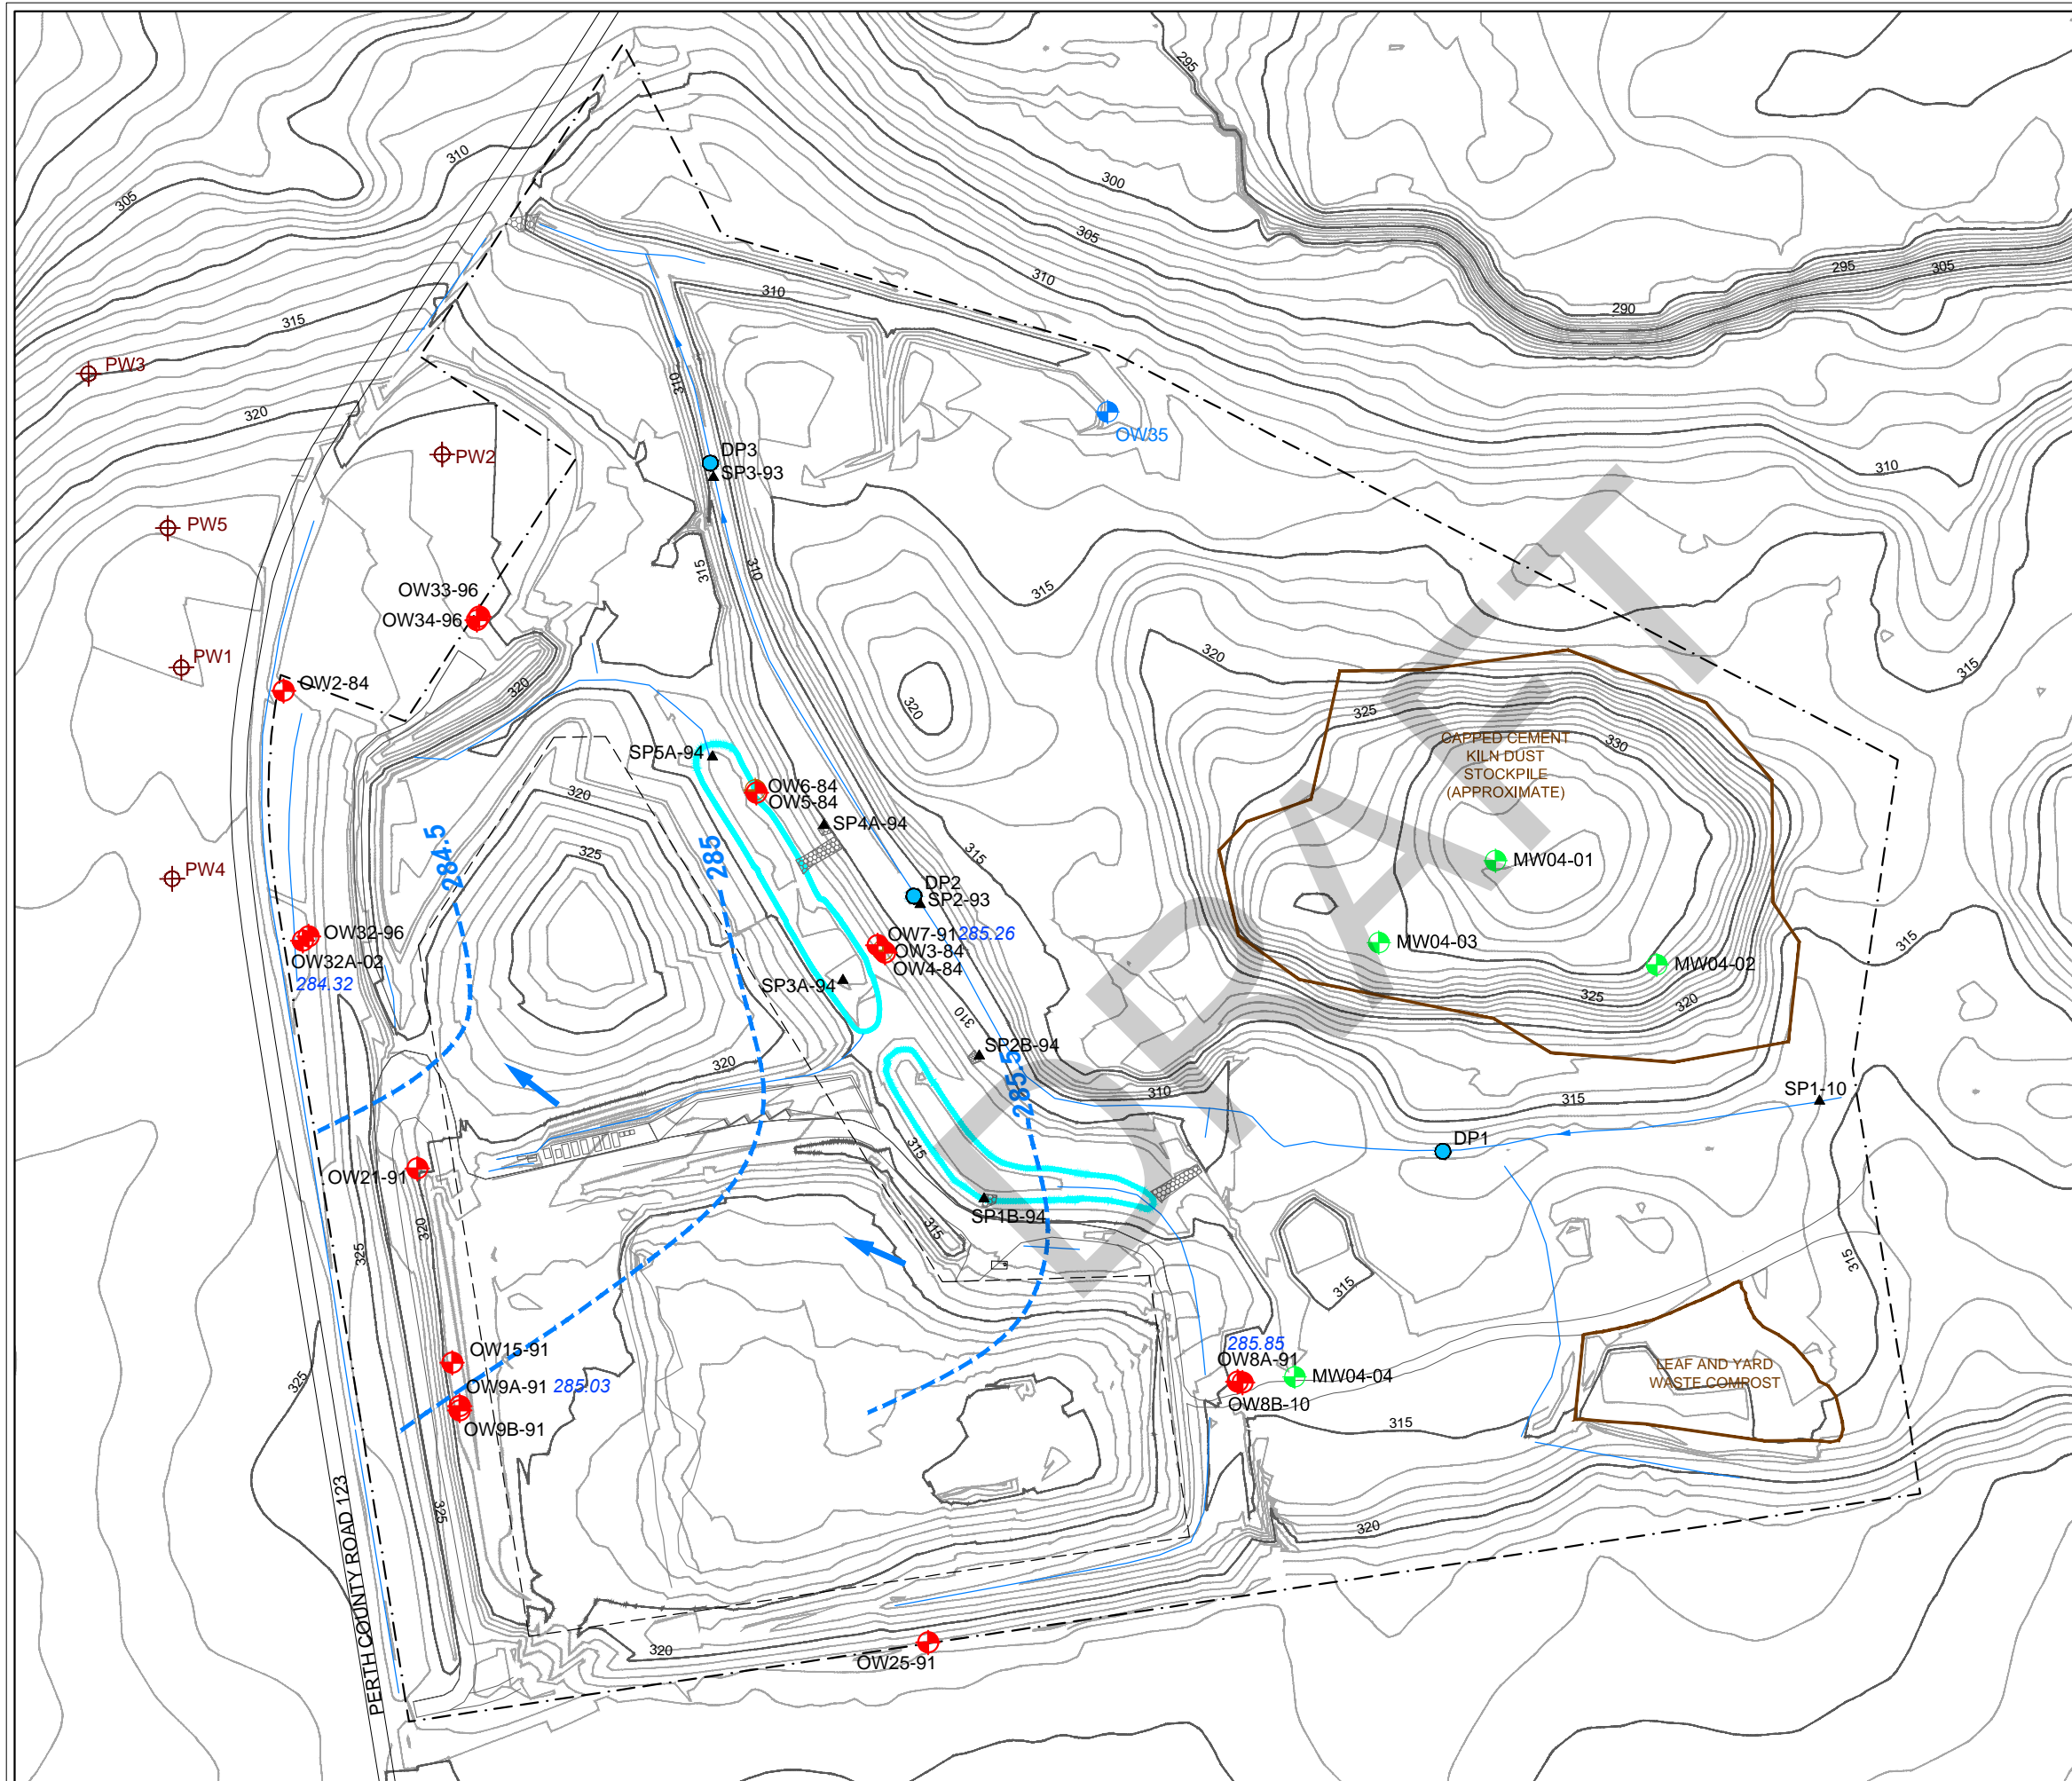

- LEGEND**
- PROPERTY BOUNDARY
 - - - LIMIT OF REFUSE DISPOSAL
 - WATERCOURSE
 - STORM WATER MANAGEMENT BASIN
 - OBSERVATION WELL
 - ▲ SURFACE WATER MONITORING LOCATION
 - ⊕ PRIVATE DOMESTIC WELL (APPROXIMATE LOCATION)
 - ⊕ MONITORING WELL (NOT SAMPLED)
 - ⊕ MONITORING WELL (REMOVED FROM MONITORING PROGRAM)
 - ⊕ MONITORING WELL (SOURCE UNKNOWN)
 - DRIVE POINT PIEZOMETER
 - INTERPRETED GROUNDWATER CONTOUR (masl)
 - 287.90 MEASURED WATER LEVEL (SEPTEMBER, 2015)
 - ← INTERPRETED GROUNDWATER FLOW DIRECTION

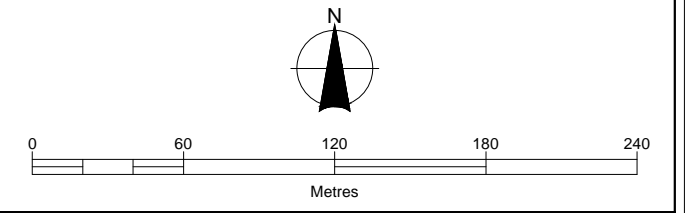


Client / Report

**TOWN OF ST. MARYS
ENVIRONMENTAL ASSESSMENT
HYDROGEOLOGICAL STUDY**


Figure Title

**GROUNDWATER FLOW IN BEDROCK
(SEPTEMBER, 2015)**

Drawn SK	Checked CM	Date March 2016	Figure No.
Scale 1:3,000	Project No. 300032339		F2.2

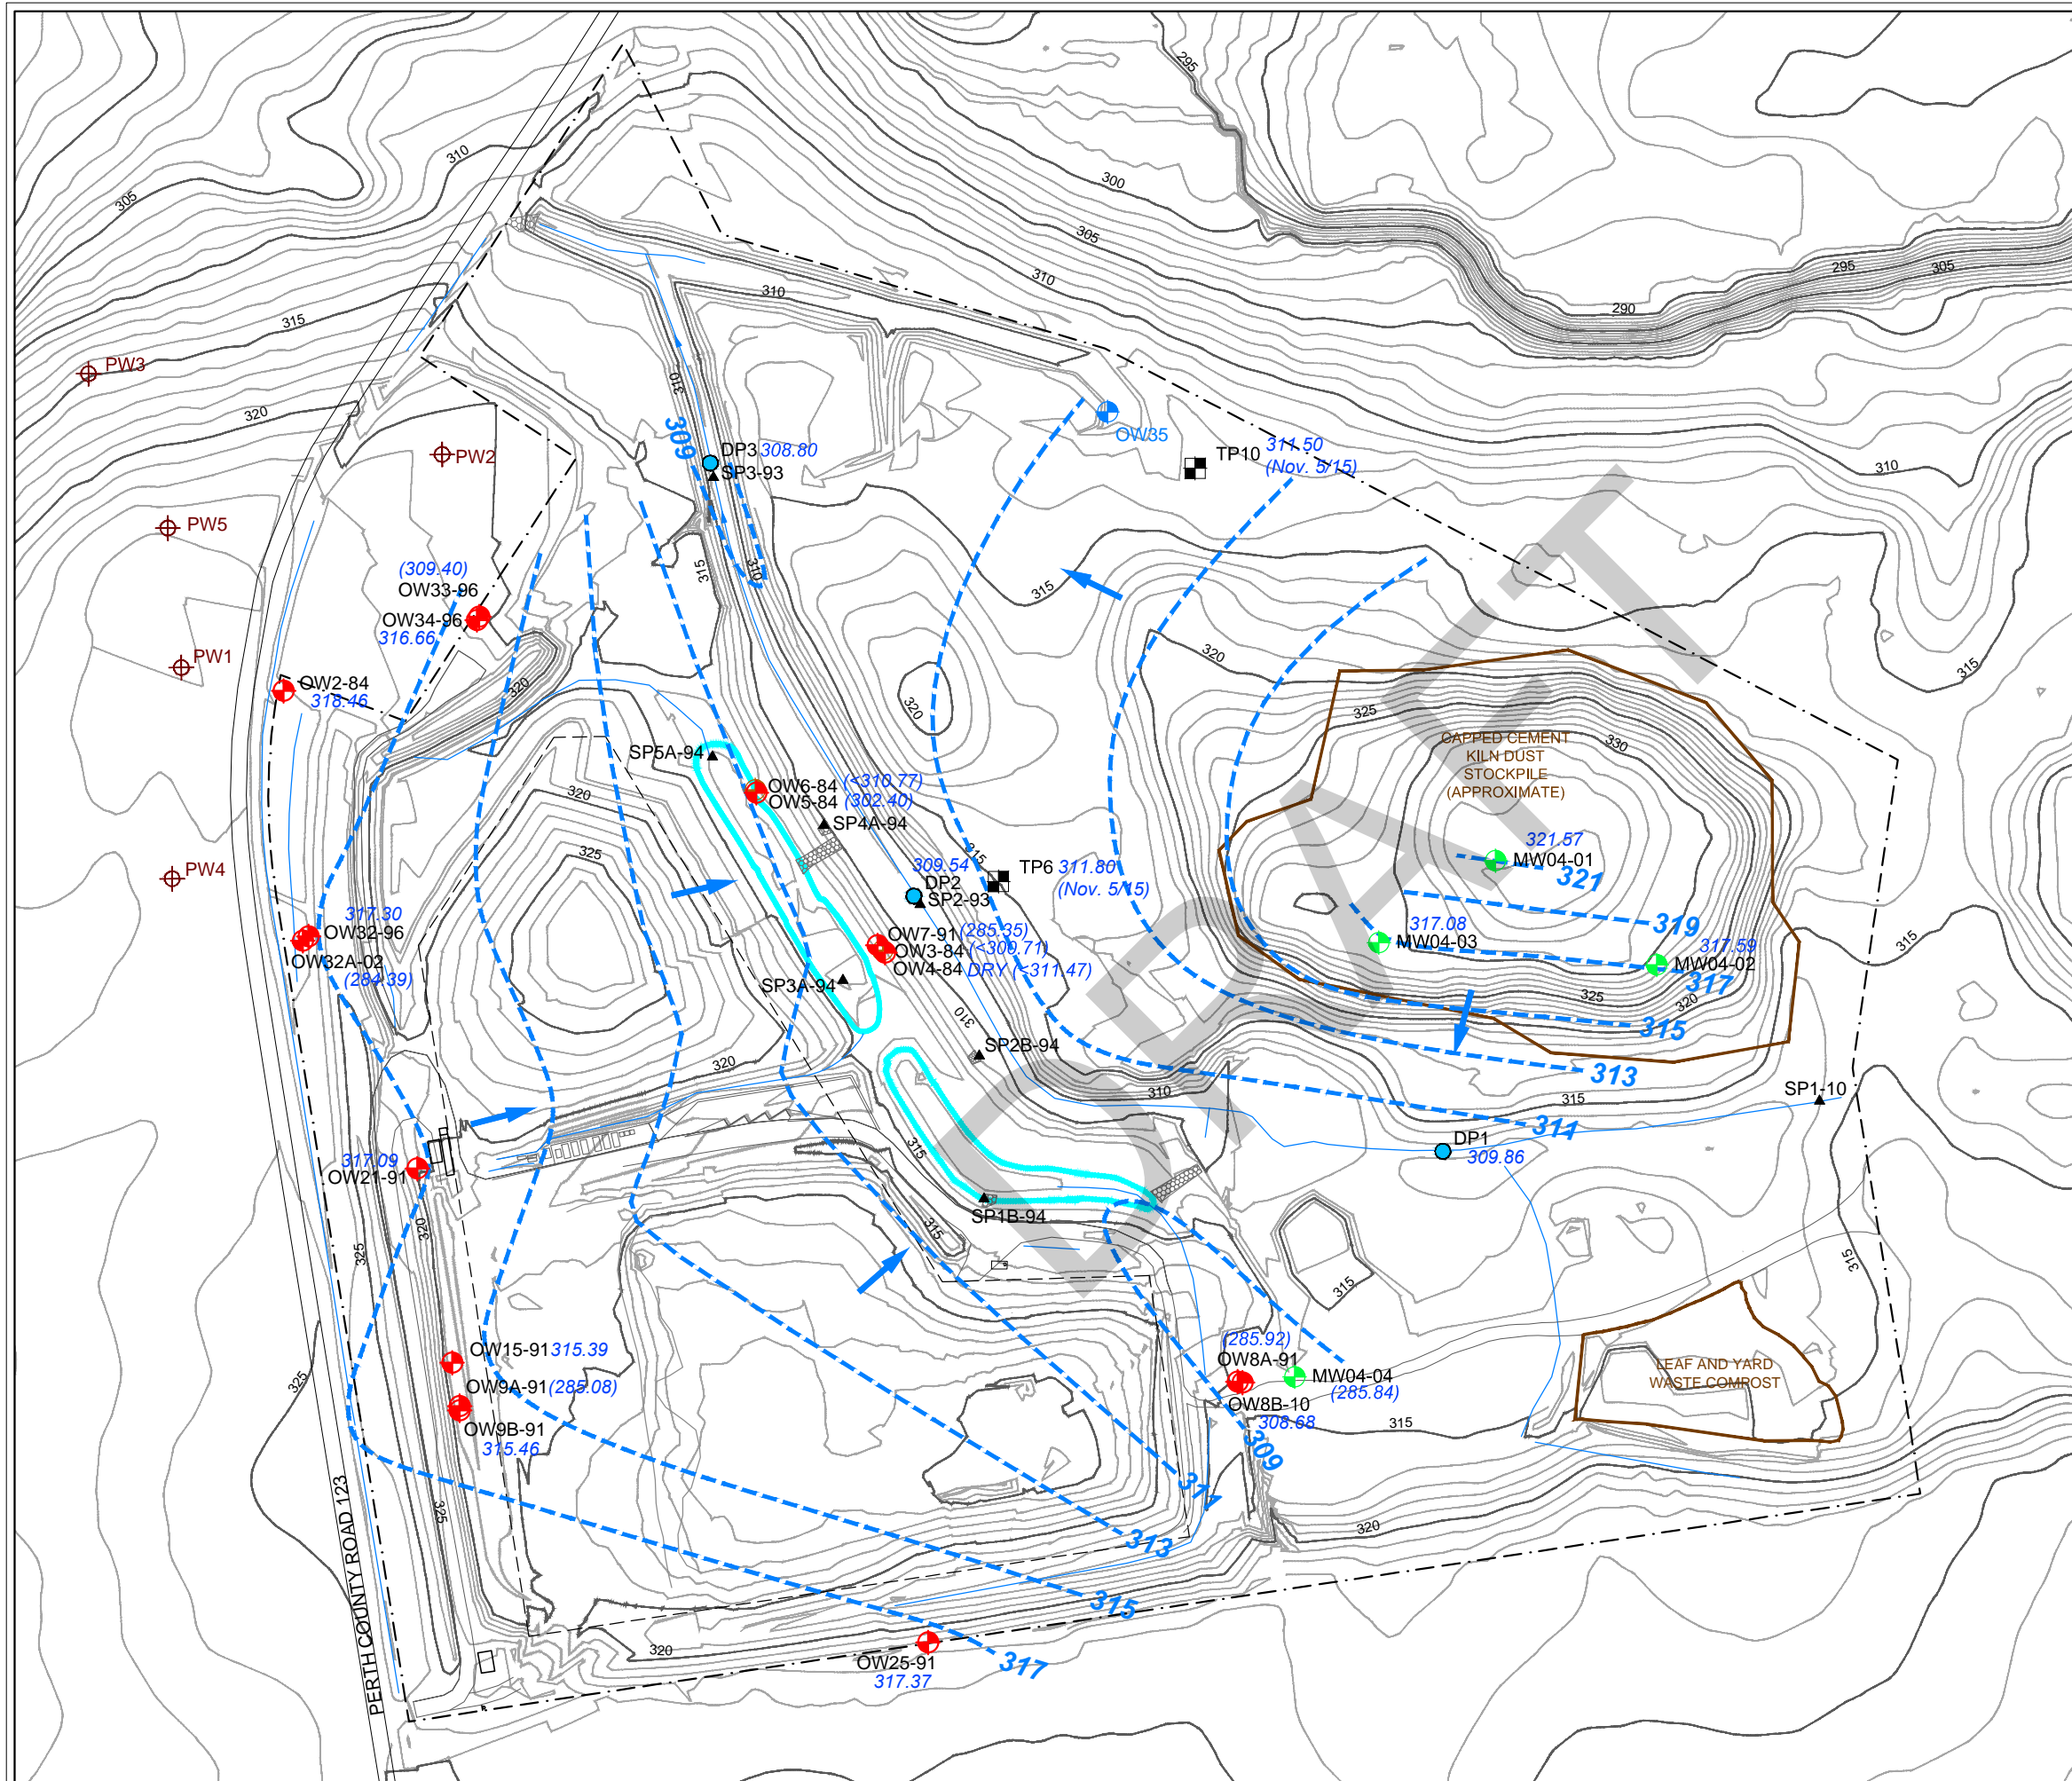

- LEGEND**
- PROPERTY BOUNDARY
 - - - LIMIT OF REFUSE DISPOSAL
 - WATERCOURSE
 - STORM WATER MANAGEMENT BASIN
 - ◆ OBSERVATION WELL
 - ▲ SURFACE WATER MONITORING LOCATION
 - ⊕ PRIVATE DOMESTIC WELL (APPROXIMATE LOCATION)
 - MONITORING WELL (NOT SAMPLED)
 - MONITORING WELL (REMOVED FROM MONITORING PROGRAM)
 - MONITORING WELL (SOURCE UNKNOWN)
 - DRIVE POINT PIEZOMETER
 - INTERPRETED GROUNDWATER CONTOUR (masl)
 - 287.90 MEASURED WATER LEVEL (DECEMBER, 2015)
 - (309.40) MEASURED WATER LEVEL (DECEMBER, 2015) NOT USED FOR INTERPRETING GROUNDWATER CONTOURS
 - ← INTERPRETED GROUNDWATER FLOW DIRECTION

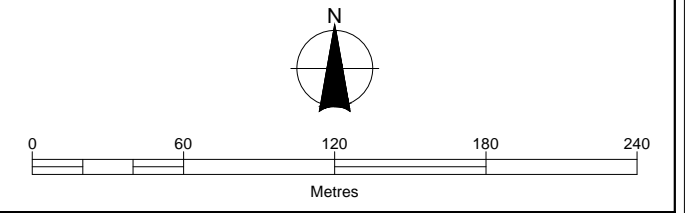


Client / Report
TOWN OF ST. MARYS
 ENVIRONMENTAL ASSESSMENT
 HYDROGEOLOGICAL STUDY

Figure Title
GROUNDWATER FLOW IN OVERBURDEN
(DECEMBER, 2015)

Drawn SK	Checked CM	Date March 2016	Figure No. F2.3
Scale 1:3,000		Project No. 300032339	

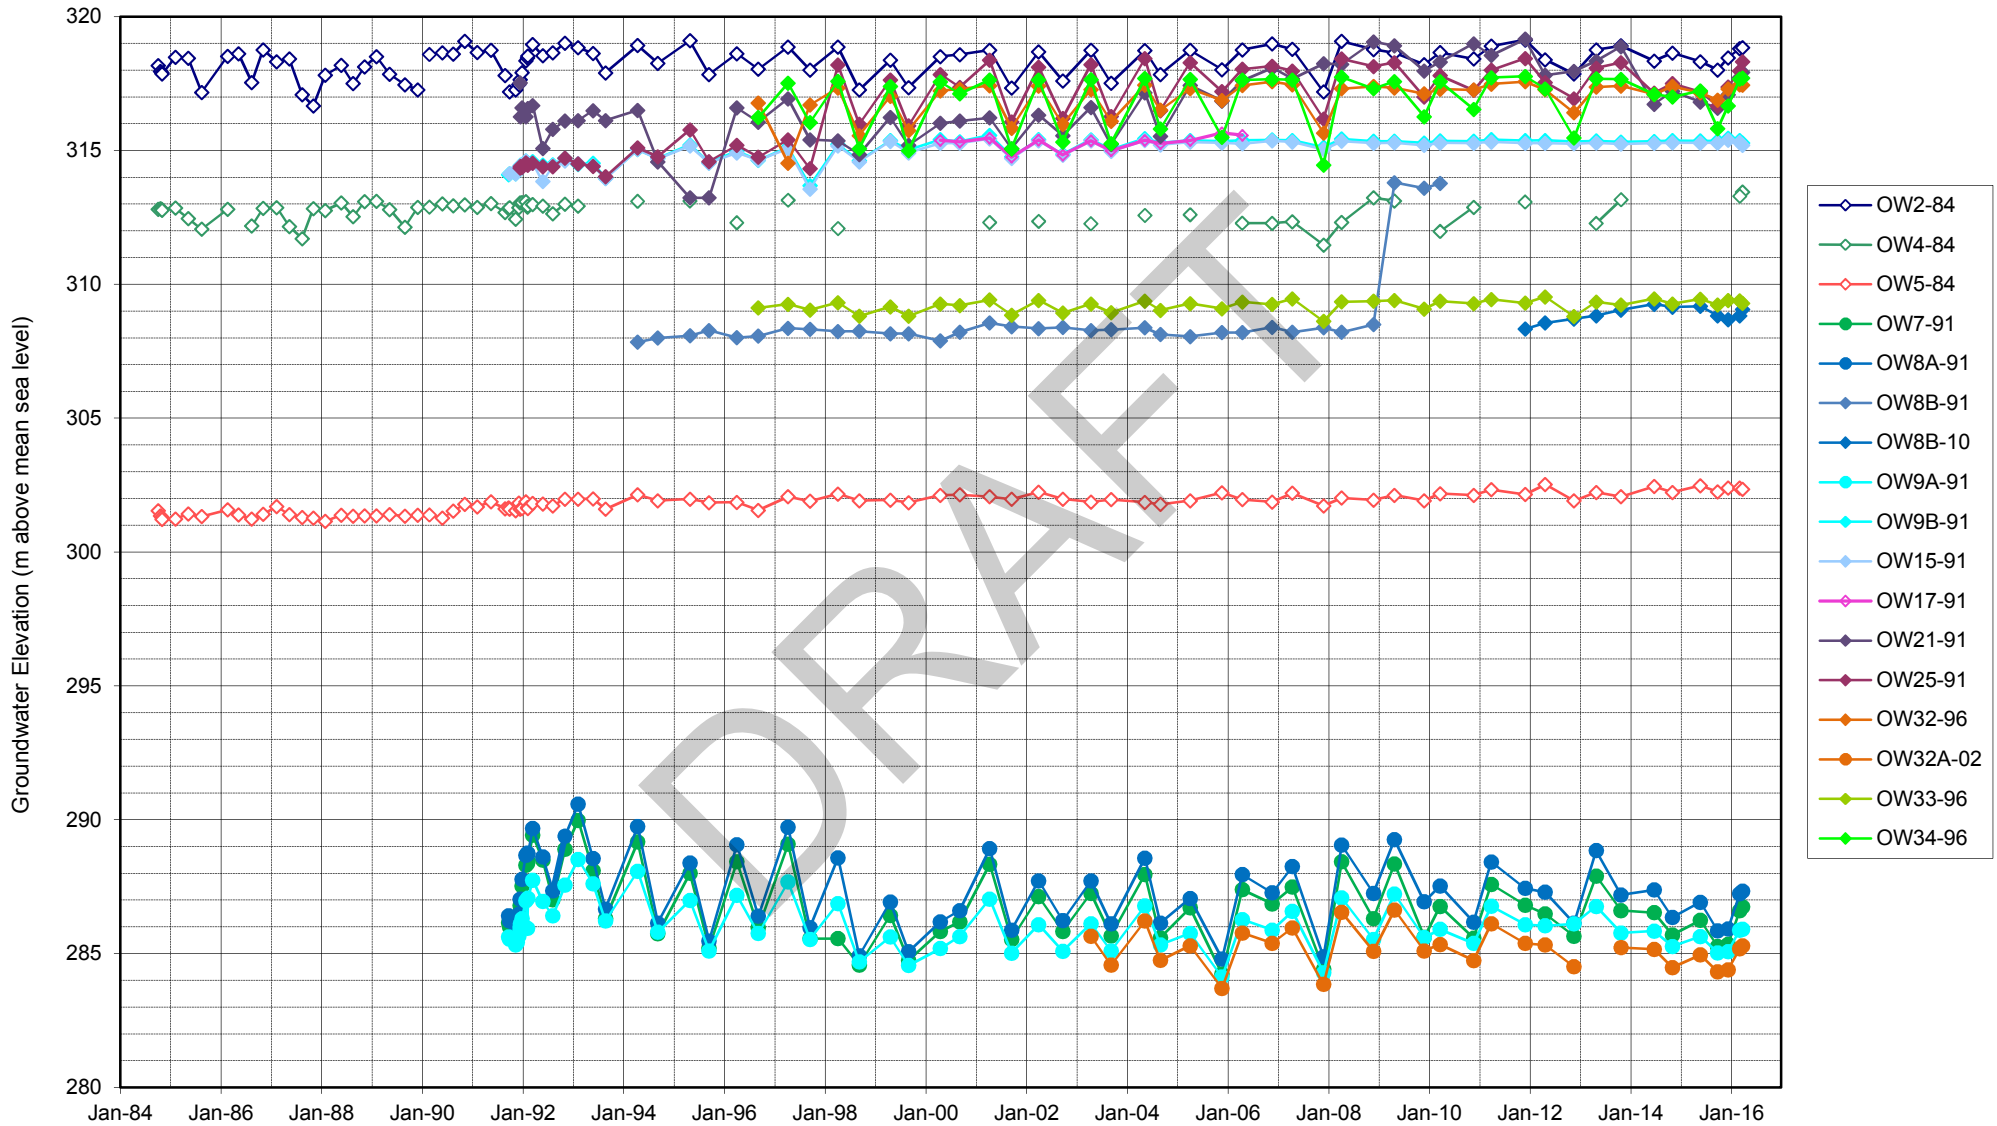**Figure F2.4
Groundwater Hydrograph**





BURNSIDE

[THE DIFFERENCE IS OUR PEOPLE]

Appendix G

Alternative Methods Conceptual Drawings


DRAFT



OBTAINED CAPACITY - 577,000 m³



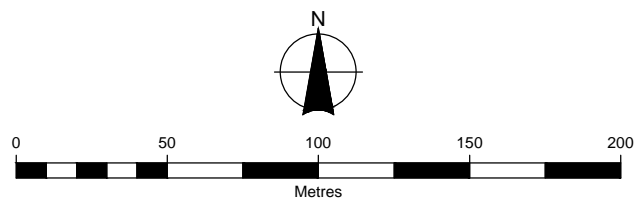Figure Title
SOLID WASTE CAPACITY DEVELOPMENT
 ALTERNATIVE METHOD 1 - VERTICAL EXPANSION



Client
TOWN OF ST. MARYS

Drawn AE	Checked JRH	Date APRIL 2016	Figure No. 1
Scale 1:2500	Project No. 300032339		



OBTAINED CAPACITY - 733,000 m³
 ABOVE GRADE - 403,000 m³
 BELOW GRADE - 330,000 m³

EXPANSION VOLUME IS ATTAINED FROM A 4:1 SIDESLOPE FROM THE EDGE OF WASTE TO m ELEVATION 321 m. FOLLOWED BY A 20:1 GRADE TO THE PEAK AT 323m. COMBINED WITH A 5 m VERTICAL EXCAVATION (CKD PILE EXCLUDED).

MINIMUM MOECC SETBACK FROM PROPERTY BOUNDARY = 30 m
 GUIDELINE SETBACK = 100 m





TOWN OF ST. MARYS

Figure Title
SOLID WASTE CAPACITY DEVELOPMENT

METHOD 2 - HORIZONTAL EXPANSION OF THE EXISTING LANDFILL

Drawn	Checked	Date	Figure No.
AE	JRH	APRIL 2016	2
Scale 1:2500		Project No. 300032339	

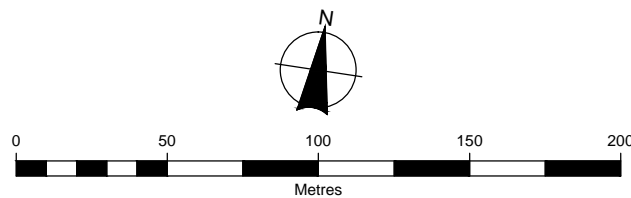


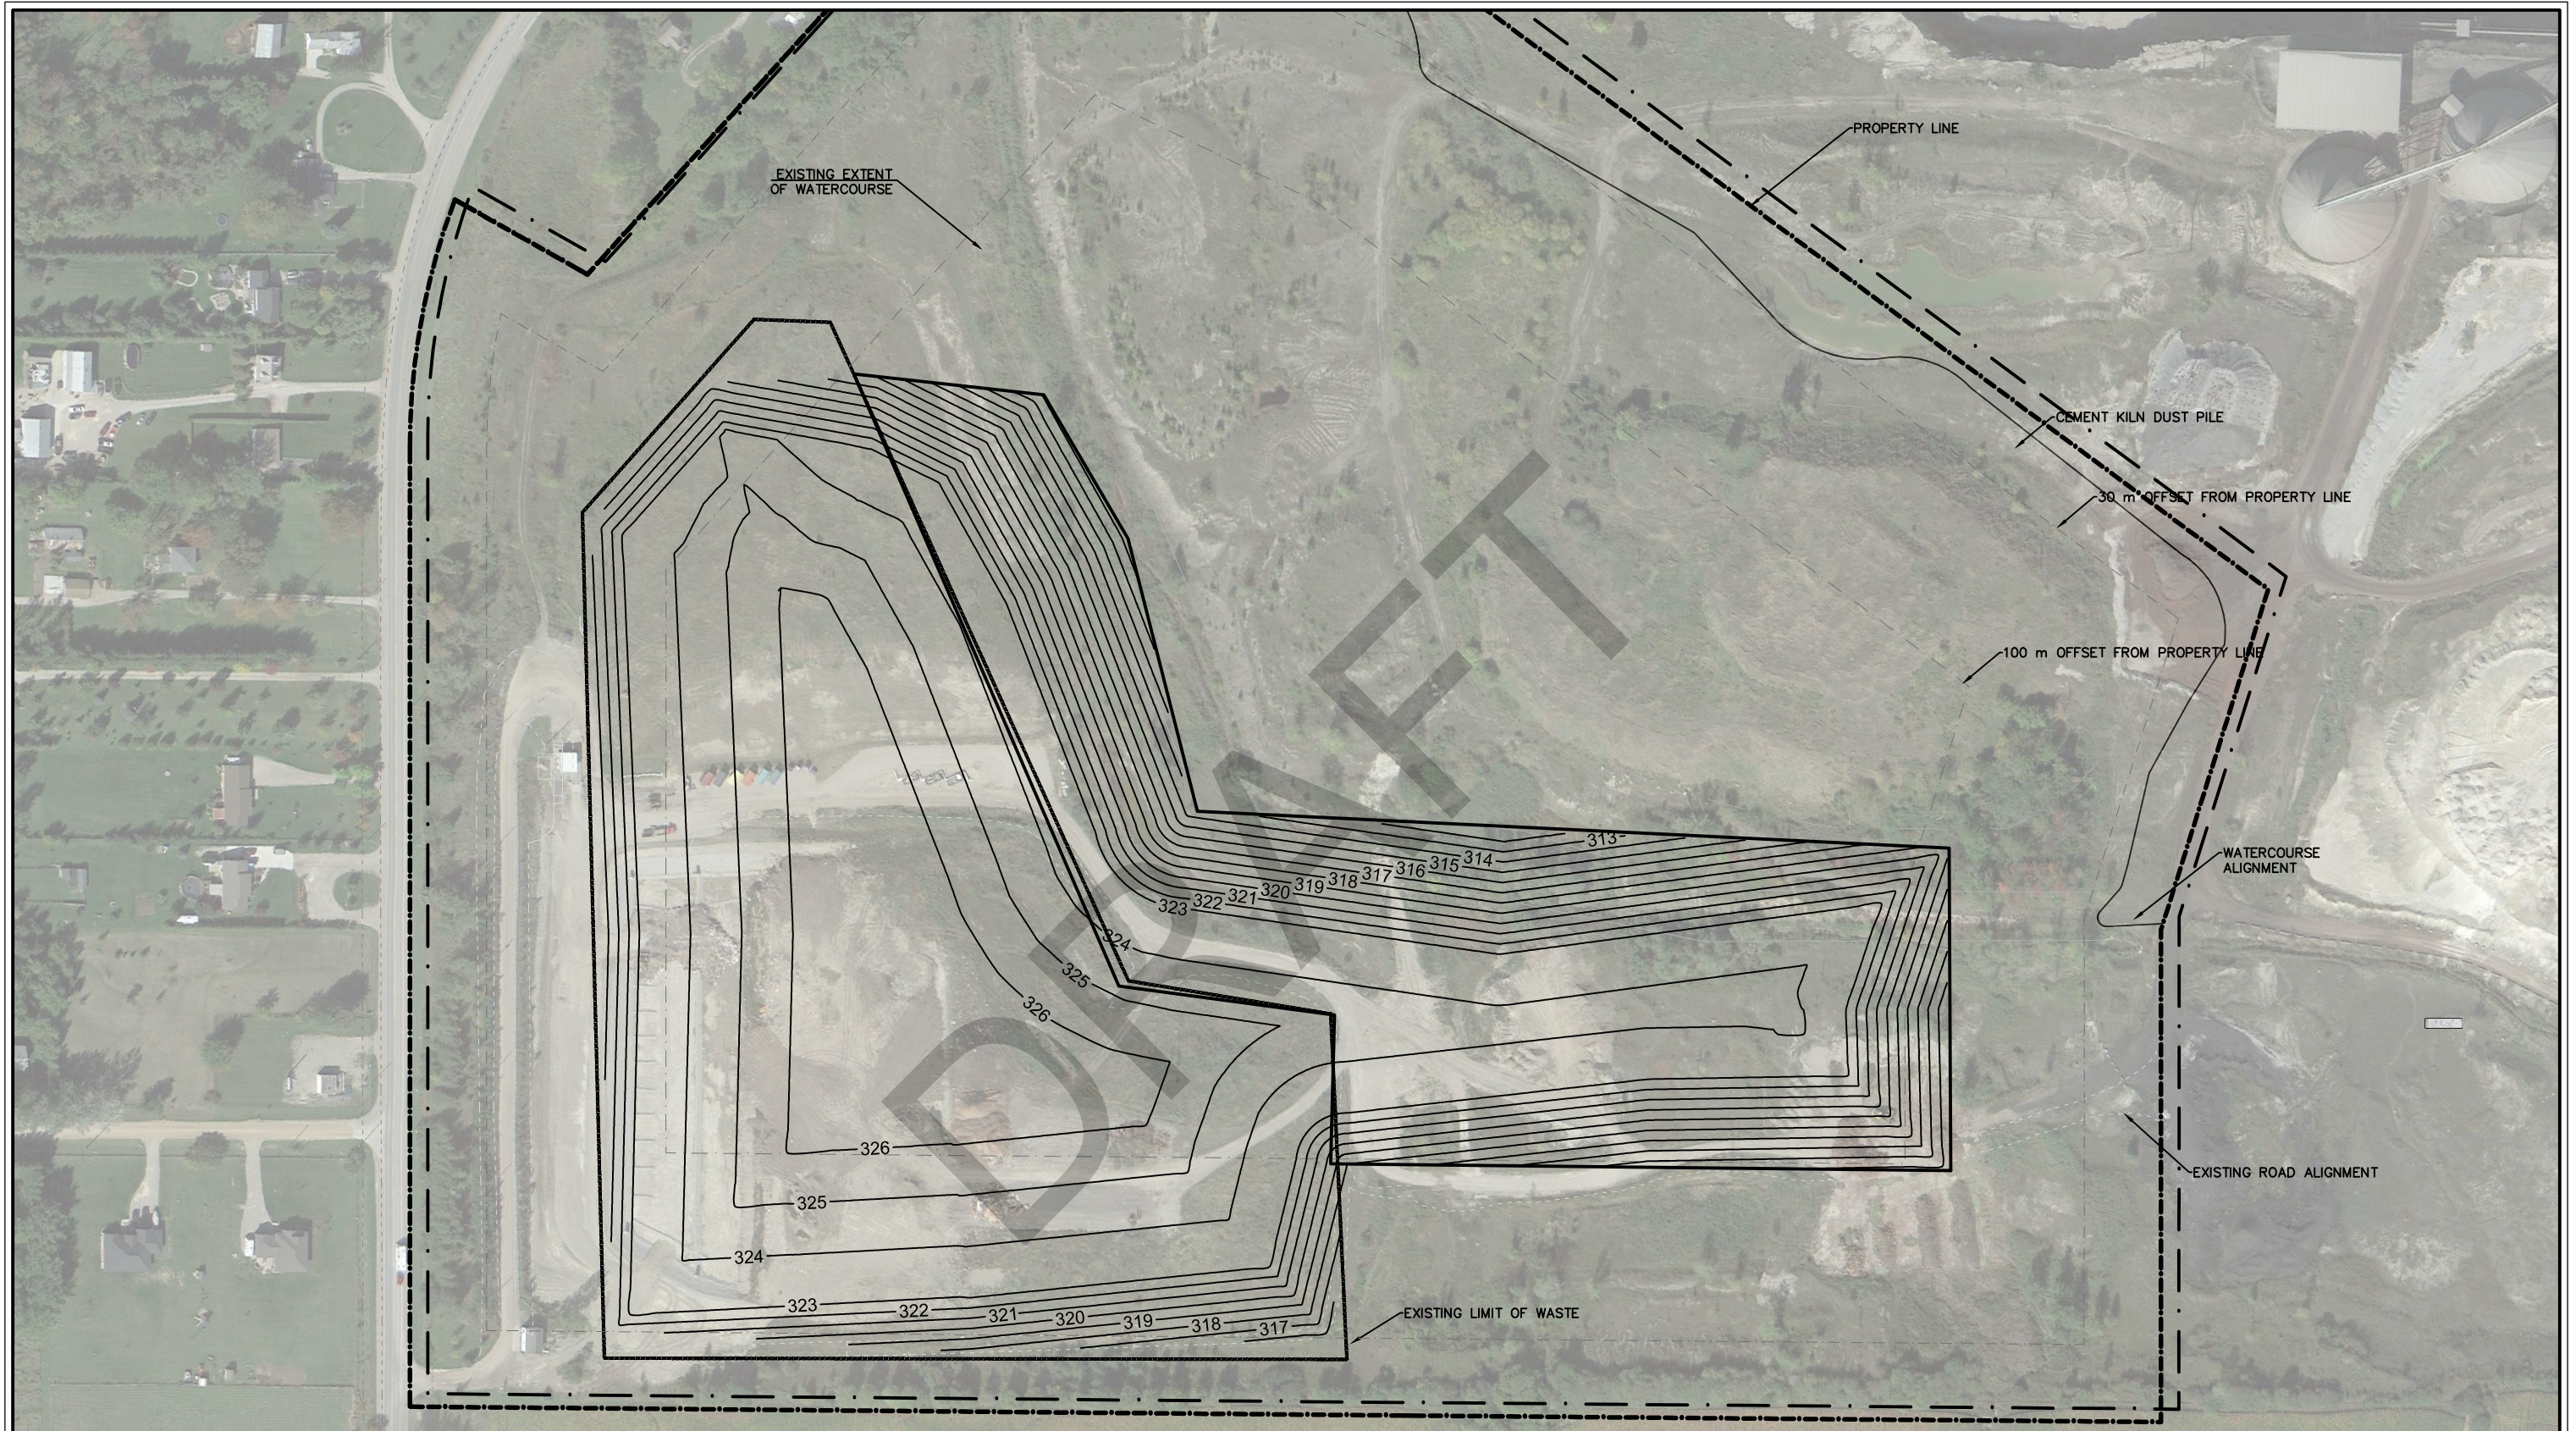

OBTAINED CAPACITY - 756,000 m³
 ABOVE GRADE - 506,000 m³
 BELOW GRADE - 250,000 m³

EXPANSION VOLUME IS ATTAINED FROM A 4:1 SIDESLOPE FROM THE EDGE OF THE WASTE TO ELEVATION OF 323m, FOLLOWED BY A 20:1 SLOPE ON THE PEAK. COMBINED WITH A 5m VERTICAL EXCAVATION (CKD PILE EXCLUDED).

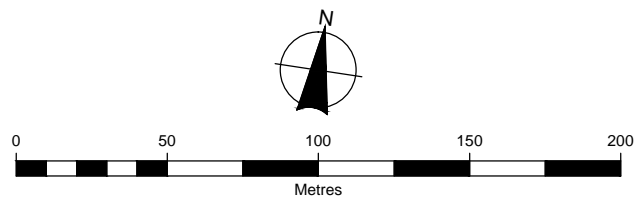MINIMUM MOECC SETBACK FROM PROPERTY BOUNDARY = 30 m
 GUIDELINE SETBACK = 100 m




Client
TOWN OF ST. MARYS

Figure Title
SOLID WASTE CAPACITY DEVELOPMENT

METHOD 3 - COMBINATION OF VERTICAL AND HORIZONTAL EXPANSION

Drawn	Checked	Date	Figure No.
AE	JRH	APRIL 2016	3
Scale 1:2500	Project No. 300032339		

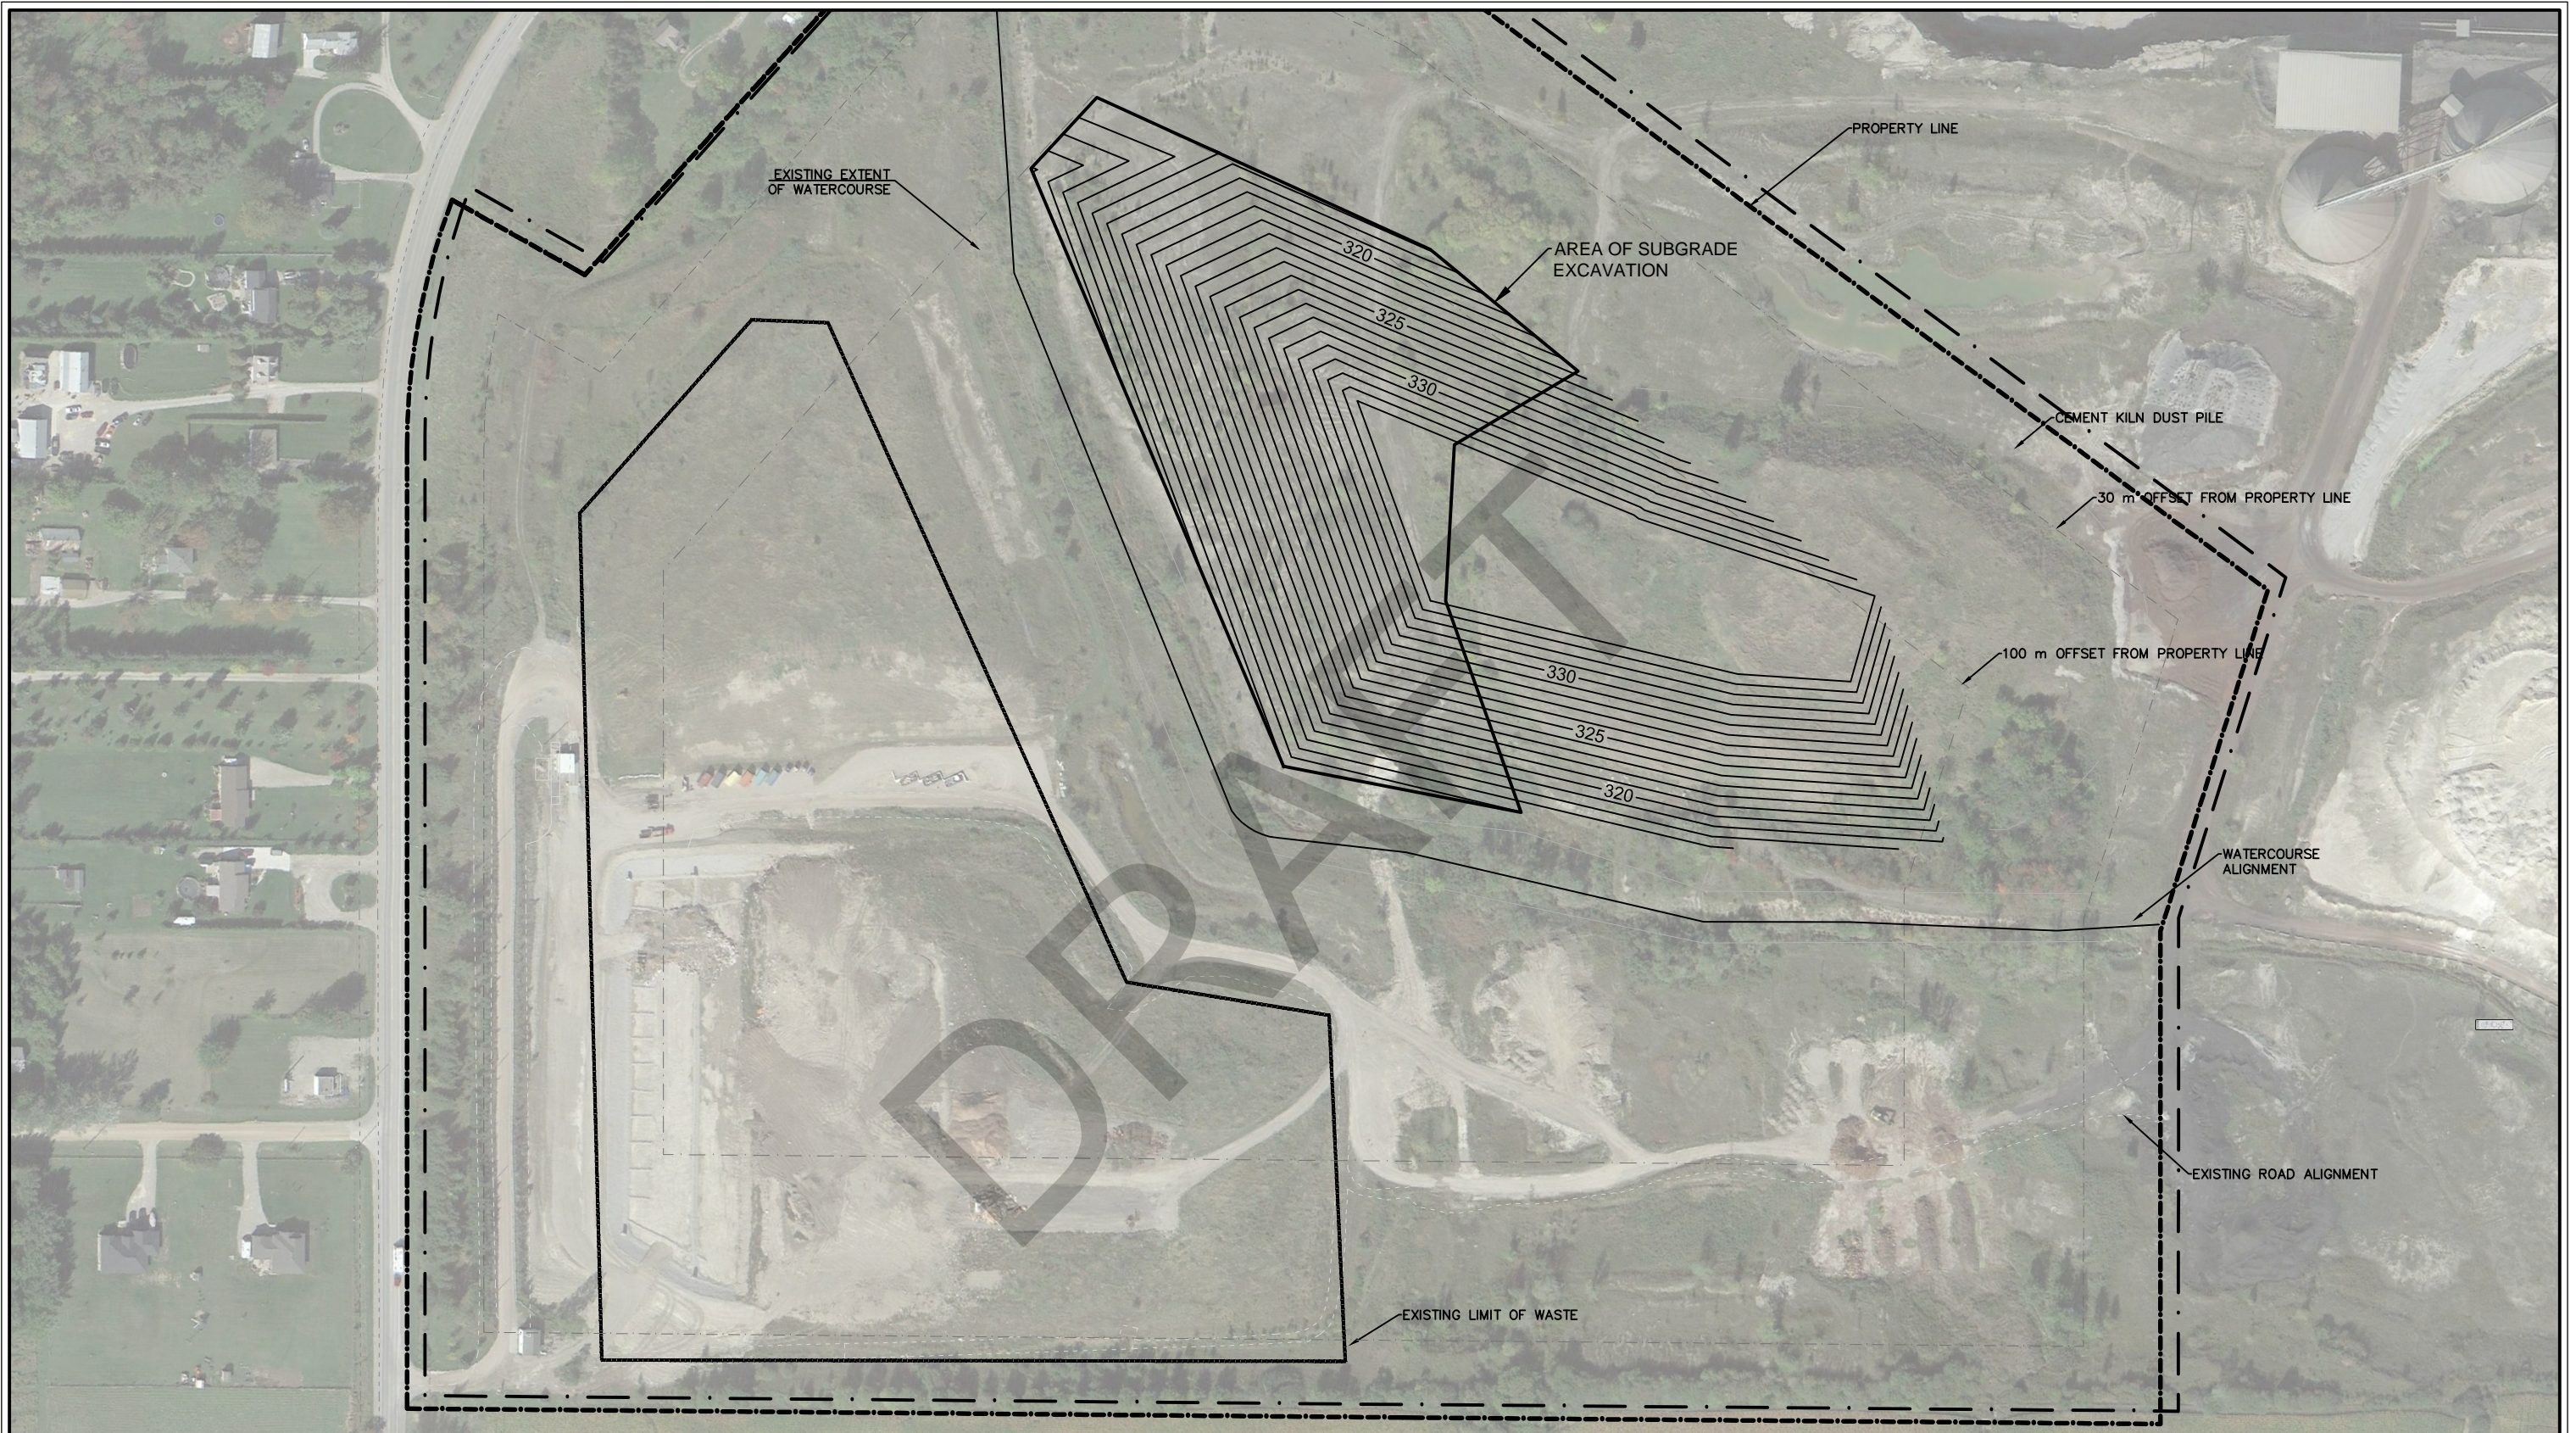


OBTAINED CAPACITY -	397,000 m ³
ABOVE GRADE -	252,000 m ³
BELOW GRADE-	145,000 m ³

EXPANSION VOLUME IS ATTAINED FROM A 4:1 SIDESLOPE FROM THE EDGE OF THE WATERCOURSE BANK TO THE ELEVATION OF THE EXISTING TOPOGRAPHY. COMBINED WITH A 5 m VERTICAL EXCAVATION (CKD PILE EXCLUDED).





Figure Title
SOLID WASTE CAPACITY DEVELOPMENT

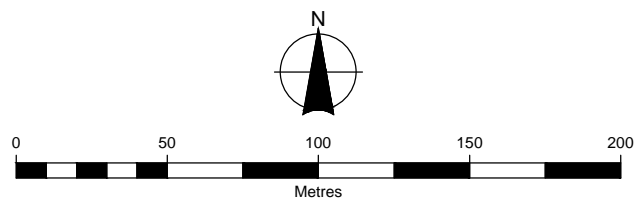**ALTERNATIVE METHOD 4 -
NEW LANDFILL FOOTPRINT**



Client
TOWN OF ST. MARYS

Drawn AE	Checked JRH	Date APRIL 2016	Figure No. 4
Scale 1:2500	Project No. 300032339		

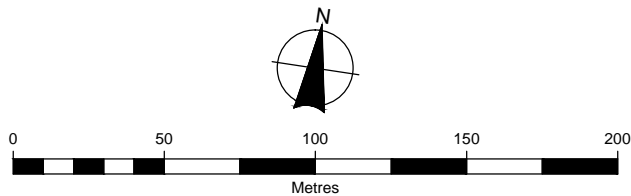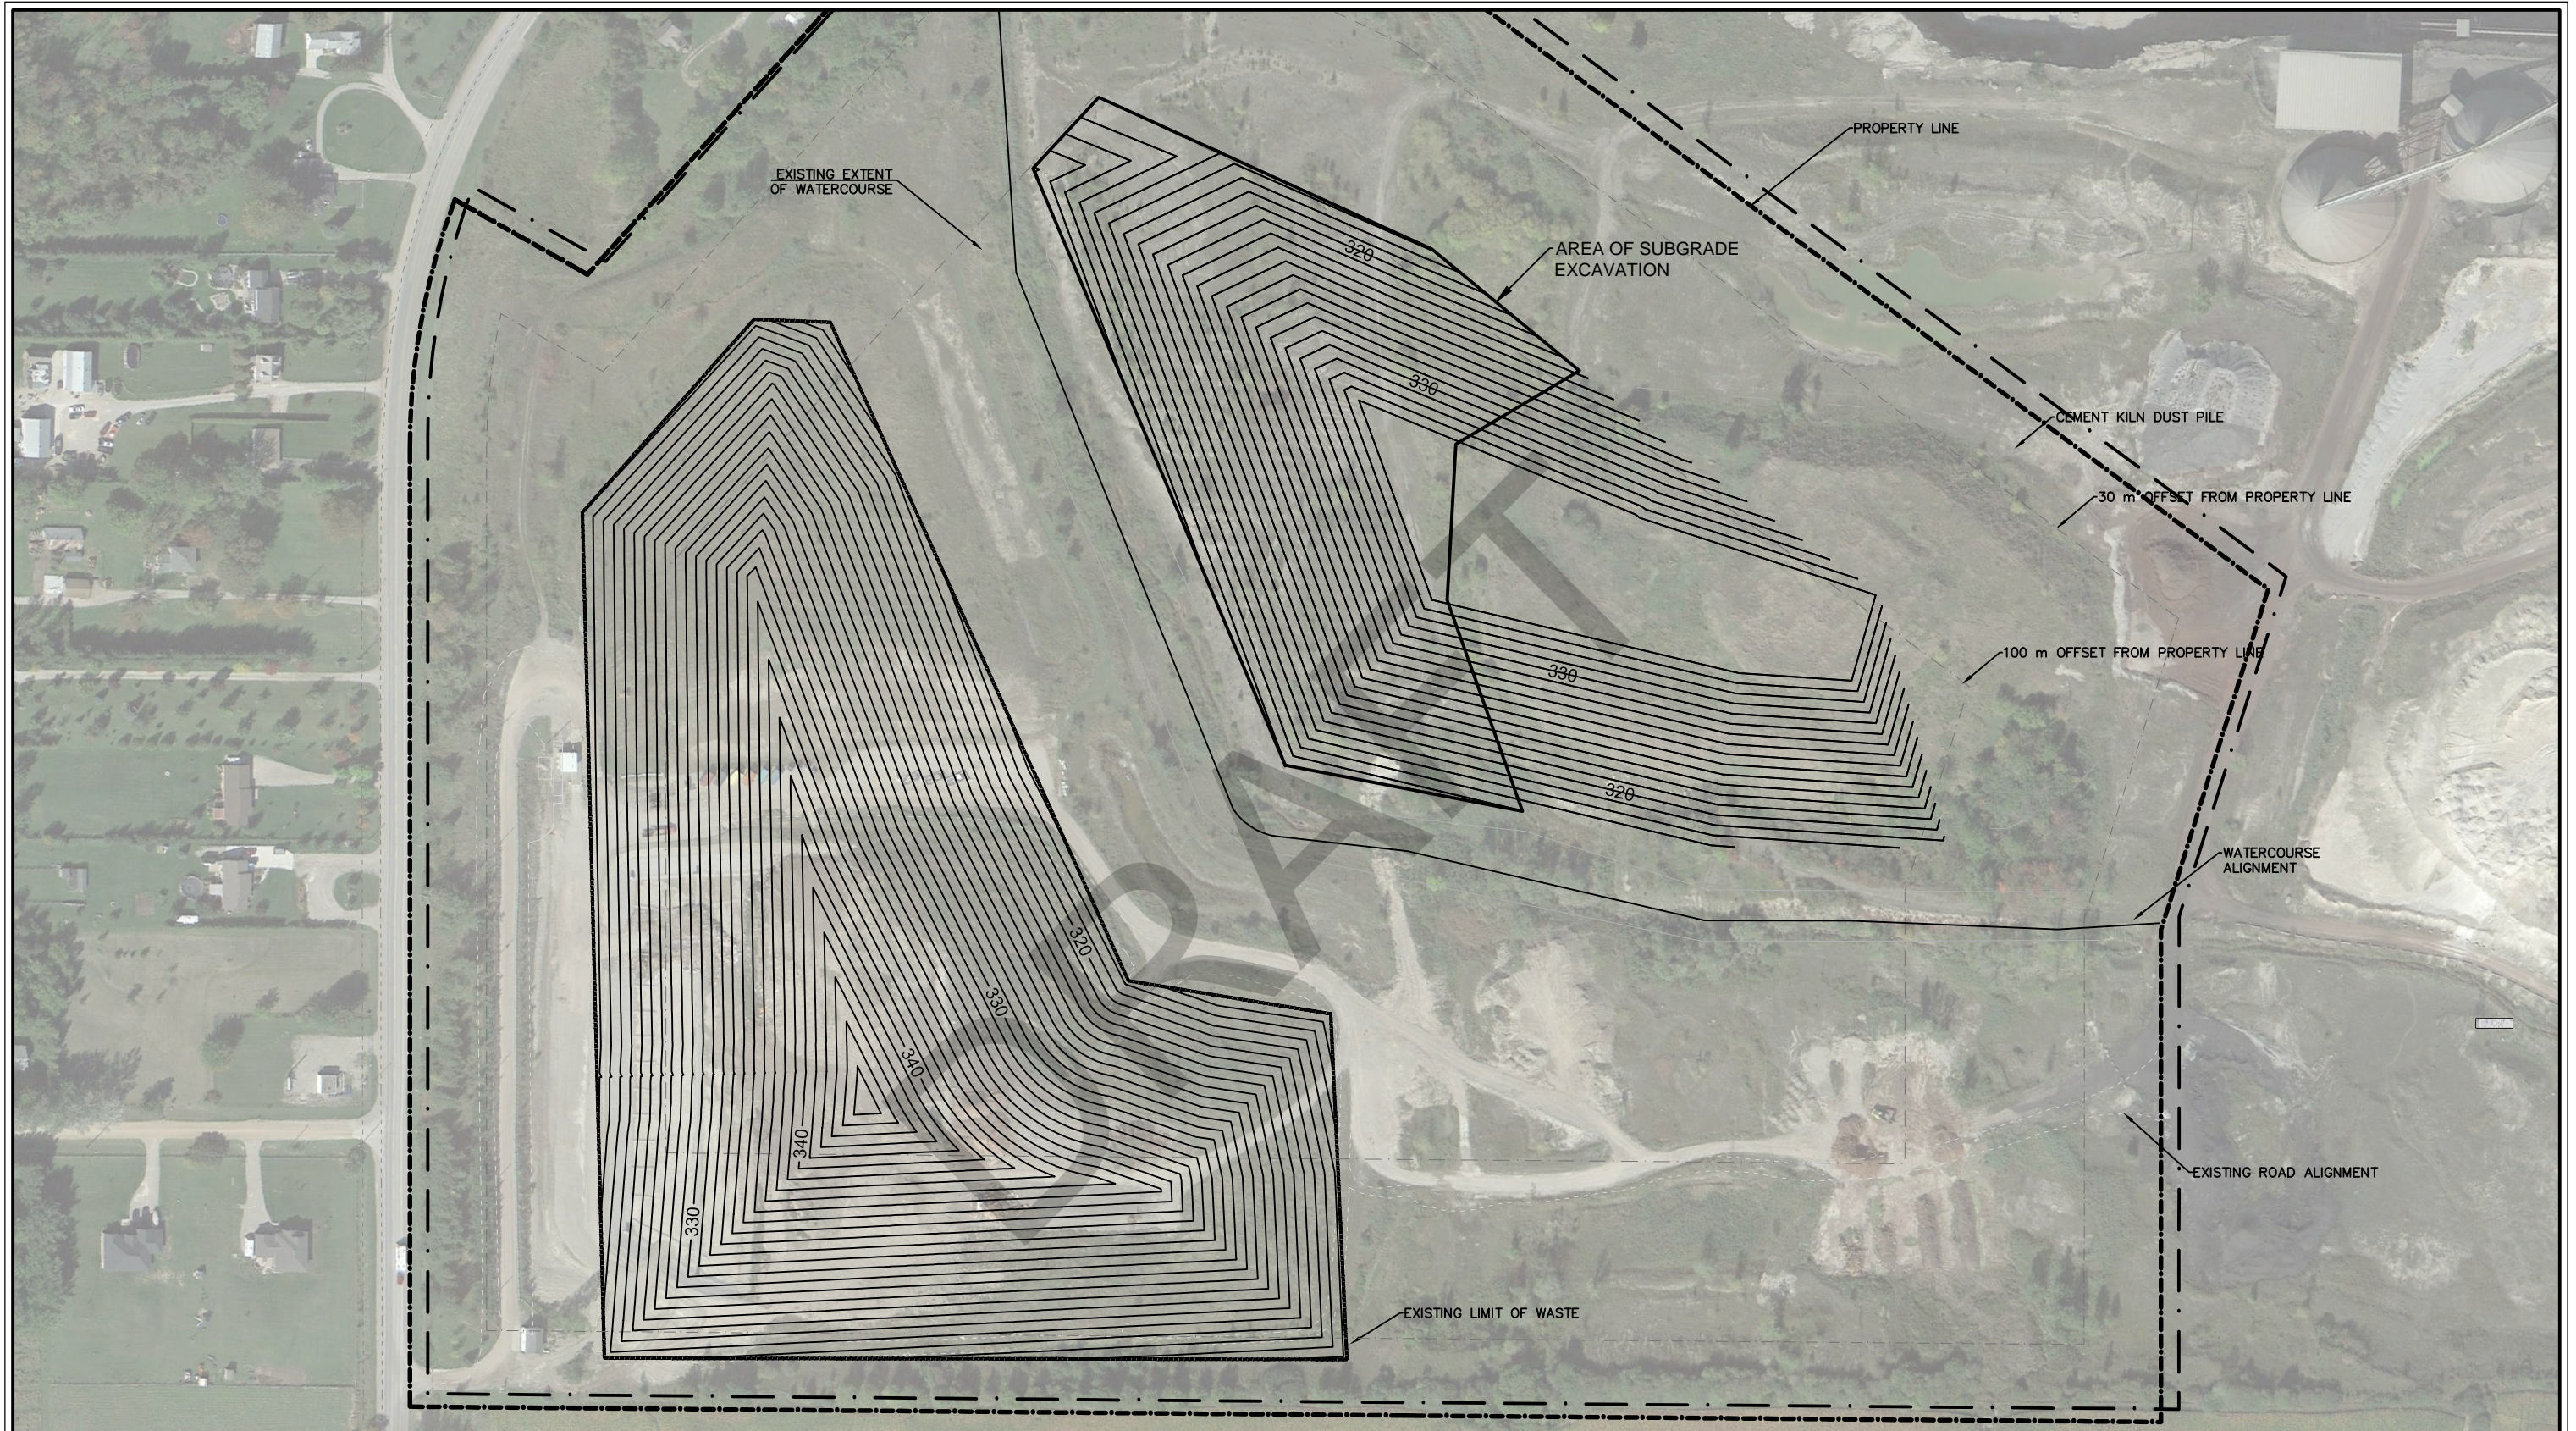

OBTAINED CAPACITY - 974,000 m³
 ABOVE GRADE - 827,000 m³
 BELOW GRADE - 145,000 m³

EXPANSION VOLUME IS ATTAINED FROM A 4:1 SIDESLOPE FROM THE EDGE OF THE WATERCOURSE BANK TO THE ELEVATION OF THE EXISTING TOPOGRAPHY. COMBINED WITH A 5 m VERTICAL EXCAVATION (CKD PILE EXCLUDED). ADDITIONALLY WASTES WILL BE PLACED OVERTOP OF THE EXISTING PHASES.

MINIMUM MOECC SETBACK FROM PROPERTY BOUNDARY = 30 m
 GUIDELINE SETBACK = 100 m



Client

TOWN OF ST. MARYS

Figure Title

SOLID WASTE CAPACITY DEVELOPMENT
 METHOD 5 - COMBINATION OF VERTICAL
 EXPANSION AND SEPARATE DEVELOPMENT OF A
 NEW LANDFILL FOOTPRINT

Drawn

AE

Scale
 1:2500

Checked

JRH

Date

APRIL 2016

Project No.

300032339.0000

Figure No.

5



BURNSIDE

[THE DIFFERENCE IS OUR PEOPLE]

Appendix H

Impacts and Mitigation

Potential Impacts	H1
Groundwater Mitigation Measures and Rankings	H2
Surface Water Mitigation Measures and Rankings	H3

DRAFT

**Table H1
Potential Impacts**

Description of Site Alteration	Leachate Generation	Groundwater		Surface Water	
		Quantity	Quality	Quantity	Quality
Method 1 Vertical Expansion of Existing Landfill (577,000 m3)					
Added height to Phase I and Phase II/III during operation	N1 Increased leachate strength	o	N2 Potential for increased leachate elevation - increased head could drive leachate into sand/silt seam and into till	o	N3 Potential for contaminated runoff from footprint during filling
Added height to Phase I and Phase II/III when closed	P Decreased generation - increased runoff on longer side slopes	o	N2 Potential for increased leachate elevation - increased head could drive leachate into sand/silt seam and into till	N4 Increased runoff from footprint - longer side slopes No change outside footprint	N5 Potential for leachate breakout on final side slope
Filled between Phase I and Phase II/III - increased waste footprint	N6 Increased infiltration into waste	o	N7 Potential for migration of leachate downward into sand/silt seam	o	N8 Potential for contaminated runoff from fill area
Footprint does not encroach on stormwater basins	o	o	P No alterations to stormwater basin with regard to sand/silt seam	P No alterations to stormwater basin location	o
Footprint does not encroach on watercourse	o	o	o	P No alterations to water course location	o
Method 2 Horizontal Expansion of Existing Landfill (733,000 m3)					
Height slightly less than current Phase I and Phase II/III	o	o	o	o	o
Increased waste footprint	N6 Increased infiltration into waste	o	N7 Potential for migration of leachate downward into sand/silt seam	o	N8 Potential for contaminated runoff from fill area
New waste footprint in centre of property - farther from boundary	o	o	P Creates large buffer between fill and property boundary	o	P Creates large buffer between fill and property boundary
Create long narrow depressions between footprint expansion and existing Phases	N9 could cause surface ponding and increased infiltration	o	N2 Potential for increased leachate elevation - increased head could drive leachate into sand/silt seam	P Decreased stormwater runoff	N5 Potential for leachate breakout on final side slope
5 metre excavation	o	N10 Could intersect saturated soil or sand/silt seam	N10 Could intersect saturated soil or sand/silt seam	o	o
Bottom of waste may be closer to bedrock surface	o	o	N11 Shorter travel distance between bottom of waste and bedrock	o	o
Displaces stormwater basins - requires relocation	o	o	N12 Potential for migration of stormwater downward into sand/silt seam	o	o
Displaces watercourse - requires relocation	o	N13 Potential to change flow direction in shallow groundwater	N14 Potential for migration of leachate laterally into sand/silt seam (exposed on bank of watercourse)	N15 Will require alterations of surface water movement to reach new watercourse	P Increase waste to watercourse distance N16 Decrease CKD to watercourse distance

Legend

- o No net impact or neutral when compared to the existing site
- P Positive Impact
- N2 Negative impact - numbered in order in which they appear on table
Follow number to mitigation tables

**Table H1
Potential Impacts**

Description of Site Alteration	Leachate Generation		Groundwater		Surface Water					
			Quantity	Quality	Quantity	Quality				
Method 3 Combination of Vertical and Horizontal Expansion of Existing Landfill (Method 1 and Method 2) (756,000 m3)										
Filled between Phase I and Phase II/III - increased waste footprint	N6	Increased infiltration into waste	o	Potential decreased infiltration (increased runoff) - minor	N7	Potential for migration of leachate downward into sand/silt seam	o	Decreased runoff during filling Increased runoff from finished slopes	N8	Potential for contaminated runoff from fill area
Increased waste footprint but less area than Method 2	N6	Increased infiltration into waste	o	Potential decreased infiltration (increased runoff) - minor	N7	Potential for migration of leachate downward into sand/silt seam	o	Decreased runoff during filling Increased runoff from finished slopes	N8	Potential for contaminated runoff from fill area
New waste footprint in centre of property - farther from boundary	o		o		P	Creates large buffer between fill and property boundary	o		P	Creates large buffer between fill and property boundary
Eliminates long narrow depressions between footprint expansion and existing Phases created by Method 2	o		o		o		o		o	
5 metre excavation	o		N10	Could intersect saturated soil or sand/silt seam	N10	Could intersect saturated soil or sand/silt seam	o		o	
Displaces stormwater basins - requires relocation	o		o		N12	Potential for migration of stormwater downward into sand/silt seam	o		o	
Displaces watercourse - requires relocation	o		N13	Potential to change flow direction in shallow groundwater	N14	Potential for migration of leachate laterally into sand/silt seam (exposed on bank of watercourse)	N15	Will require alterations of surface water movement to reach new watercourse	P	Increase waste to watercourse distance
									N16	Decrease CKD to watercourse distance
Method 4 Development of a New Landfill Footprint (397,000 m3)										
Adds height to currently flat area			N13	Potential to change flow direction in shallow groundwater	N2	Potential for increased leachate elevation - increased head could drive leachate into sand/silt seam	o		N8	Potential for contaminated runoff from fill area
Adds slopes to currently flat area	o		o	Potential decreased infiltration (increased runoff) - minor	o		N17	Increased runoff from western side slopes into watercourse		
Increases waste footprint	N6	Increased infiltration into waste	o	Potential decreased infiltration (increased runoff) - minor	N7	Potential for migration of leachate downward into sand/silt seam	o	Decreased runoff during filling Increased runoff from finished slopes	N8	Potential for contaminated runoff from fill area
New waste footprint closer to eastern property boundary	o		o		N11	Shorter travel distance between bottom of waste and bedrock	o		o	
5 metre excavation	o		N10	Could intersect saturated soil or sand/silt seam	N10	Could intersect saturated soil or sand/silt seam	o		o	
Bottom of waste may be closer to bedrock surface	o		o		N11	Shorter travel distance between bottom of waste and bedrock	o		o	
Footprint does not encroach on stormwater basins	o		o		P	No alterations to stormwater basin with regard to sand/silt seam	P	No alterations to stormwater basin location	o	
Footprint does not encroach on watercourse but is close to top of bank	o		o		P	No alterations to water course with regard to sand/silt seam	N17	Increased runoff from western side slopes into watercourse	N8	Potential for contaminated runoff from fill area
Overlaps part of cement kiln dust stockpile	N18	CKD leachate unknown Combination unknown	N19	Potential to change current mounding in CKD stockpile and change shallow flow direction	o		o		o	

**Table H1
Potential Impacts**

Description of Site Alteration	Leachate Generation	Groundwater		Surface Water	
		Quantity	Quality	Quantity	Quality
Method 5 Vertical Expansion of Existing plus Development of a New Landfill Footprint (Method 1 and Method 4) (974,000 m3)					
Added height to Phase I and Phase II/III during operation	N1 Increased leachate strength	o	N2 Potential for increased leachate elevation - increased head could drive leachate into sand/silt seam and into till	o	N3 Potential for contaminated runoff from footprint during filling
Added height to Phase I and Phase II/III when closed	P Decreased generation - increased runoff on longer side slopes	o	N2 Potential for increased leachate elevation - increased head could drive leachate into sand/silt seam and into till	N4 Increased runoff from footprint - longer side slopes No change outside footprint	N5 Potential for leachate breakout on final side slope
Added height to currently flat area	o	N13 Potential to change flow direction in shallow groundwater	N2 Potential for increased leachate elevation - increased head could drive leachate into sand/silt seam	o	N8 Potential for contaminated runoff from fill area
Added slopes to currently flat area	o	o Potential decreased infiltration (increased runoff) - minor	o	N17 Increased runoff from western side slopes into watercourse	o
Increased waste footprint	N6 Increased infiltration into waste	o Potential decreased infiltration (increased runoff) - minor	N7 Potential for migration of leachate downward into sand/silt seam	o Decreased runoff during filling Increased runoff from finished slopes	N8 Potential for contaminated runoff from fill area
Filled between Phase I and Phase II/III - increases waste footprint	N6 Increased infiltration into waste	o Potential decreased infiltration (increased runoff) - minor	N7 Potential for migration of leachate downward into sand/silt seam	o Decreased runoff during filling Increased runoff from finished slopes	N8 Potential for contaminated runoff from fill area
New waste footprint closer to eastern property boundary	o	o	N11 Shorter travel distance between bottom of waste and bedrock	o	o
5 metre excavation east of watercourse	o	N10 Could intersect saturated soil or sand/silt seam	N10 Could intersect saturated soil or sand/silt seam	o	o
Bottom of waste may be closer to bedrock surface	o	o	N11 Shorter travel distance between bottom of waste and bedrock	o	o
Footprint does not encroach on stormwater basins	o	o	P No alterations to stormwater basin with regard to sand/silt seam	P No alterations to stormwater basin location	o
Footprint does not encroach on watercourse but is close to top of bank	o	o	P No alterations to water course with regard to sand/silt seam	N17 Increased runoff from western side slopes into watercourse	N8 Potential for contaminated runoff from fill area
Overlaps part of cement kiln dust stockpile	N18 CKD leachate unknown Combination unknown	N19 Potential to change current mounding in CKD stockpile and change shallow flow direction	o	o	o

Legend

- o No net impact or neutral when compared to the existing site
- P Positive Impact
- N2 Negative impact - numbered in order in which they appear on table
Follow number to mitigation tables

Table H2
Groundwater Mitigation Measures and Ranking

Impact No	Alternative Methods					Impact	Site Alteration Leading to Impact	Impacted Feature	Possible Mitigation
	1	2	3	4	5				
N1	●				●	Increased leachate strength	Added height to Phase I and Phase II/III	Leachate	<ul style="list-style-type: none"> Monitor leachate quality and quantity in leachate collection system Review capacity of sewage treatment plant
N2	○				○	Potential for increased leachate elevation - increased head could drive leachate into sand/silt seam	Added height to Phase I and Phase II/III	GW	<ul style="list-style-type: none"> Monitor flow rate from leachate collection system Leachate head control by enhanced or modified leachate collection system
		●					Create long narrow depressions between footprint expansion and existing Phases	Leachate	<ul style="list-style-type: none"> Design stormwater control between existing and expansion footprints for operation and closed stages to prevent ponding and infiltration into waste
				●	●		Added height to currently flat area	GW	<ul style="list-style-type: none"> Map presence and remove sand/silt seams Install a leachate collection system of similar design to current system
N6	●		●		●	Increased infiltration into waste (increased leachate generation)	Filled between Phase I and Phase II/III - increased waste footprint	Leachate	<ul style="list-style-type: none"> Design and operations to reduce work area & interim cover to promote clean runoff Evaluate leachate generation potential against sewage treatment plant capacity
		●	●	●	●		Increased footprint area	Leachate	<ul style="list-style-type: none"> Design and operations to reduce work area & interim cover to promote clean runoff Evaluate leachate generation potential against sewage treatment plant capacity
N7	●		●		●	Potential for migration of leachate downward into sand/silt seam	Filled between Phase I and Phase II/III - increased waste footprint	GW	<ul style="list-style-type: none"> Map presence and remove sand/silt seams Extend leachate collection system between Phase I and Phase II/III
		●	●	●	●		Increased footprint area	GW	<ul style="list-style-type: none"> Map presence and remove sand/silt seams Install a leachate collection system of similar design to current system
N9		●				Could cause surface ponding and increased infiltration	Create long narrow depressions between footprint expansion and existing Phases	Leachate	<ul style="list-style-type: none"> Design stormwater control between existing and expansion footprints for to prevent ponding and infiltration into waste
N10		○	○	○	○	Could intersect saturated soil or sand/silt seam	5 metre excavation	GW	<ul style="list-style-type: none"> Map presence and remove sand/silt seam Map depth to water table and maintain landfill base above water table Liner designed to separate groundwater in the seam from the waste Induce groundwater from sand/silt seam toward leachate collection system
N11		○		○	○	Reduced separation distance between bottom of waste and bedrock	Bottom of waste may be closer to bedrock surface	GW	<ul style="list-style-type: none"> Confirm depth to bedrock and soil characteristic between waste and bedrock Enhance leachate collection system (e.g. liner)
				○	○		New waste footprint closer to eastern property boundary	GW	<ul style="list-style-type: none"> Confirm depth to bedrock and soil characteristic between waste and bedrock Confirm groundwater flow direction in bedrock at northeast corner Enhance leachate collection system (e.g. liner)
N12		●	●			Potential for migration of stormwater downward into sand/silt seam	Displaces stormwater basins - requires relocation	GW	<ul style="list-style-type: none"> Determine presence and depth of sand/silt seam in new basin location Remove seam or maintain separation distance from basin bottom to seam
N13		○	○			Potential to change flow direction in shallow groundwater	Displaces watercourse - requires relocation	GW	<ul style="list-style-type: none"> Create conceptual model of new flow direction Design leachate collection system to induce flow from CKD stockpile toward former watercourse location
				●	●		Added height to currently flat area	GW	<ul style="list-style-type: none"> Create conceptual model of new flow direction Install a leachate collection system of similar design to current system

Table H2
Groundwater Mitigation Measures and Ranking

Impact No	Alternative Methods					Impact	Site Alteration Leading to Impact	Impacted Feature	Possible Mitigation
	1	2	3	4	5				
N14		○	○			Potential for migration of leachate laterally into sand/silt seam (exposed on bank of watercourse)	Displaces watercourse - requires relocation	GW	<ul style="list-style-type: none"> Map presence and remove sand/silt seams Design leachate collection system to induce flow toward former watercourse location
N18				◐	◑	CKD leachate unknown Combination unknown	Overlaps part of cement kiln dust stockpile	Leachate	<ul style="list-style-type: none"> Monitoring samples from wells in CKD
N19				◐	◑	Potential to change current mounding in CKD stockpile and change shallow flow direction	Overlaps part of cement kiln dust stockpile	GW	<ul style="list-style-type: none"> Monitor water levels in wells in CKD

Negative Impacts for Each Method

	1	2	3	4	5
◑	1	-	-	2	3
◐	1	4	3	1	2
◒	1	1	2	3	4
○	1	4	3	3	4

Legend

- ◑ Minor Impact - monitoring with potential mitigation (e.g. monitoring of groundwater around CKD stockpile)
- ◐ Low Impact - feature alteration with monitoring (e.g. stormwater controls)
- ◒ Medium Impact - enhanced engineering with monitoring (e.g. extension of current leachate control system)
- Major Impact - major mitigation engineering required (e.g. liner, redesigned leachate control system)

Positive Impacts	2	1	1	2	3
------------------	---	---	---	---	---

Overall Impact Ranking

Least	█				
↓			█	█	
↓		█			
Most					█

DRAFT

Table H3
Surface Water Mitigation Measures and Ranking

Impact No	Alternative Methods					Impact	Site Alteration Leading to Impact	Impacted Feature	Possible Mitigation
	1	2	3	4	5				
N3	●				●	Potential for contaminated runoff from footprint during filling	Added height to Phase I and Phase II/III	SW	<ul style="list-style-type: none"> Storm water diversion and sedimentation control away from fill area Leachate containment within footprint to LCS
N4	●				●	Increased runoff from footprint - longer side slopes	Added height to Phase I and Phase II/III	SW	<ul style="list-style-type: none"> Design storm water and erosion control for side slopes and toe
N5	○				○	Potential for leachate breakout on final side slopes	Added height to Phase I and Phase II/III	SW	<ul style="list-style-type: none"> Leachate head control by enhanced or modified leachate collection system
		●					Create long narrow depressions between footprint expansion and existing Phases	SW	<ul style="list-style-type: none"> Design stormwater control between existing and expansion footprints for closed stage to prevent ponding and infiltration into waste
N8	●		●		●	Potential for contaminated runoff from fill area	Filled between Phase I and Phase II/III - increased waste footprint	SW	<ul style="list-style-type: none"> Design and operations to reduce work area & interim cover to promote clean runoff
		●	●	●	●		Increased footprint area	SW	<ul style="list-style-type: none"> Design and operations to reduce work area & interim cover to promote clean runoff
				●	●		Added height to currently flat area	SW	<ul style="list-style-type: none"> Create soil berm along watercourse to contain water within waste area
				●	●		Footprint does not encroach on watercourse but is close to top of bank	SW	<ul style="list-style-type: none"> Create soil berm along watercourse to contain water within waste area
N15		●	●			Will require alterations of surface water movement to reach new watercourse	Displaces watercourse - requires relocation	SW	<ul style="list-style-type: none"> Grading, storm water and erosion control to redirect, slow or hold runoff
N16		●	●			Decrease CKD to watercourse distance	Displaces watercourse - requires relocation	SW	<ul style="list-style-type: none"> Monitoring samples from wells in CKD and new watercourse
N17				●	●	Increased runoff from western side slopes into watercourse	Added slopes to currently flat area	SW	<ul style="list-style-type: none"> Create vegetated water control buffer strip between landfill toe and watercourse
				●	●		Footprint does not encroach on watercourse but is close to top of bank	SW	<ul style="list-style-type: none"> Create vegetated water control buffer strip between landfill toe and watercourse

Negative Impacts for Each Method

	1	2	3	4	5
●	-	1	1	-	-
●	3	3	3	5	8
●	-	-	-	-	-
○	1	-	-	-	1

Legend

- Minor Impact - monitoring with potential mitigation (e.g. monitoring of groundwater around CKD stockpile)
- Low Impact - feature alteration with monitoring (e.g. stormwater controls)
- Medium Impact - enhanced engineering with monitoring (e.g. extension of current leachate control system)
- Major Impact - major mitigation engineering required (e.g. liner, redesigned leachate control system)

Positive Impacts	2	3	2	1	1
------------------	---	---	---	---	---

Overall Impact Ranking

